

THREE CABLE GUARD RAIL WITH STEEL POSTS  
 STONE FILL (HEAVY TYPE)  
 UNCLASSIFIED CHANNEL EXCAVATION  
 CONSTRUCT DRIVE  
 12" BLANKET OF GRAVEL BACKFILL


REV CURVE DATA  
 Δ 37° 47' 15" L  
 D 2° 30'  
 T 2291.83  
 L 1511.50  
 E 130.53  
 Bank 1' per ft

159+12.18 V.C.P.  
 Extend w/ New 4" 12" V.C.P.  
 New 10" 50" R.C.D. (Class 22)  
 160+30  
 w/ R.C.D. with Cover

175+50  
 New 10" 70" R.C.D. (Class 22)

176+89.41 V.C.P.  
 Extend w/ New 4" 12" V.C.P.  
 New 10" 50" R.C.D. (Class 22)

Plan Pt 180+99.15  
 180+41.83

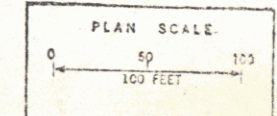

BRATTLEBORO-DUMMERSTON  
 Project S N 8 G1511  
 Sheet 5A of 183 Sheets