

GRANITE CURB
L_T 253+30-254+80
R_T

THREE CABLE GUARD RAIL
WITH STEEL POSTS
L_T 240+00-256+00
R_T

STONE FILL
(HEAVY TYPE)
L_T 240+00-256+00
R_T

UNCLASSIFIED CHANNEL
EXCAVATION
L_T 240+00-256+00
R_T


12 BLANKET OF GRAVEL
BACKFILL
L_T 254+25-256+00
R_T 240+00-241+25
245+25-249+75

CONSTRUCT APPROACH
L_T 244+75
R_T

CONSTRUCT DRIVE
L_T 240+81
243+10
251+72-253+50
R_T

REMOVAL AND DISPOSAL
OF PRESENT GUARD RAIL
L_T 253+27-255+50
R_T

3480' (3520')
WEST RIVER

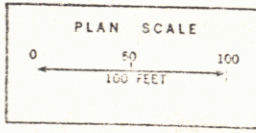

BRATTLEBORO-DUMMERSTON
Project S N₂ 019/11
Sheet 69A of 135 Sheets