


CONSTRUCT APPROACH LT 313+25 RT 31
 CONSTRUCT SPECIAL DITCH (to be paid for under item 103-A-1) LT 319+00-319+75 RT 2+
 DEMOLITION AND DISPOSAL OF BUILDING LT 313+75(*1) RT 314+25(*2) LT 319+75(*3)
 DRILLING AND BLASTING OF SOLID ROCK SUBGRADE 305+00-309+75 LT 312+75-314+54
 THREE CABLE GUARD RAIL WITH STEEL POSTS LT 304+00-316+84
 UNCLASSIFIED CHANNEL EXCAVATION LT 304+00-315+75
 STONE FILL FOR SLOPE PROTECTION (Heavy Type) LT 304+00-315+75 RT 2+
 EXCAVATION AND REMOVAL OF ROAD SURFACES AND/OR PAVEMENTS LT 311+50-313+15 RT 1+
 ROCK FILL LT 304+00-311+75 RT 2+



REV CURVE DATA
 $\Delta 18^{\circ}40'32''$ RT
 $D 2,183.47'$
 $R 2610.1$
 $T 430.5$
 $L 853.4$
 $E 35.2$
 Bank 1/2" in 12"

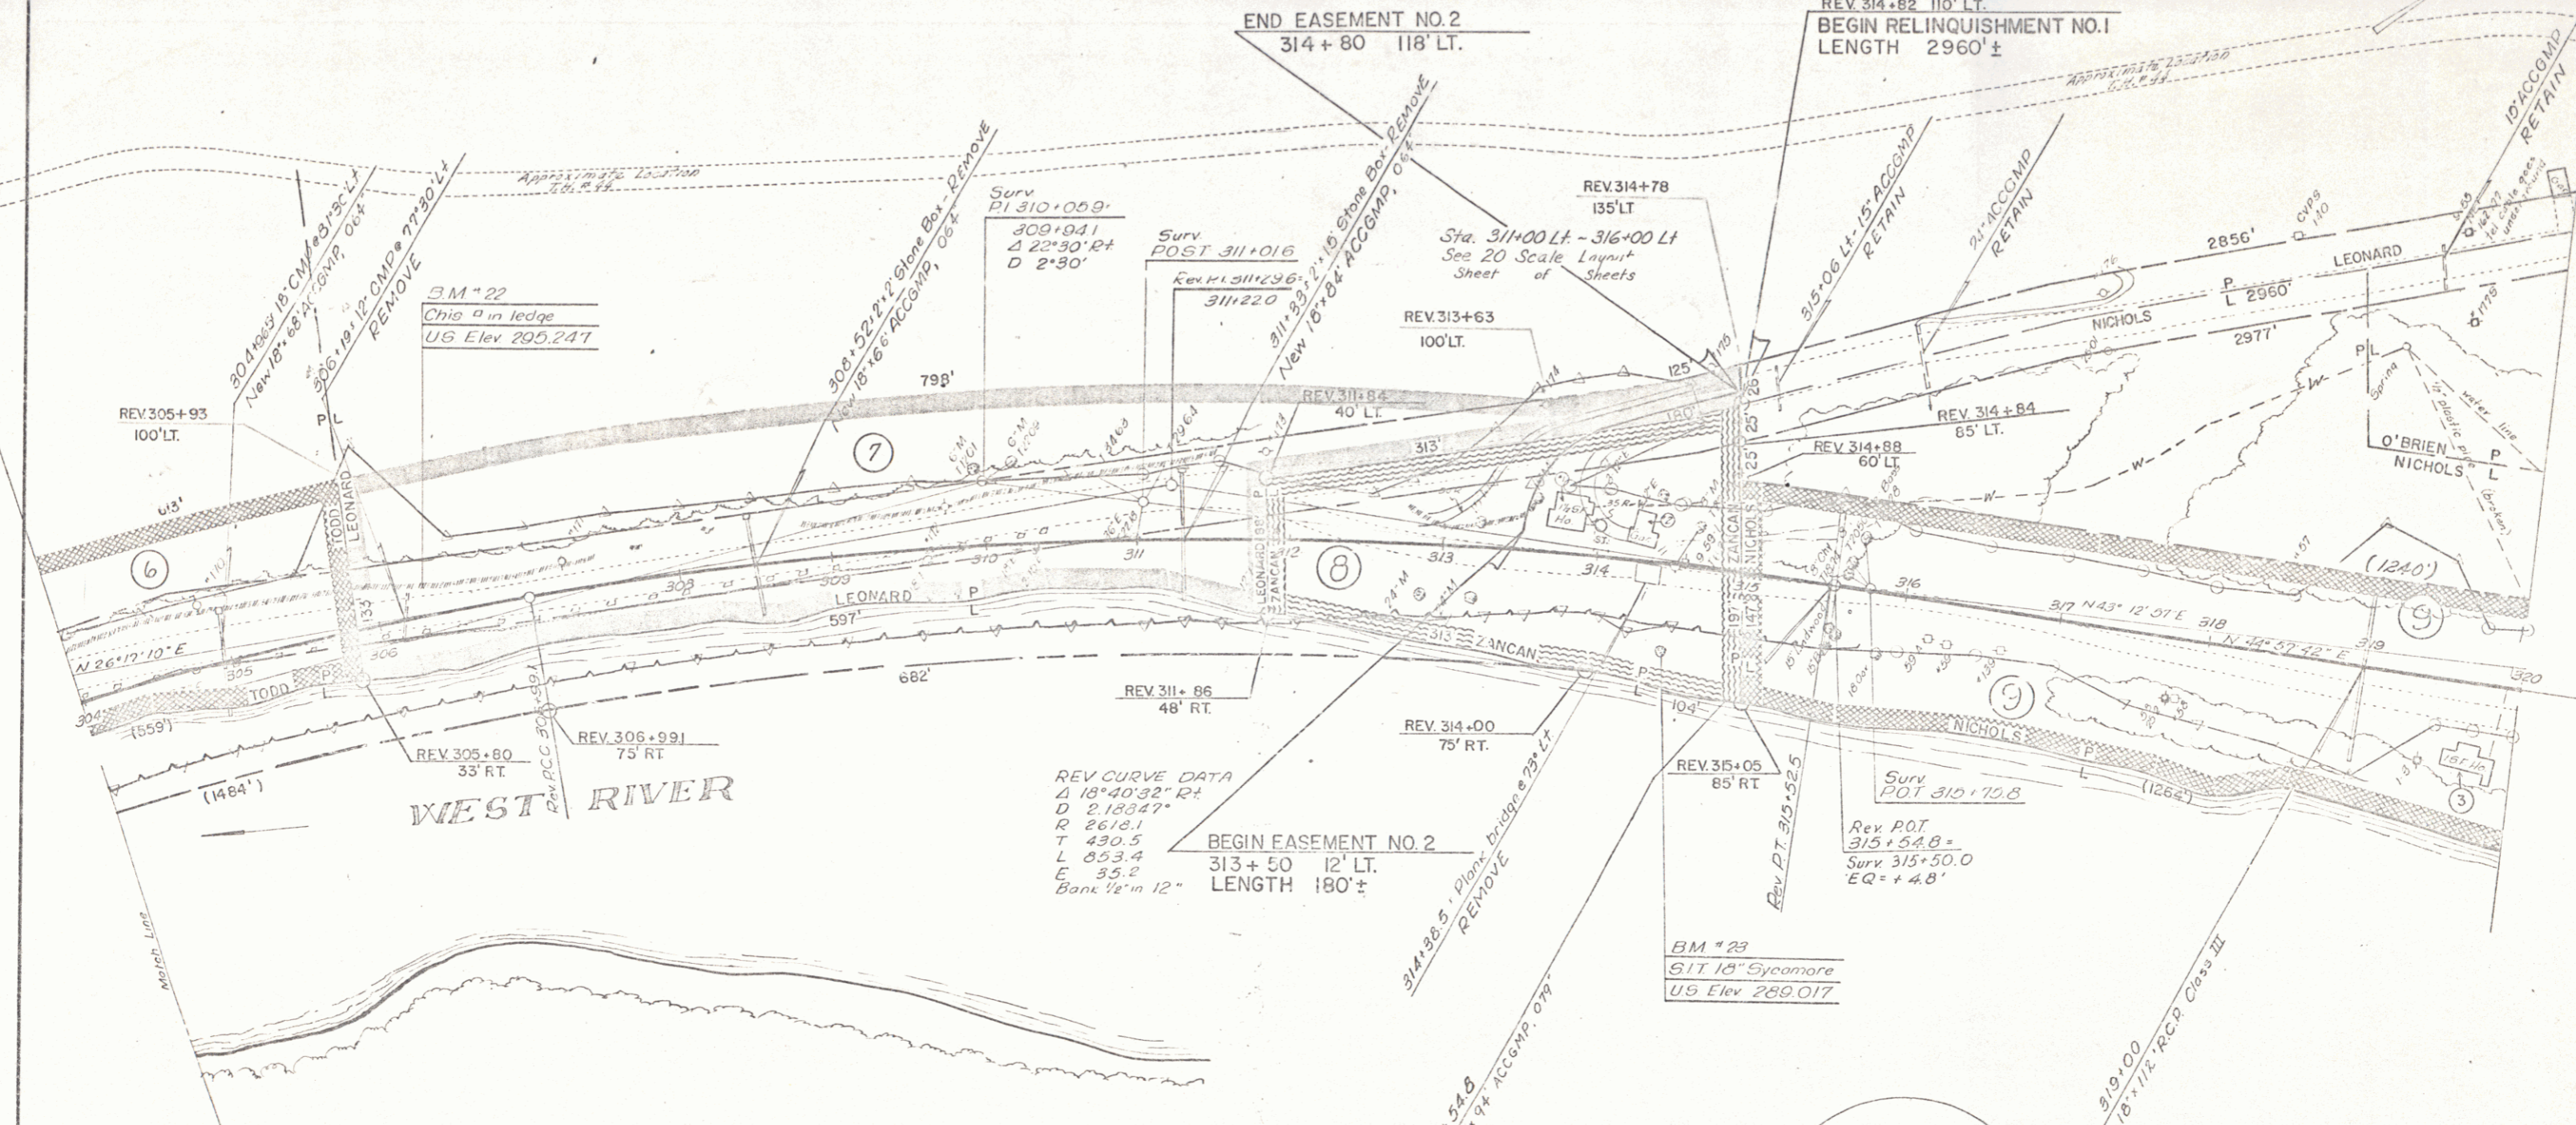