


DRILLING AND BLASTING OF SOLID ROCK SUBGRADE  
336+90 - 337+60

SP202  
State of Vermont Dept of Highways  
to Dept of Fish & Game  
By Executive Order 6-14-74 BK.43  
Pg.279 Town of Dummerston land records.

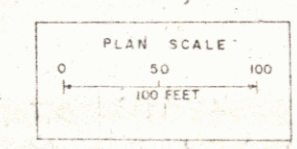

SURVEYED BY Jewett DATE Sept 1964  
DRAWN BY DHB & WAL DATE Nov 1964  
TRACED BY Loufman DATE Dec 1964  
**DUMMERSTON**  
PROJ. S. NO. 011912  
SHEET 21 OF 44

STEARNS R. JENKINS *Re 30*