


5/24/72  
 365+50 - 381+61.8  
 5' of 4" to  
 Richard A Wilson  
 BK 26 Pg 240  
 Oct 1937



DRILLING AND BLASTING OF  
 SOLID ROCK SUBGRADE  
 336+90 - 337+60

POOR ORIGINAL COPY

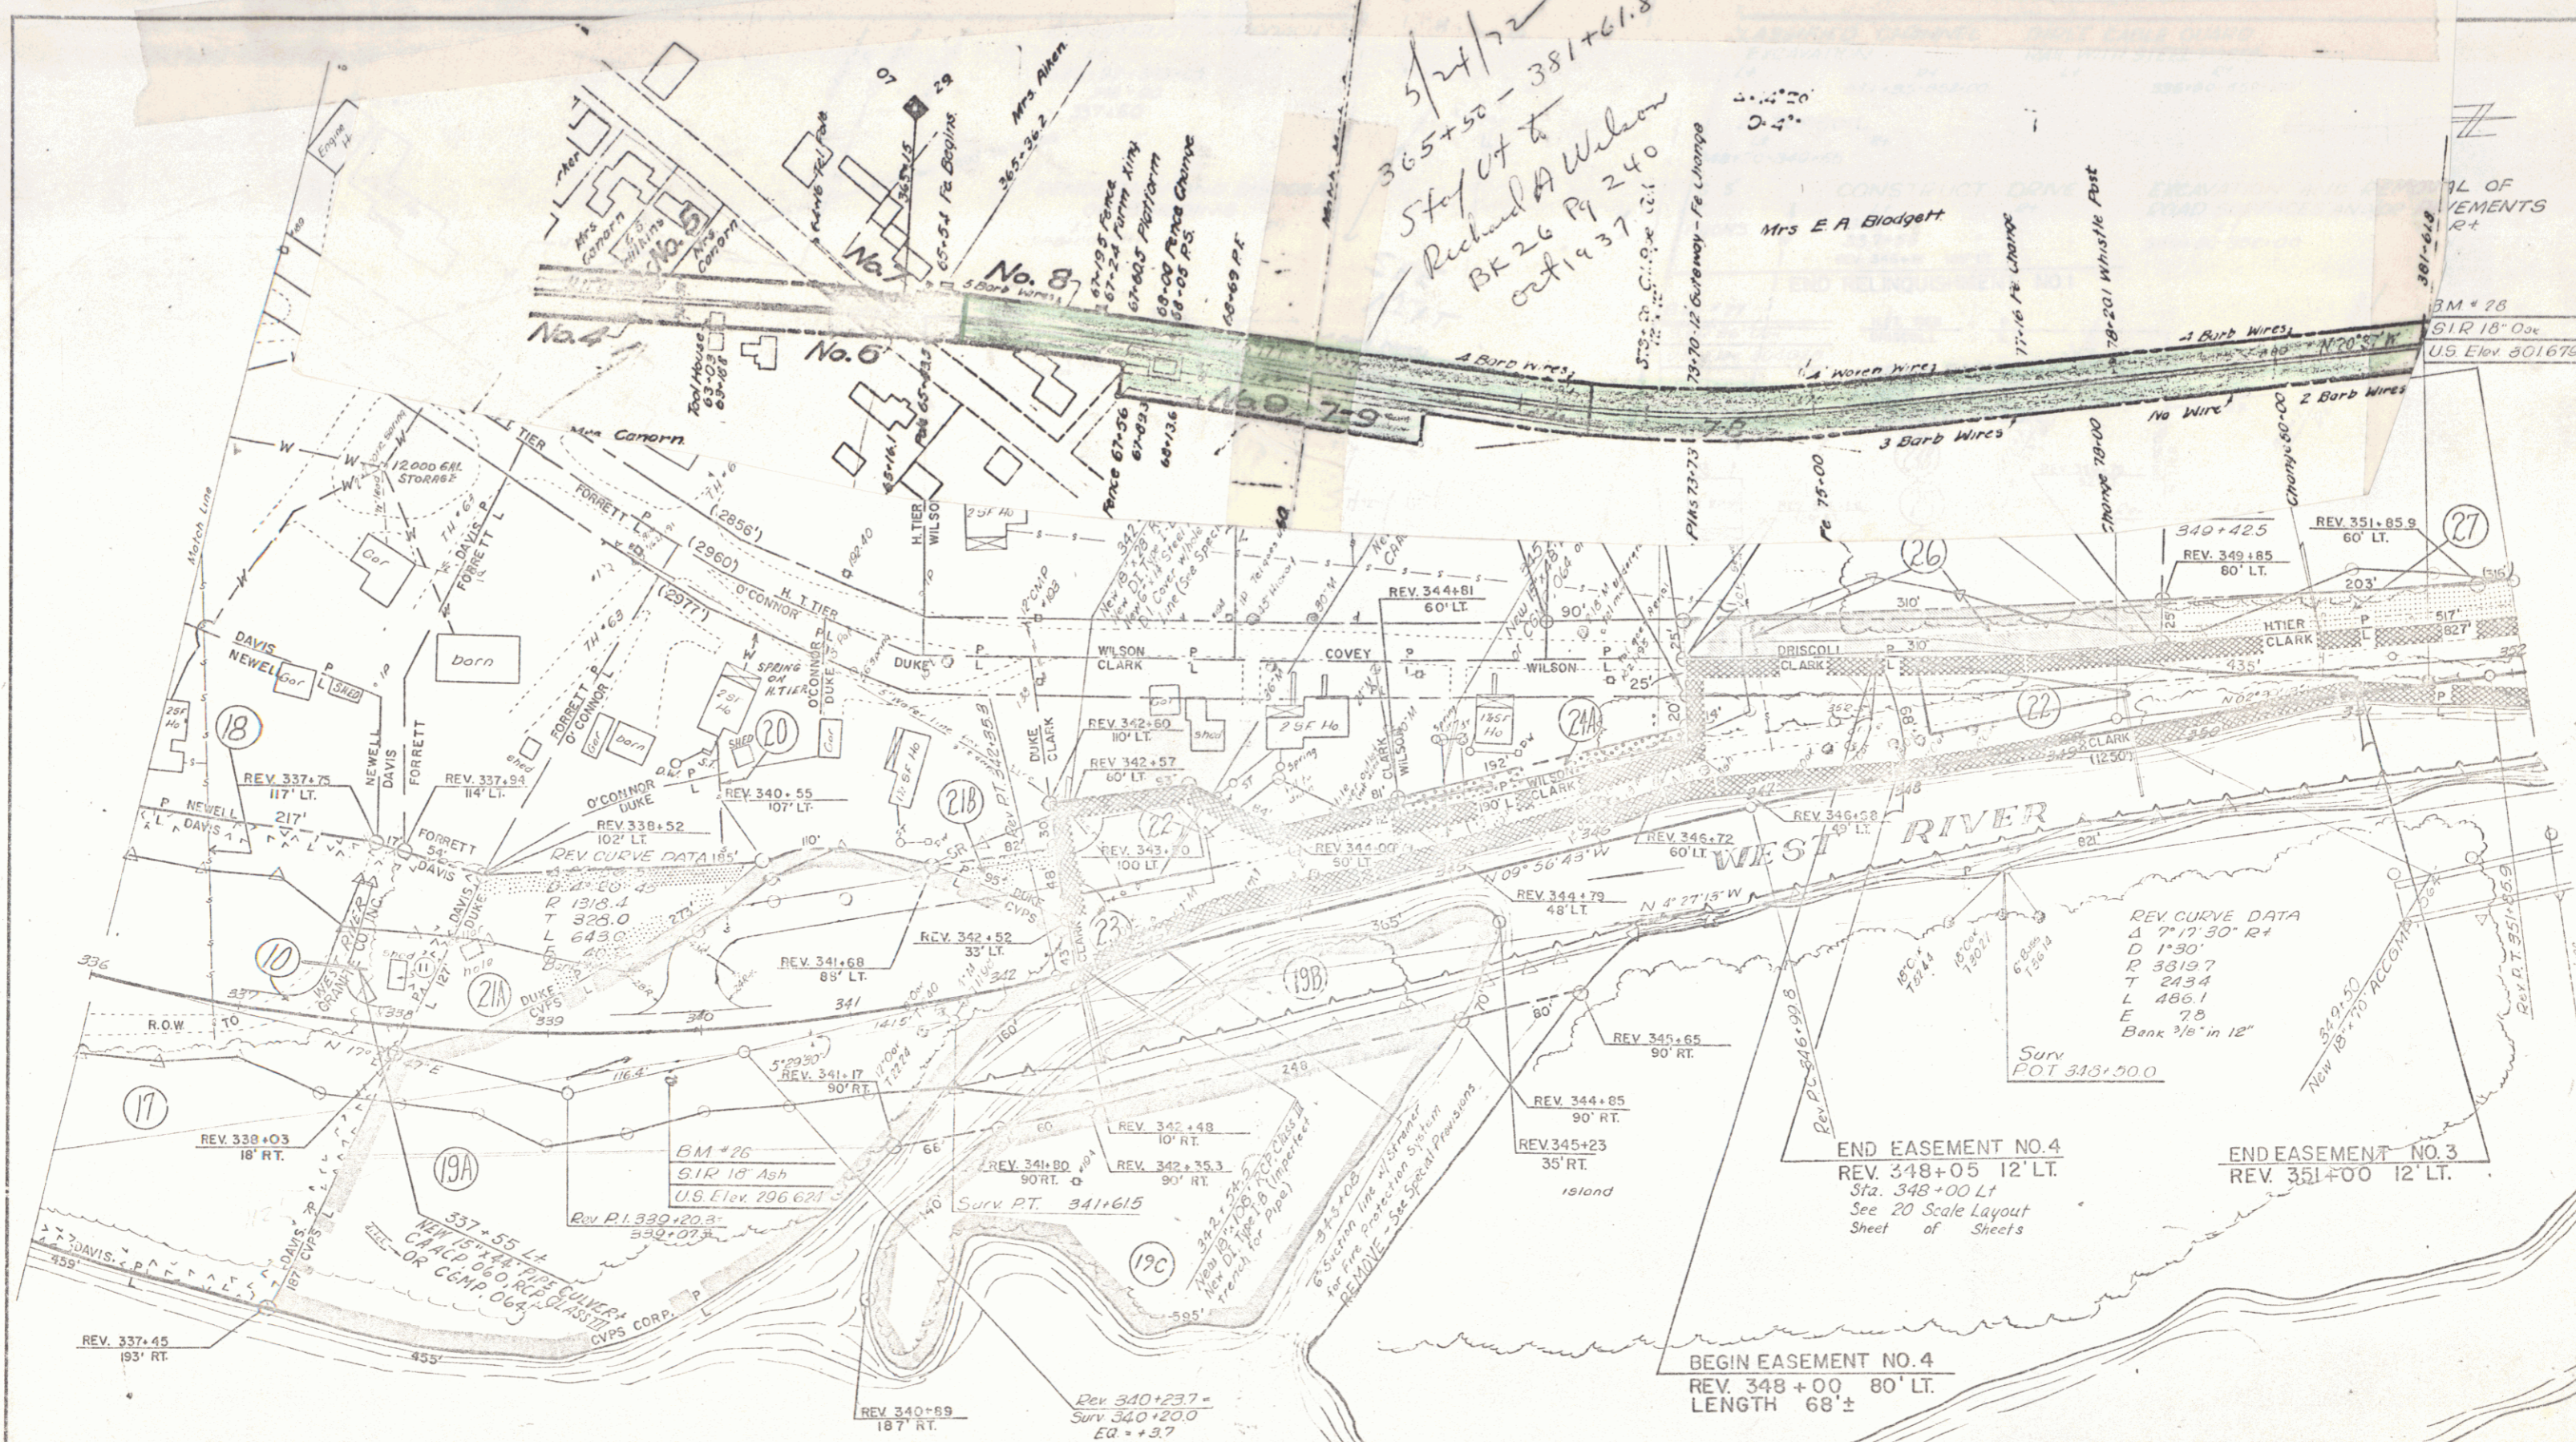

SURVEYED BY Jewett DATE 1961  
 DRAWN BY D.H.B. & WAL DATE Nov 1964  
 TRACED BY Louman DATE Dec 1964  
 DUMMERSTON  
 PROJ. S NO. 0119(2)  
 SHEET 21A OF 44