


DRILLING AND BLASTING
OF SOLID ROCK SUBGRADE
420+75 - 432+00

THREE CABLE GUARD RAIL
WITH STEEL POSTS
L+ 424+00 - 432+00

EXCAVATION AND REMOVAL OF
ROAD SURFACES AND PAVEMENTS
RT
419+85 - 428+25
429+85 - 432+00

PLANK GUARD RAIL
(for barricade)
LT
419+60
RT
419+70

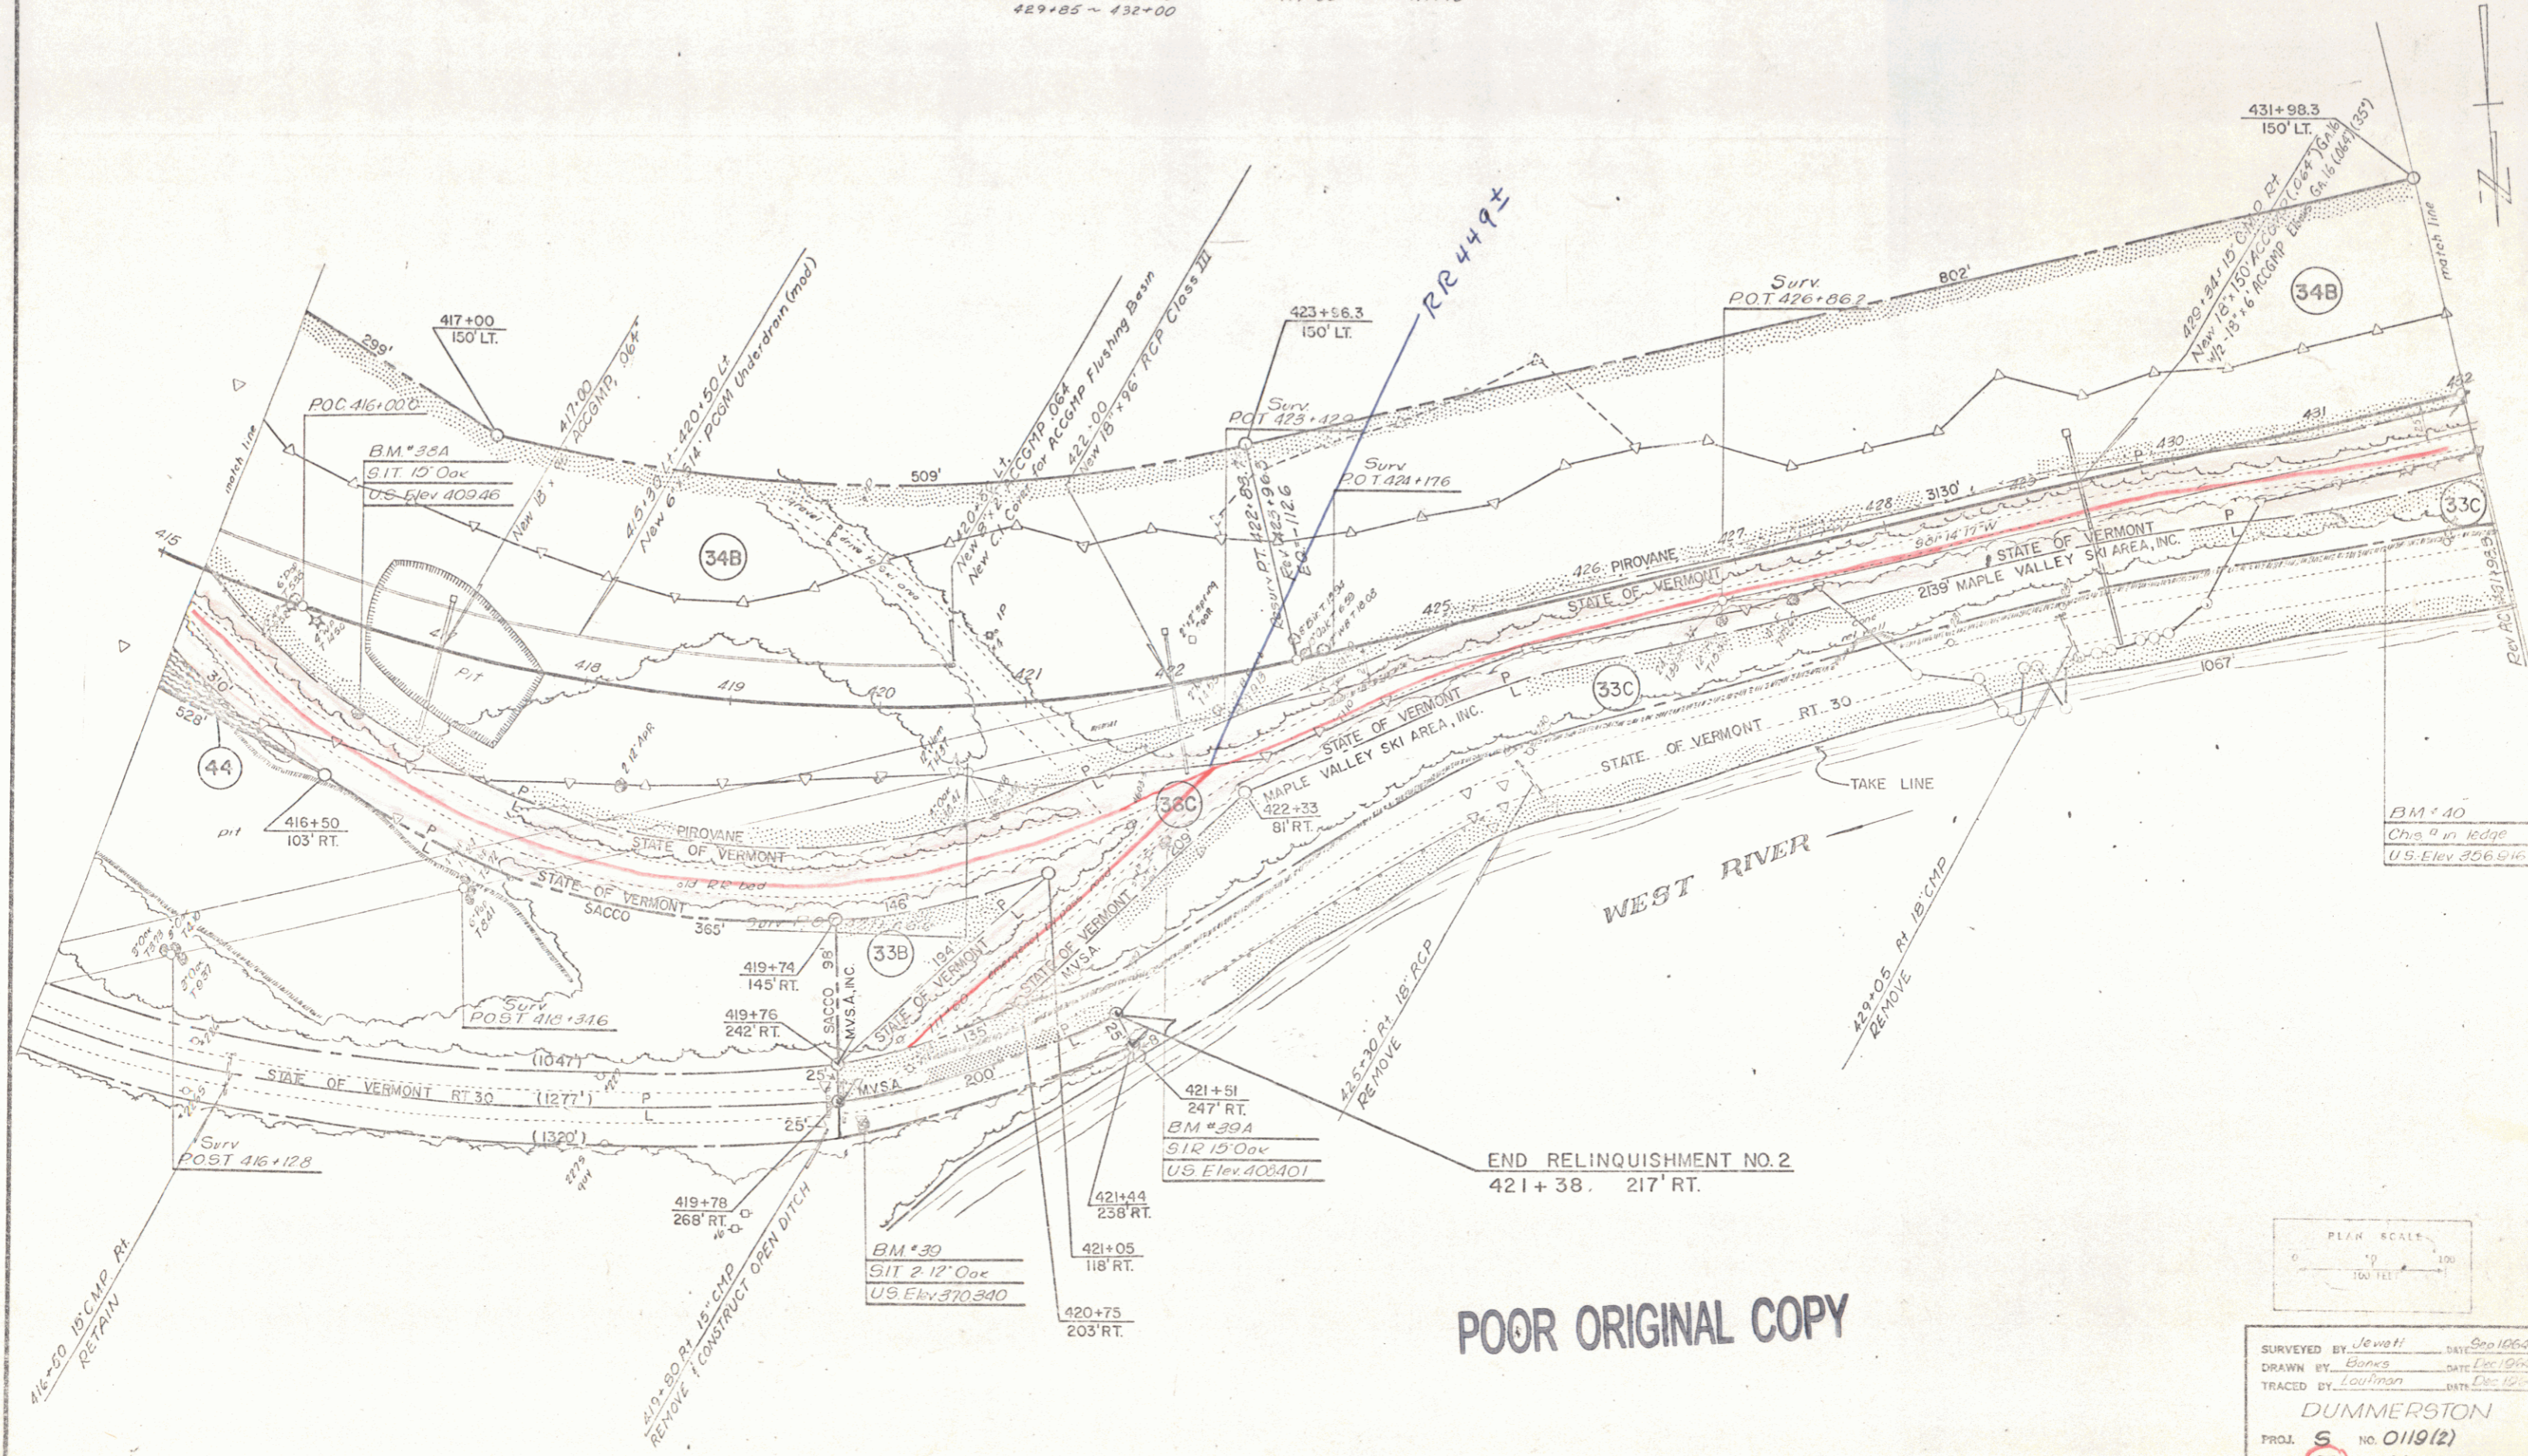

POOR ORIGINAL COPY

PLANK SCALE
0 100 200
1" = 100 FEET

SURVEYED BY Jewett DATE Nov 1964
DRAWN BY Bones DATE Dec 1964
TRACED BY Louman DATE Dec 1964

DUMMERSTON
PROJ. S NO. 0119(2)
SHEET 26 OF 44