
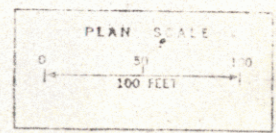


STONE FILL FOR SLOPE PROTECTION (Heavy Type) Lt 453+00-453+90  
 UNCLASSIFIED CHANNEL EXCAVATION Lt 452+00-453+90  
 THREE CABLE GUARD RAIL WITH STEEL POSTS Lt 445+00-445+43 445+00-461+00  
 TREATED TIMBER CURB Lt 453+00-461+00  
 EXCAVATION AND REMOVAL OF ROAD SURFACES AND PAVEMENTS Lt 445+00-451+65 459+50-461+00  
 REMOVAL AND DISPOSAL OF PRESENT GUARD RAIL Lt 459+45-461+00

CHAN. POT 3+00.0 =  
 M/L POT 445+00.0  
 Δ 77°-44'-40" Lt

CONSTRUCT TURNOUT Lt 445+30-446+20  
 CONSTRUCT DRIVE Lt 445+50  
 ROCK FILL Rt 352+50-358+25

*Taft sta. QCD 12/14/37 BK 26 Pg 246*

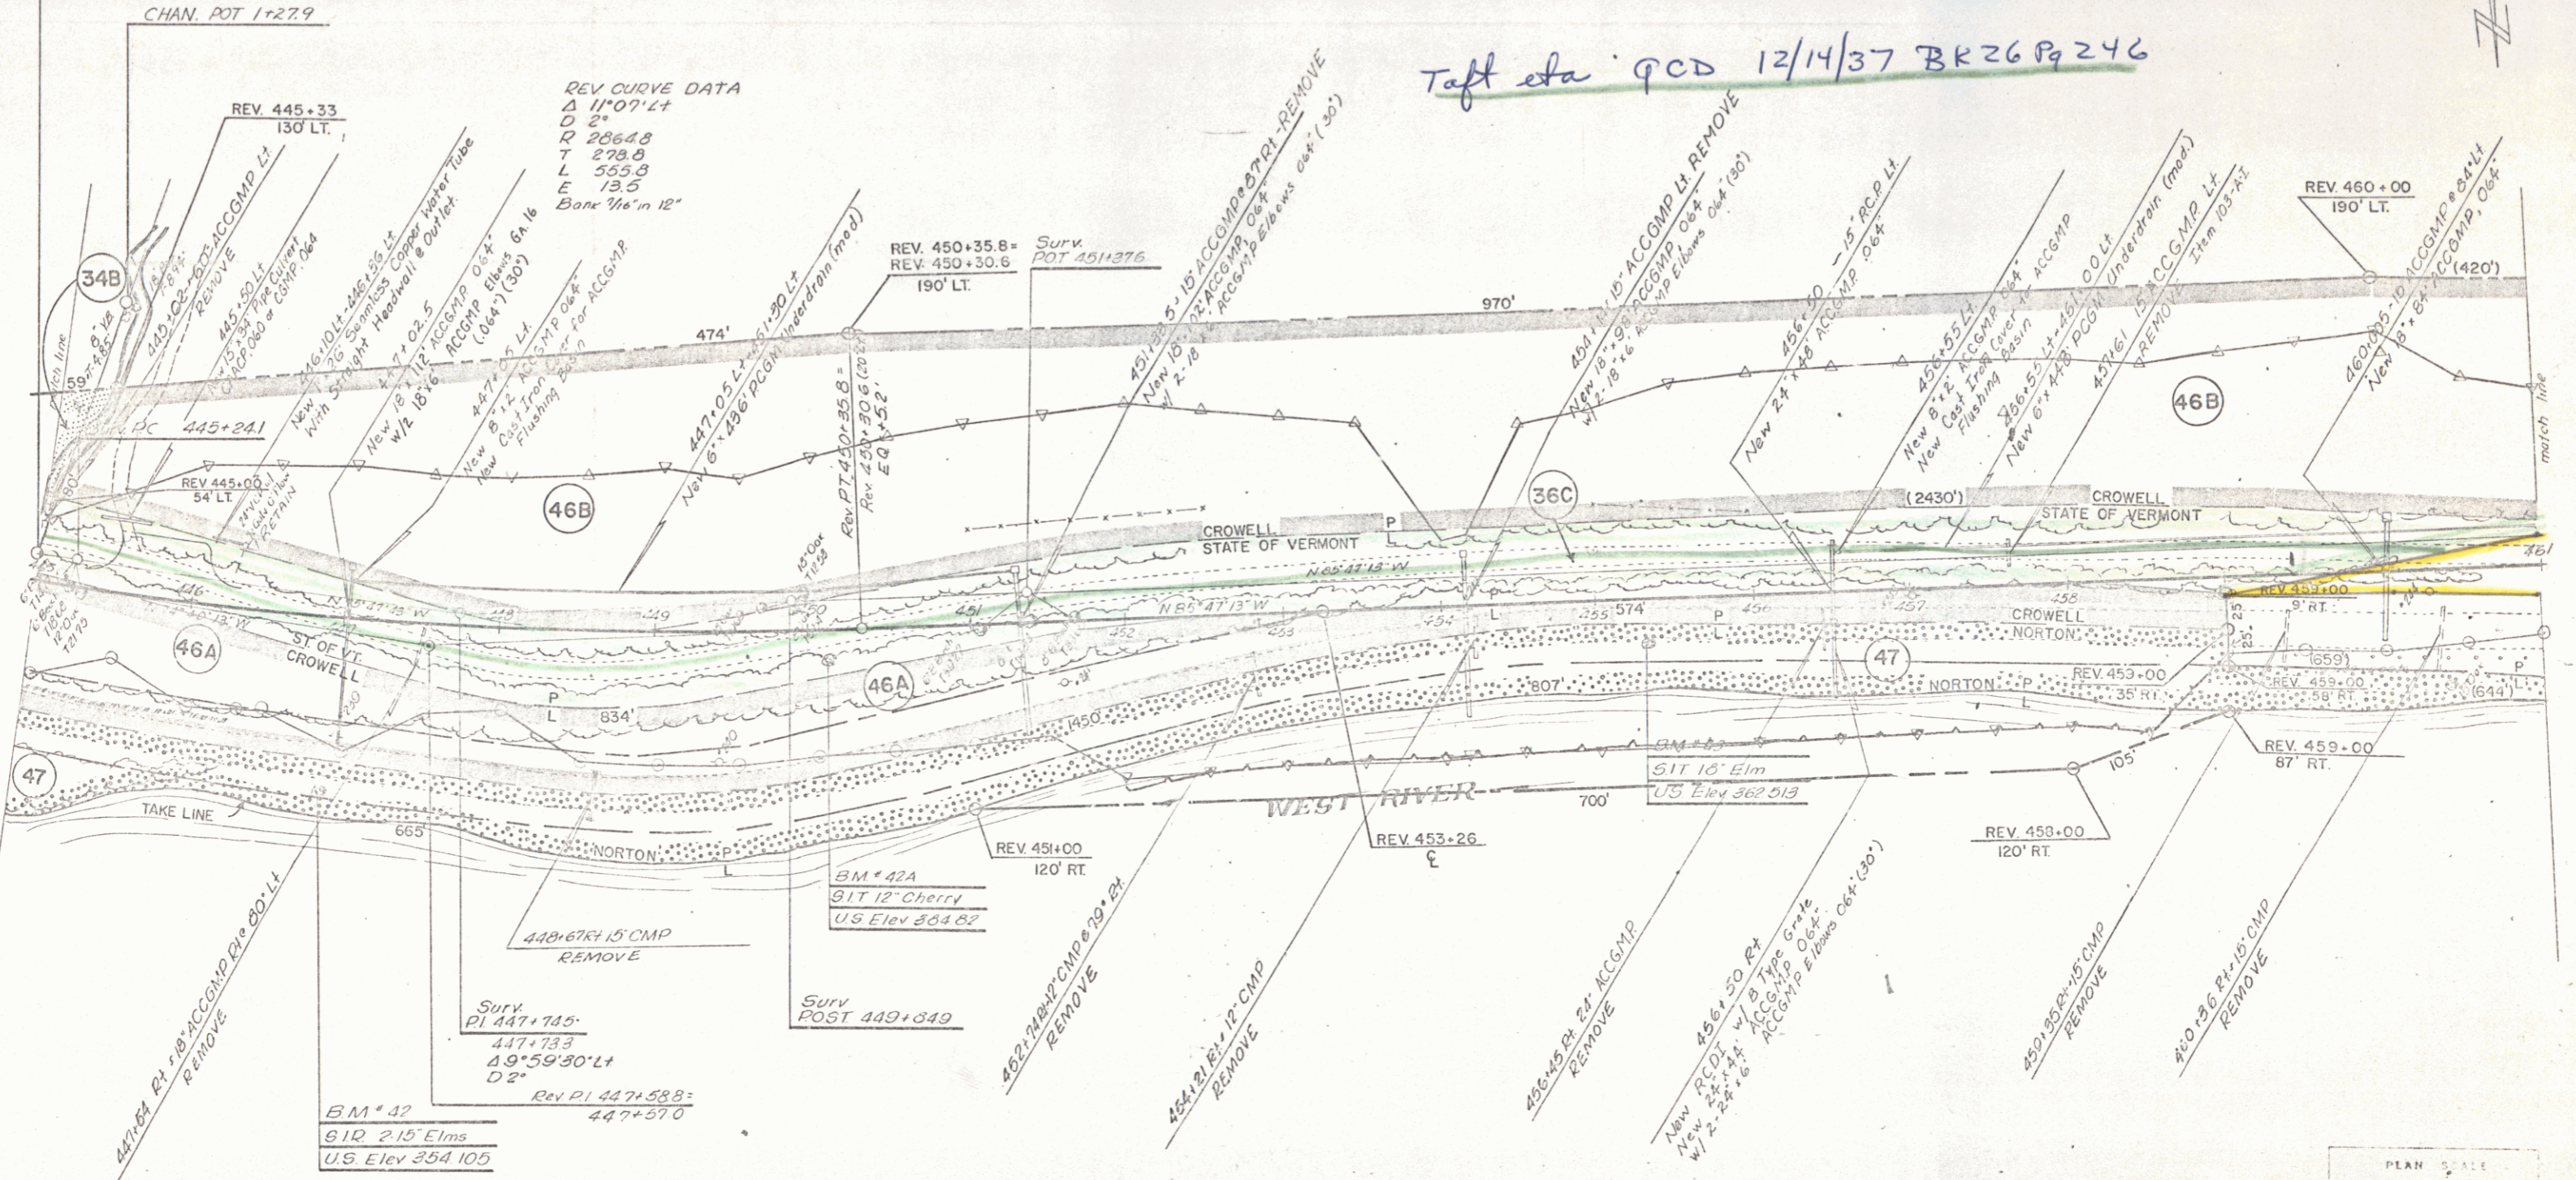

SURVEYED BY: Jewett DATE: Sep 1964  
 DRAWN BY: Banks DATE: Dec 1964  
 TRACED BY: Loulin DATE: Dec 1964

**DUMMERSTON**

PROJ. 9 No. 0119(2)  
 SHEET 28 of 44