
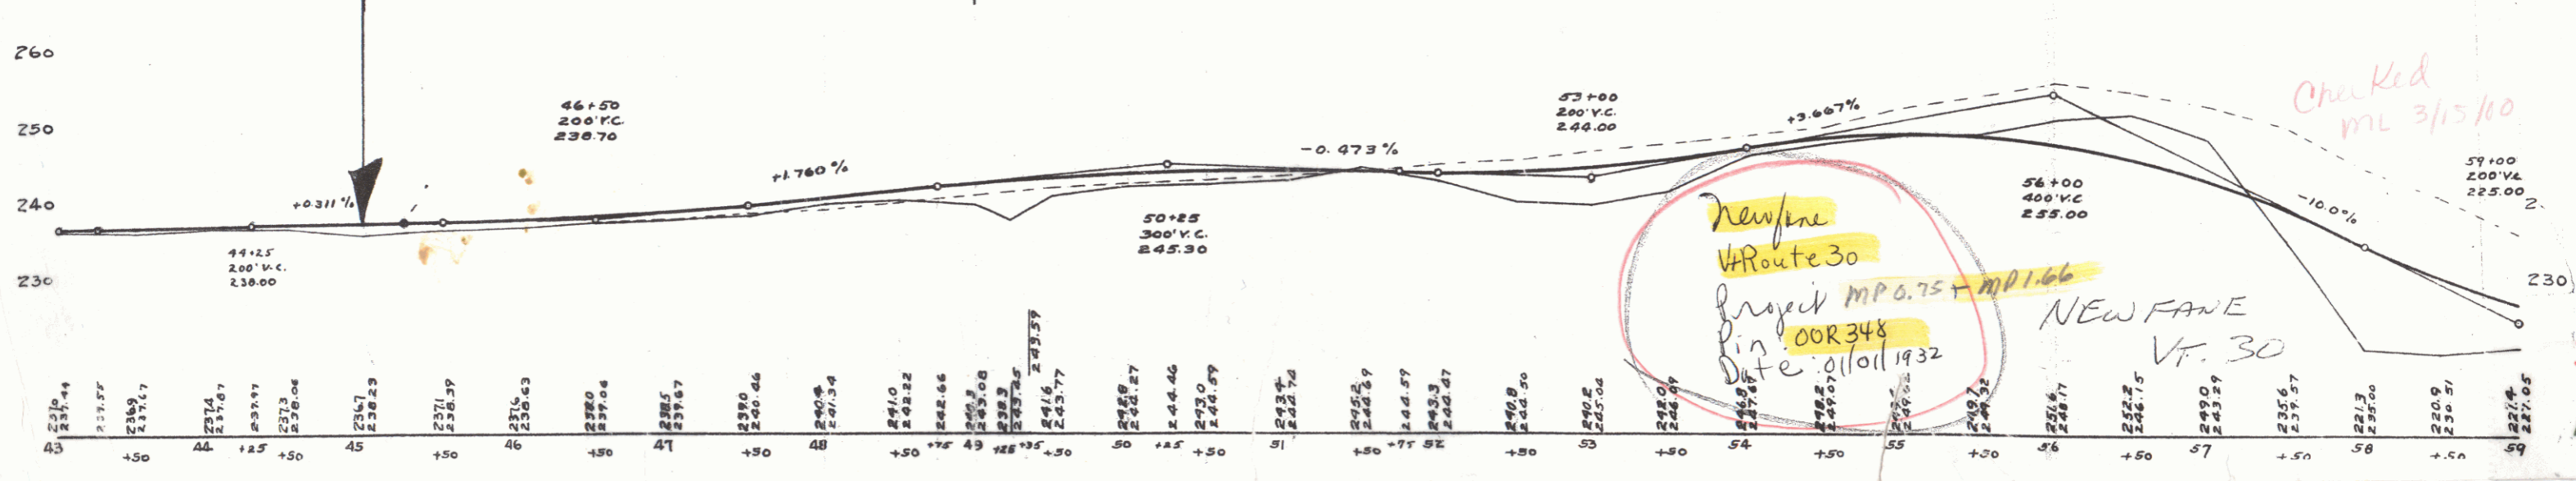
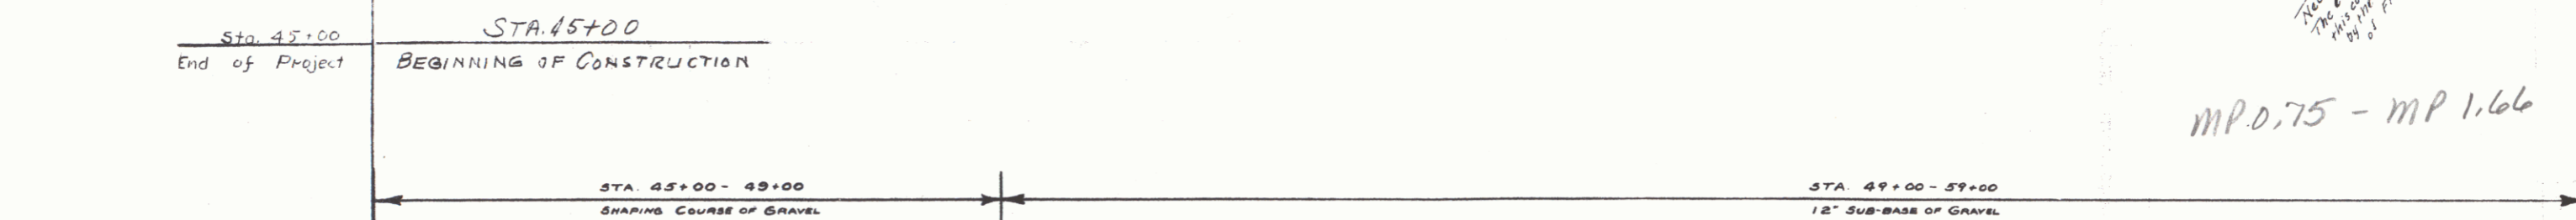


INDEX  
 SHEETS 10A+10B refer to alternate line.

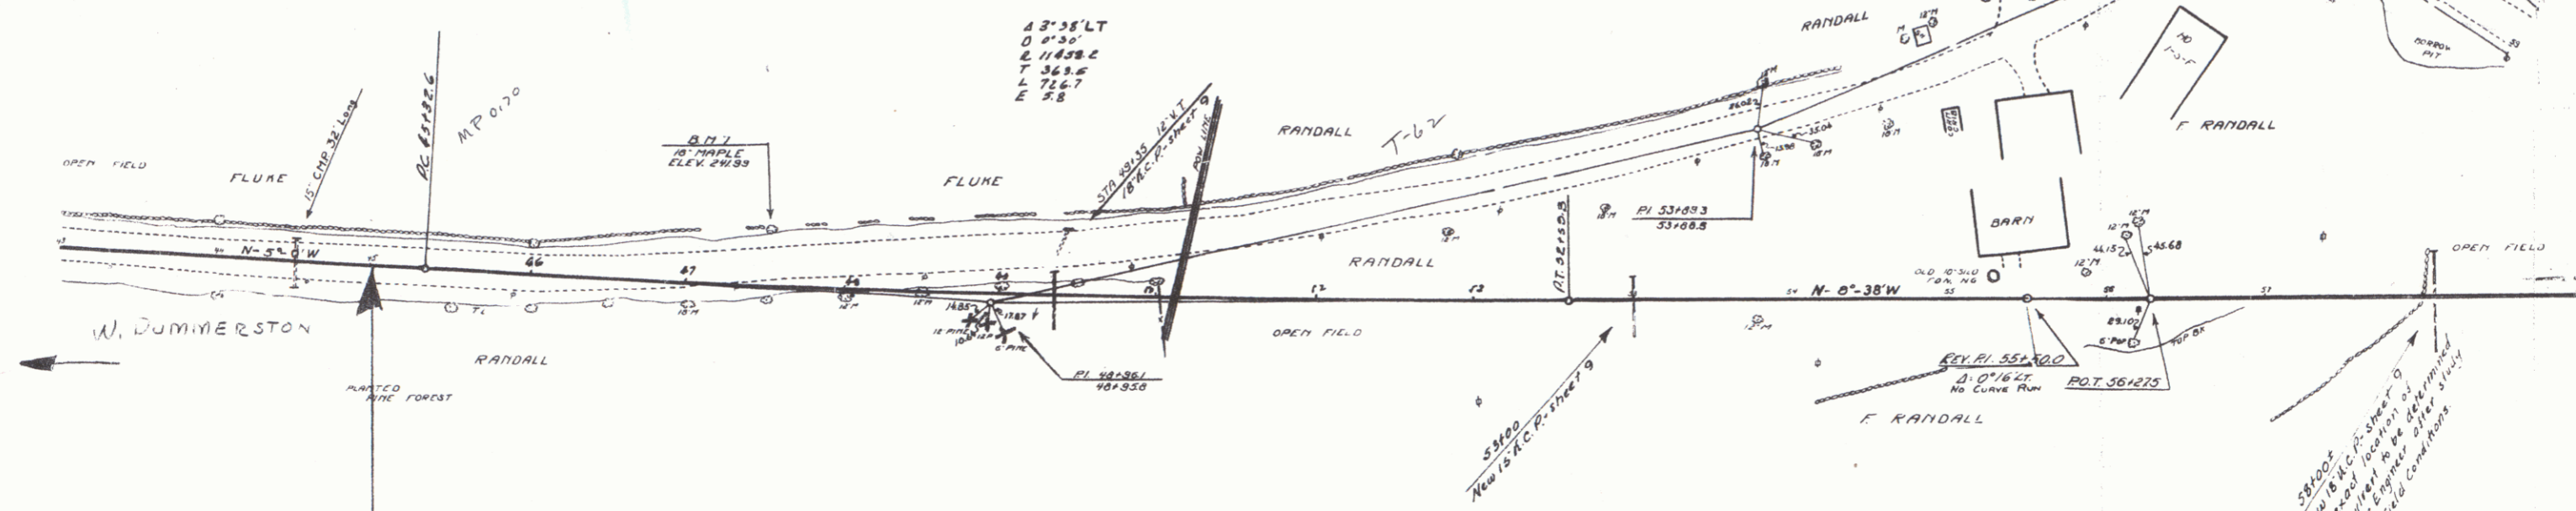


**New line**  
 Vt. Route 30  
 Project MP 0.75 - MP 1.66  
 Date 01/01/1932

NEW FANE  
 Vt. 30

MP 0.75 - MP 1.66



Checked  
 ml 3/15/10

3

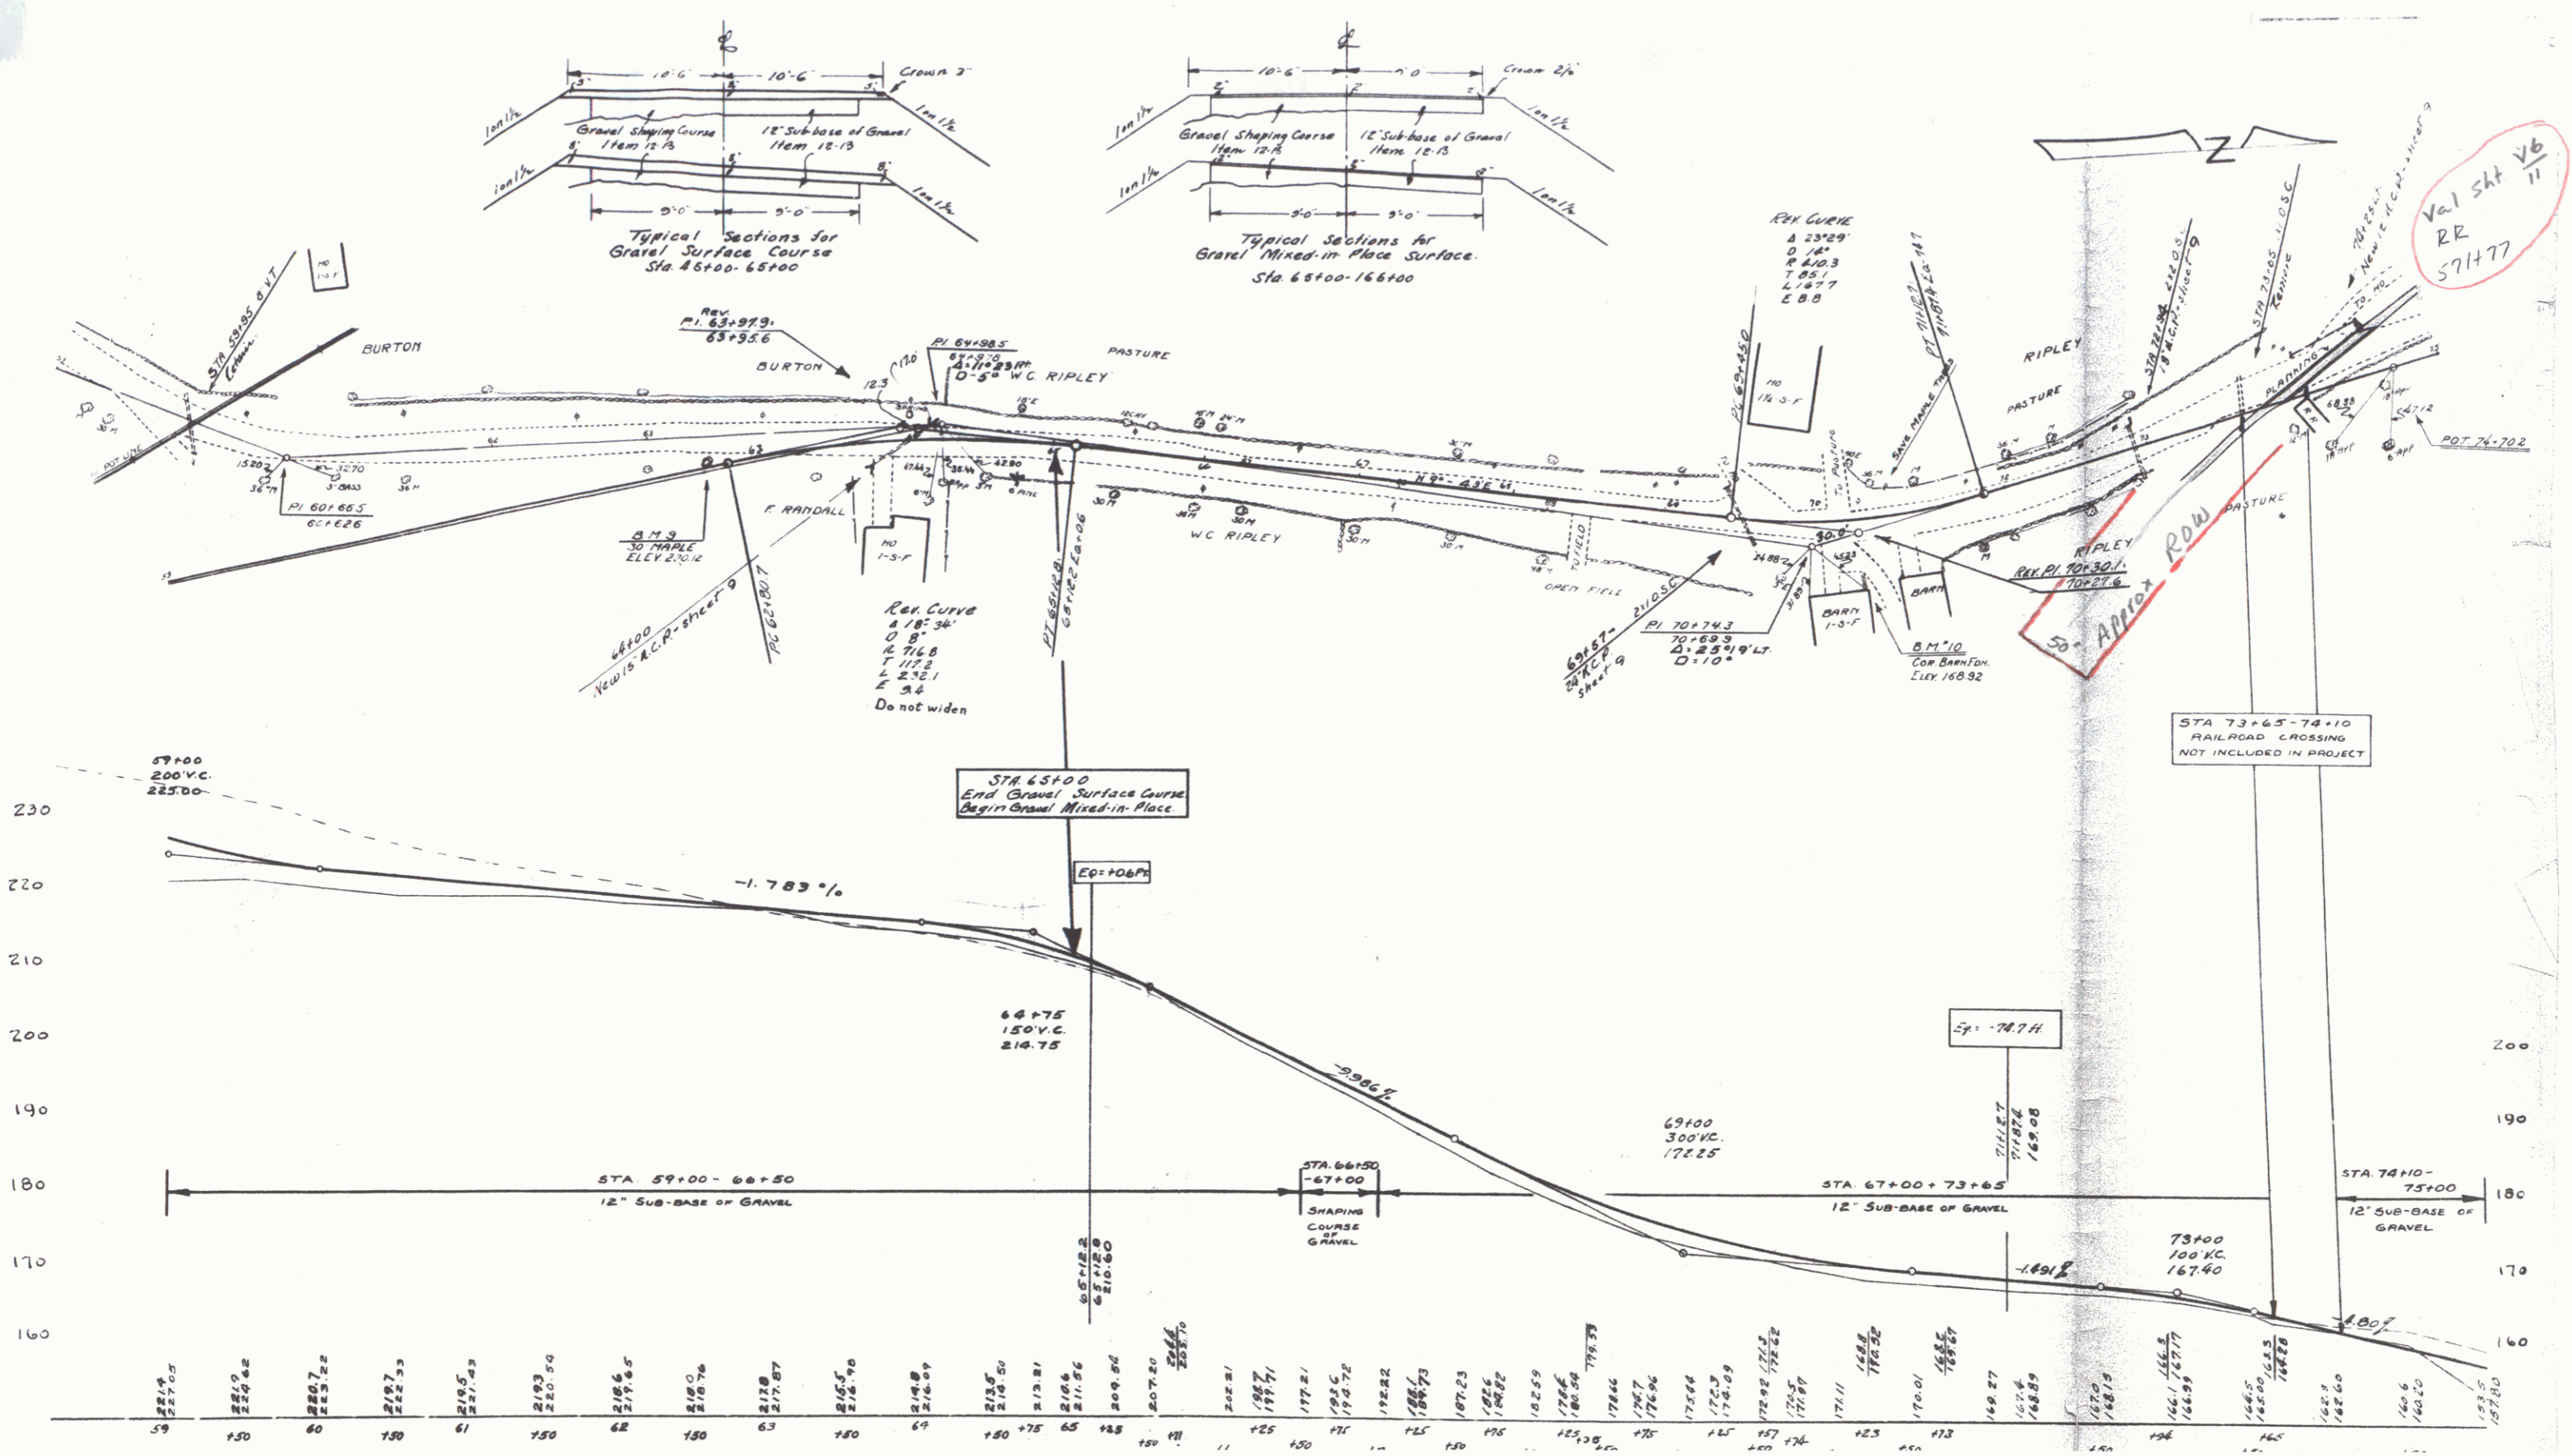

Val SKT V6  
RR  
57477

4  
2

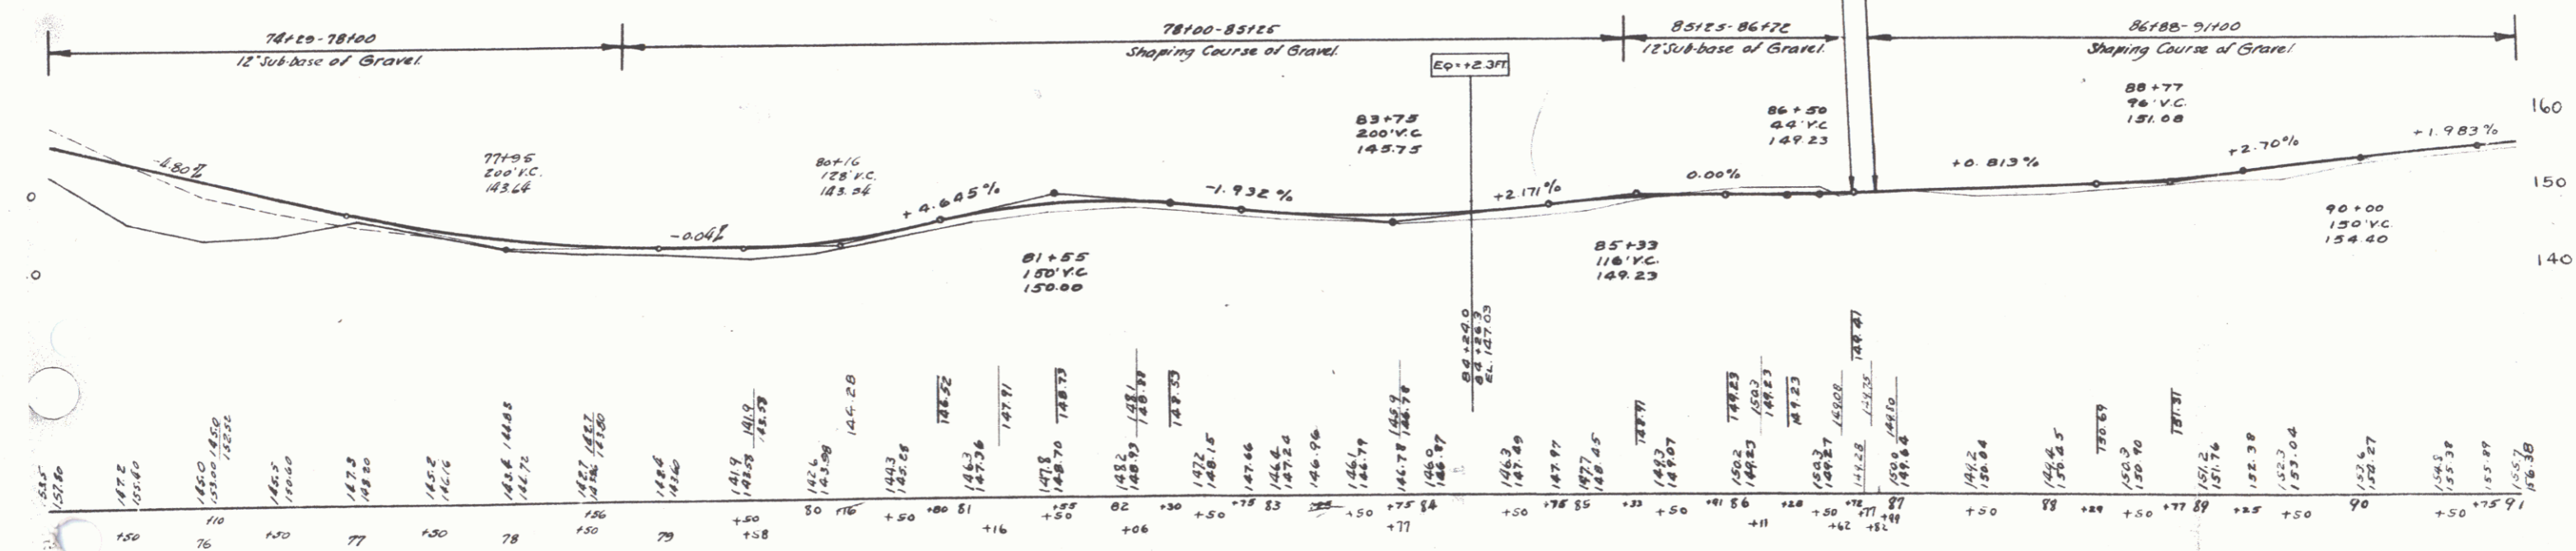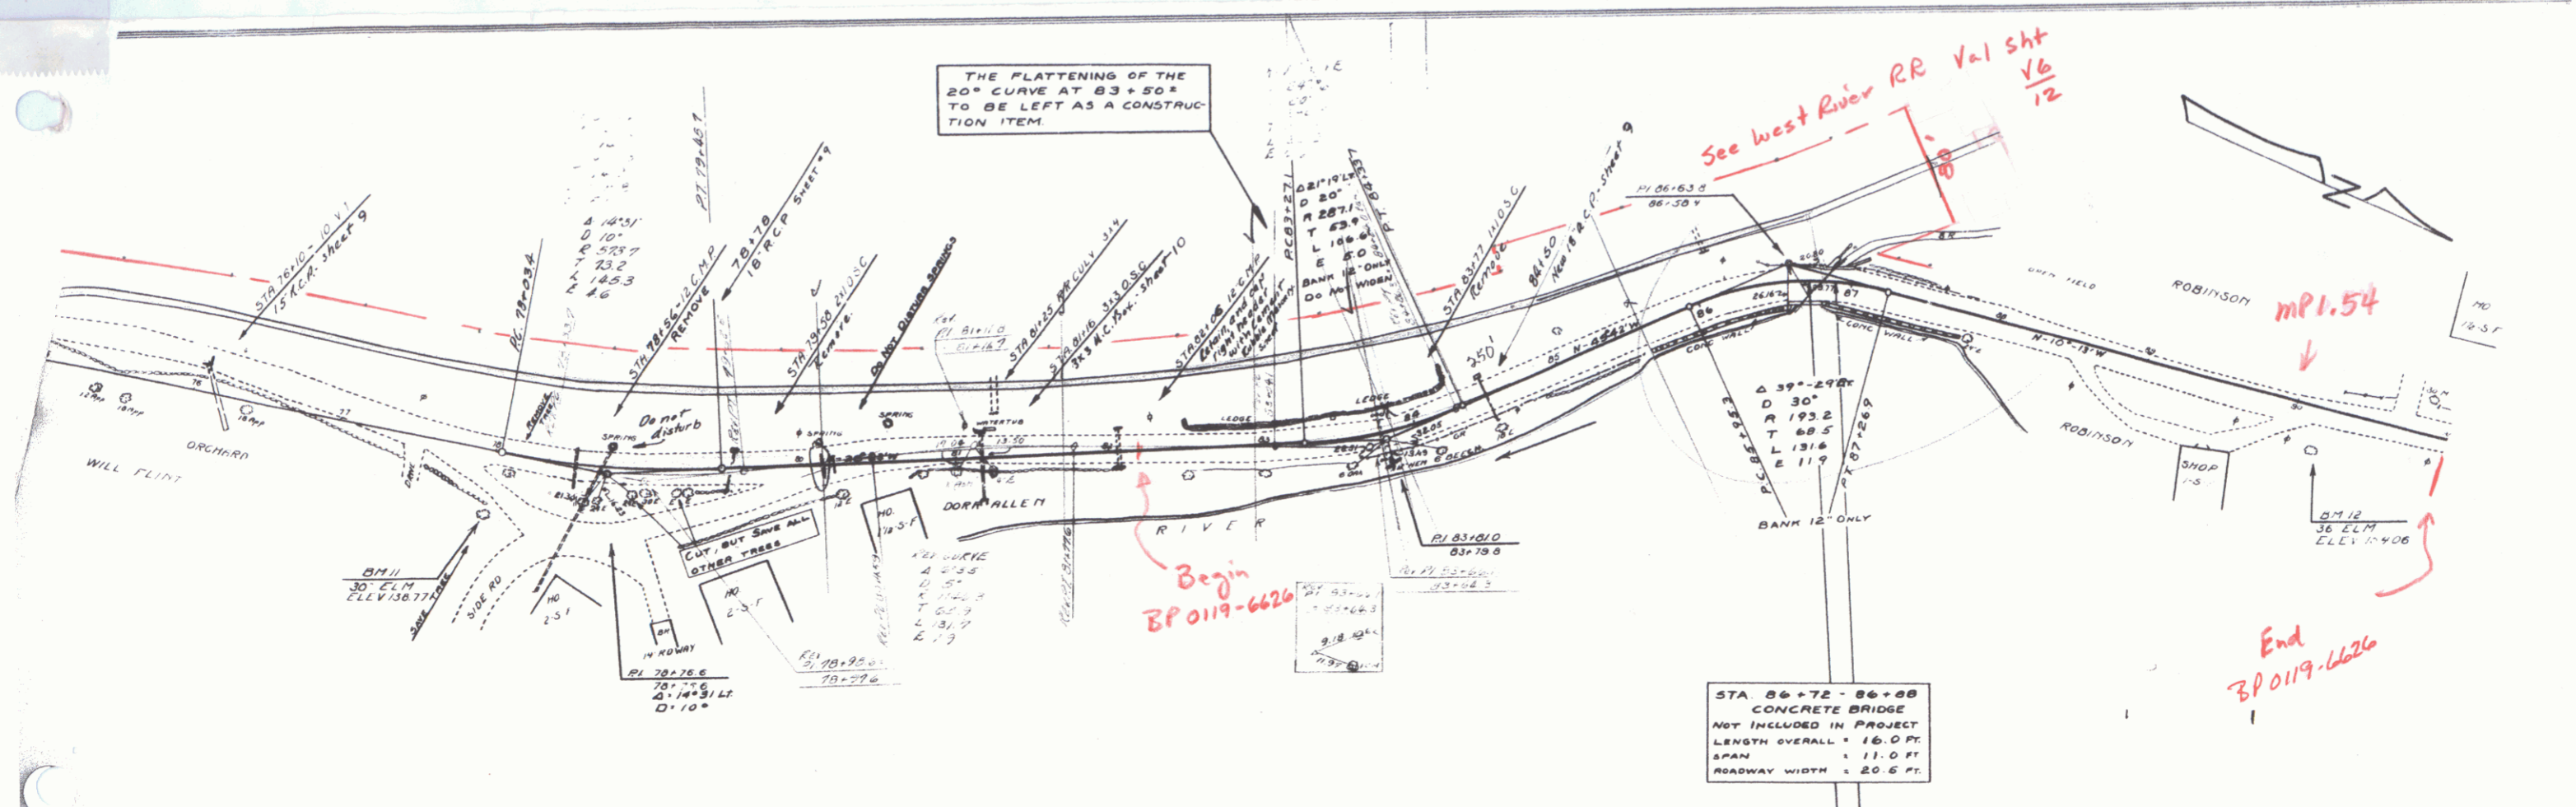

5  
3