
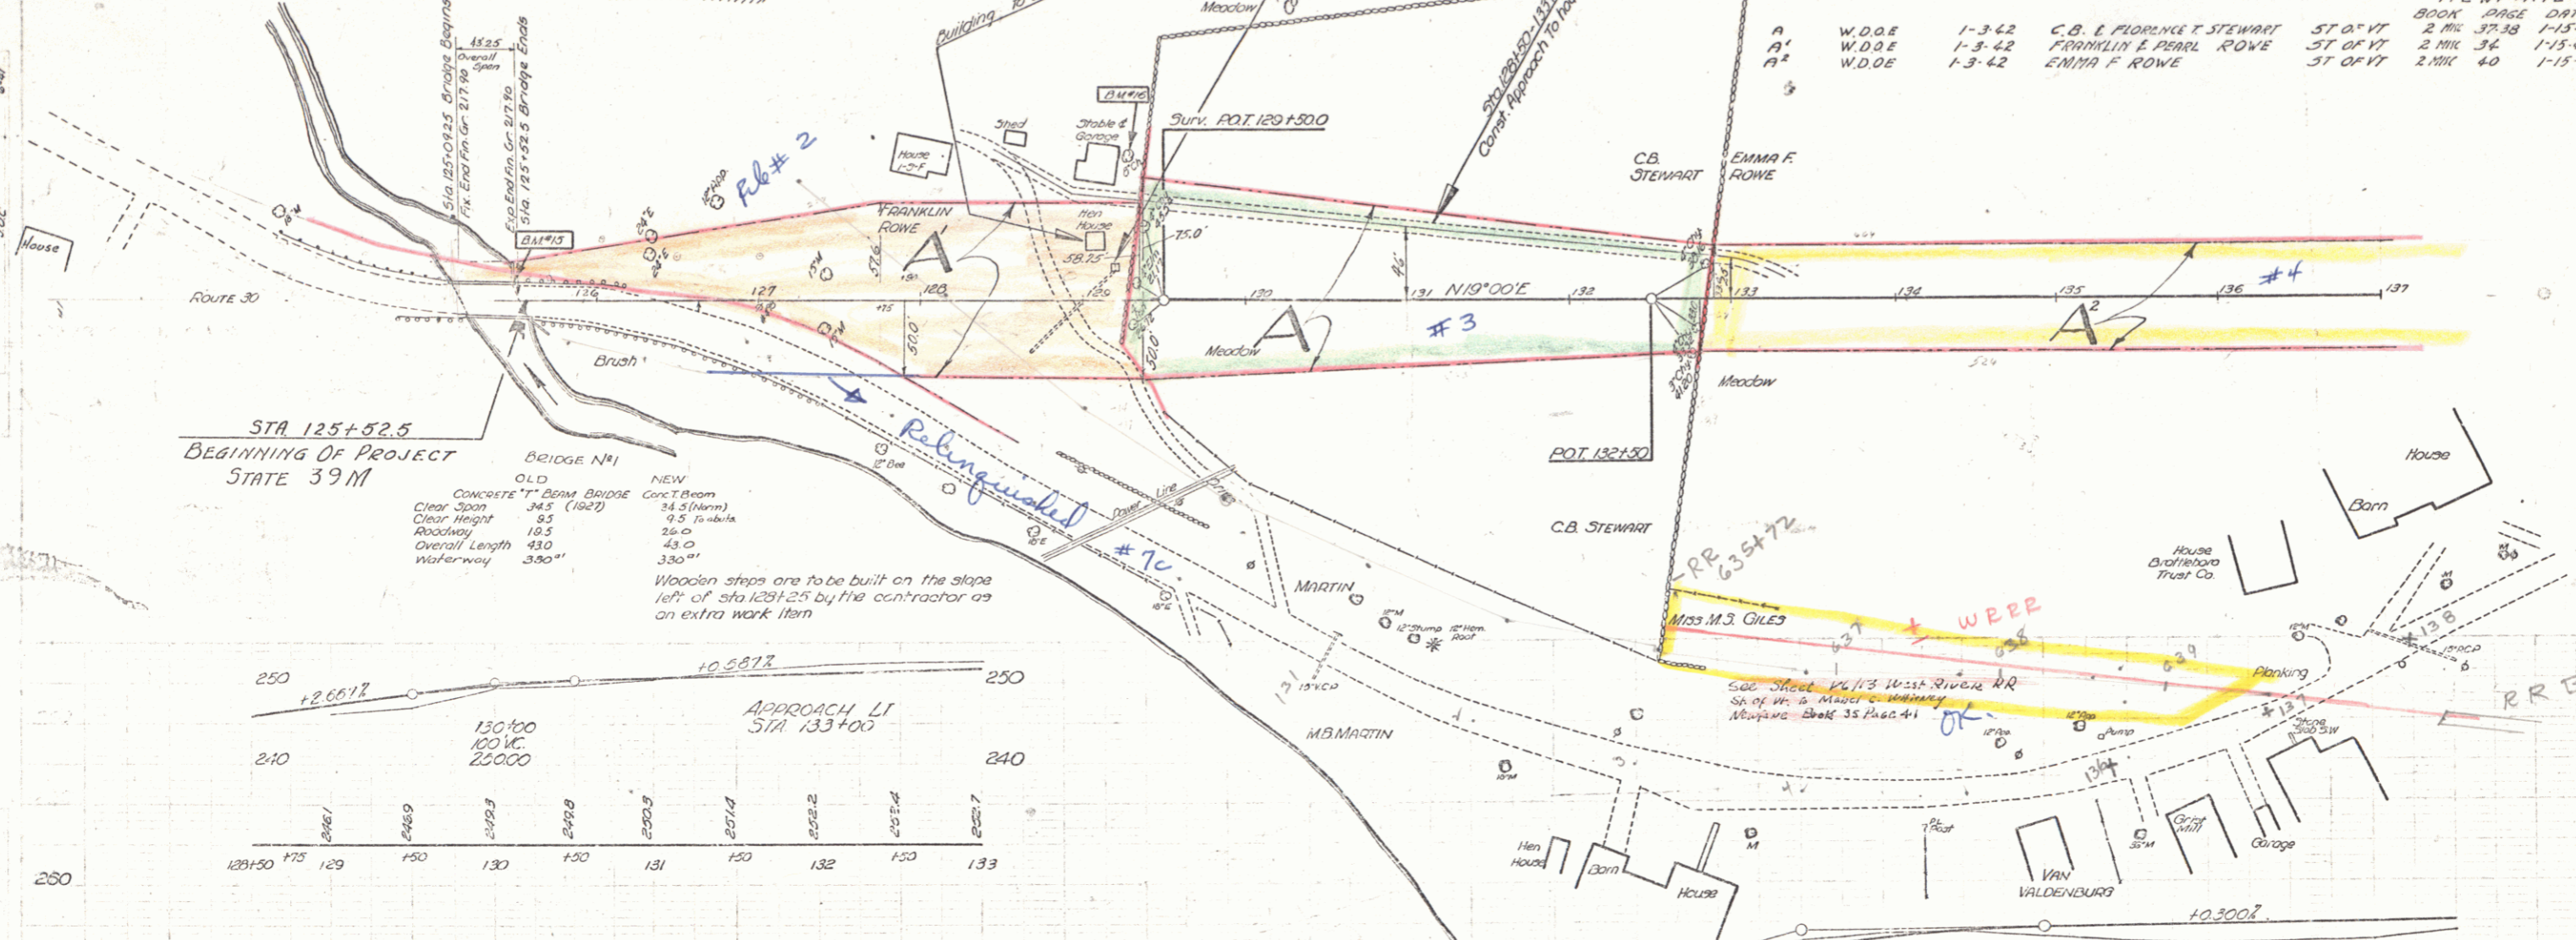


TYPICAL SECTION FOR APPROACH LT 133+00


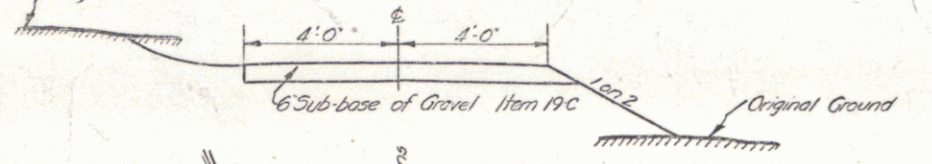


STA 125+52.5  
BEGINNING OF PROJECT  
STATE 39-M

BRIDGE N#1  
NEW  
CONCRETE T-BEAM BRIDGE  
Clear Span 34.5 (102')  
Clear Height 9.5  
Roadway 16.5  
Overall Length 43.0  
Waterway 33.0'

OLD  
CONCRETE T-BEAM BRIDGE  
Clear Span 34.5 (102')  
Clear Height 9.5  
Roadway 16.5  
Overall Length 43.0  
Waterway 33.0'

Wooden steps are to be built on the slope left of sta 125+25 by the contractor as an extra work item.

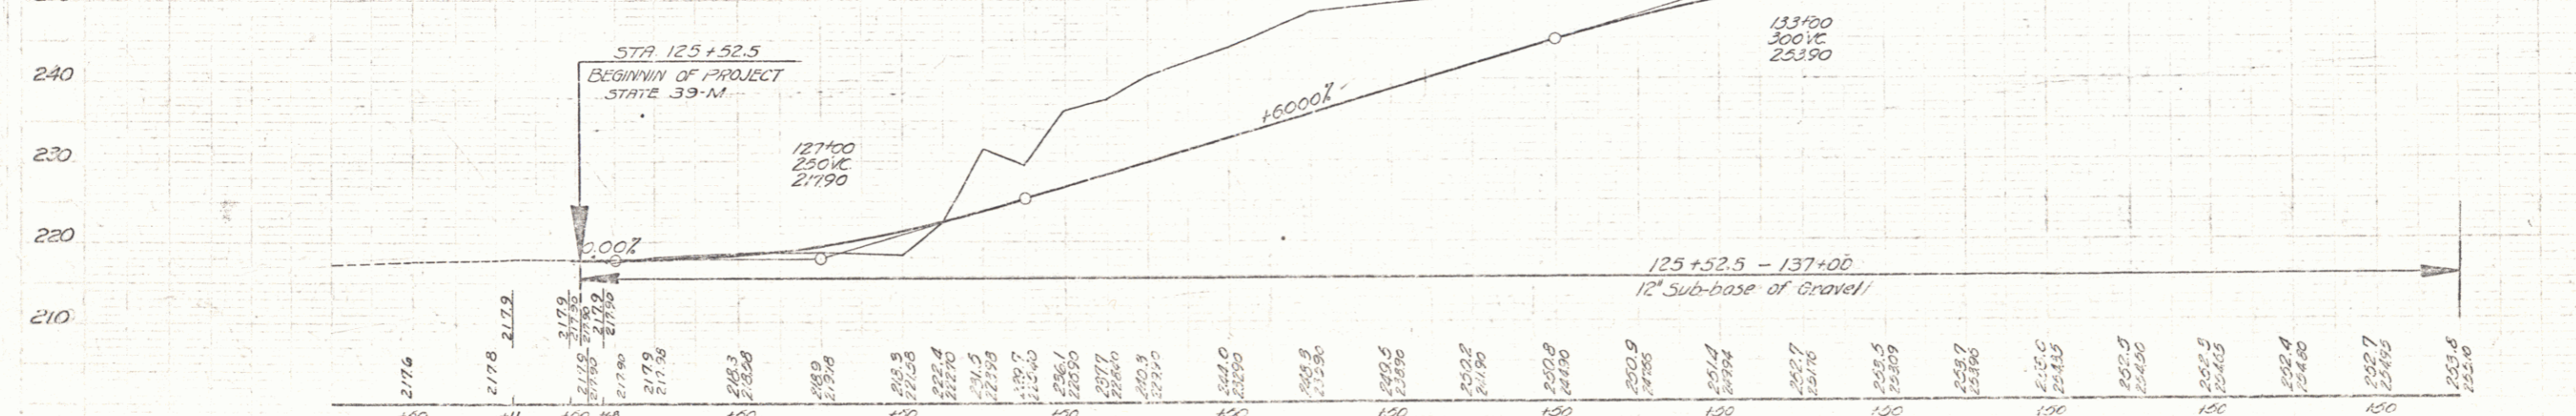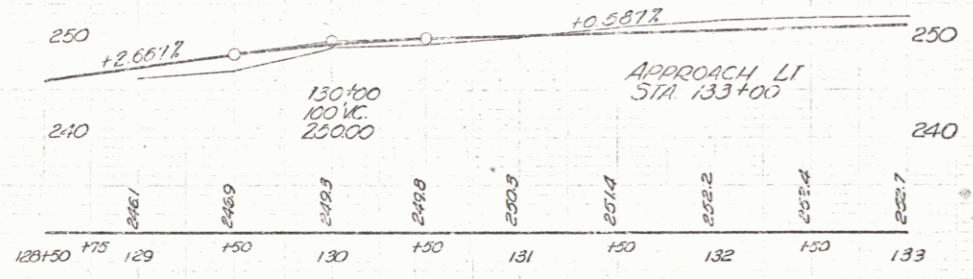

PARCEL	INSTRUMENT	DATE	GRANTOR	GRANTEE	RECORDED NEWFANE	REMARKS
A	W.D.O.E.	1-3-42	C.B. & FLORENCE T. STEWART	ST OF VT	BOOK PAGE DATE	
A'	W.D.O.E.	1-3-42	FRANKLIN & PEARL ROWE	ST OF VT	2 MK 36 1-15-42	
A''	W.D.O.E.	1-3-42	EMMA F. ROWE	ST OF VT	2 MK 40 1-15-42	

124 B.M. 15 - 3' on conc. bridge rail 10' W of sta 125+146 Elev 221.75  
 B.M. 16 - 5' 1" Cherry 65' W of sta 125+134 Elev 247.50  
 B.M. 17 - 5' 1" Cherry 229' W of sta 125+125 Elev 250.01