



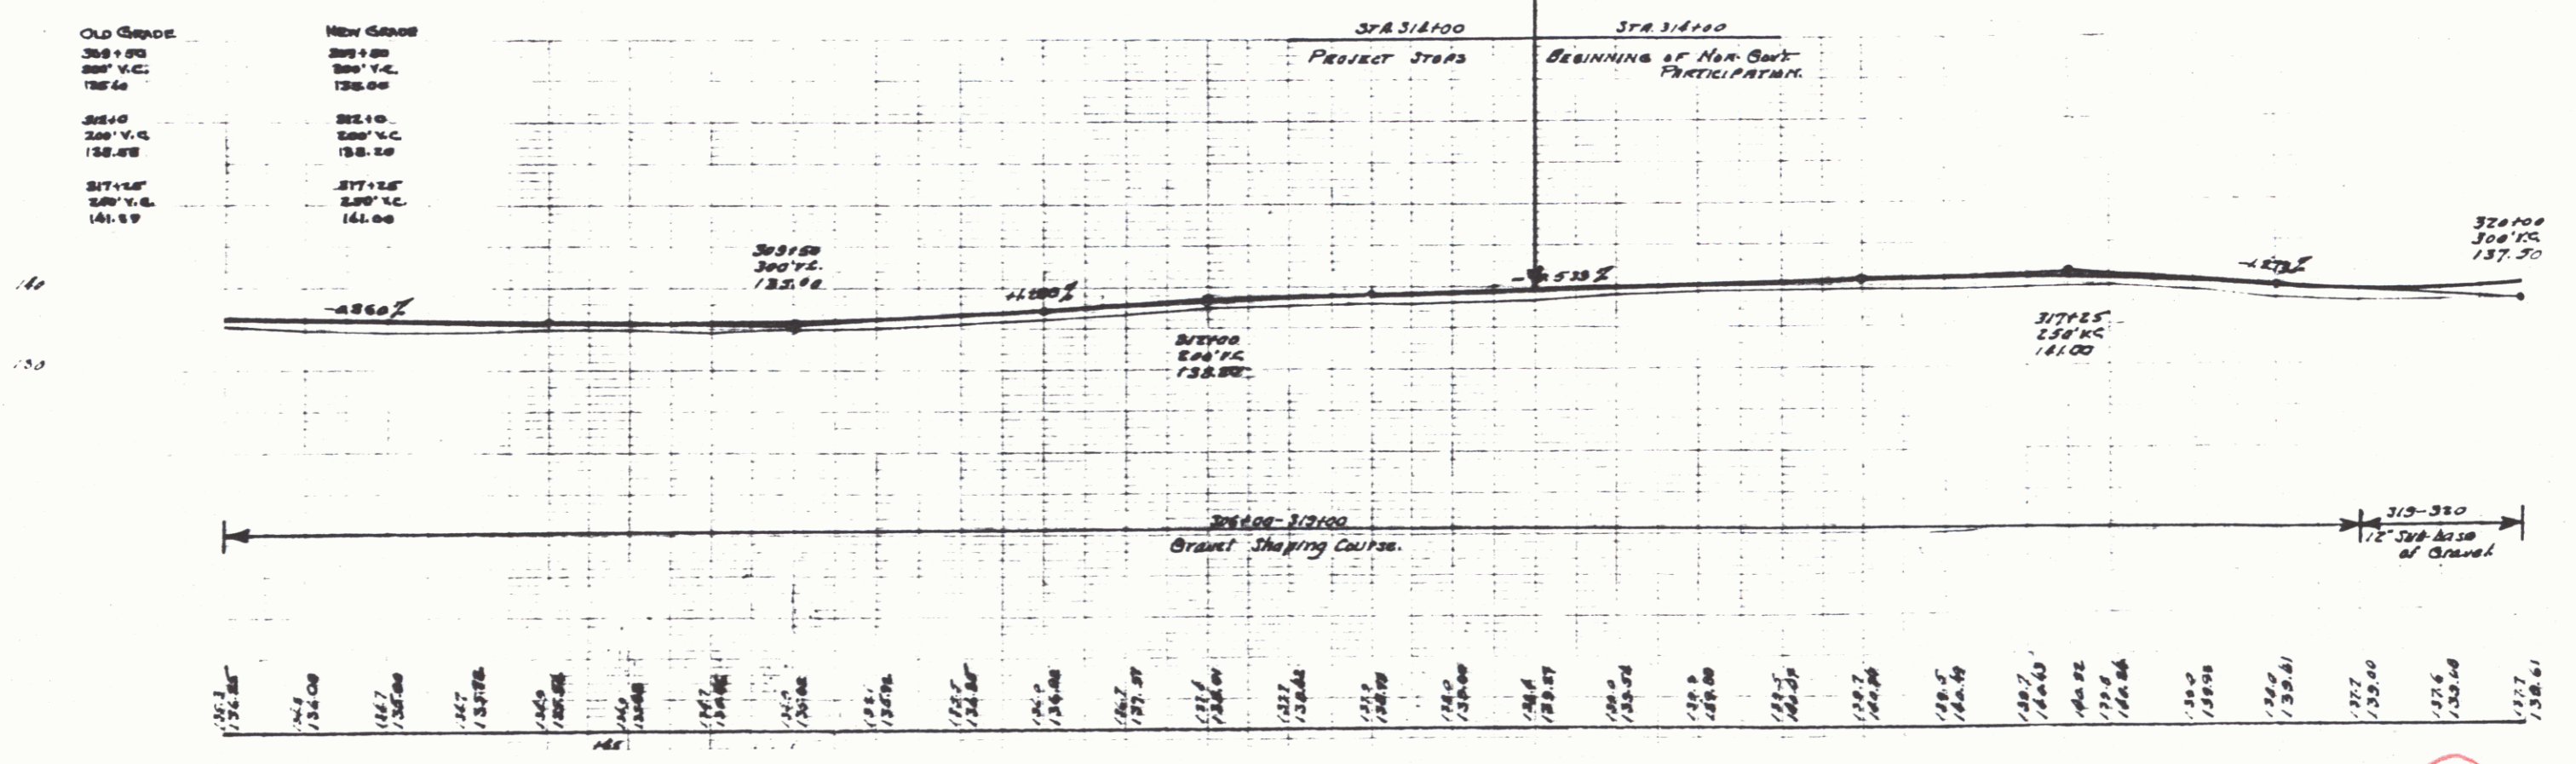

See F 159(2)

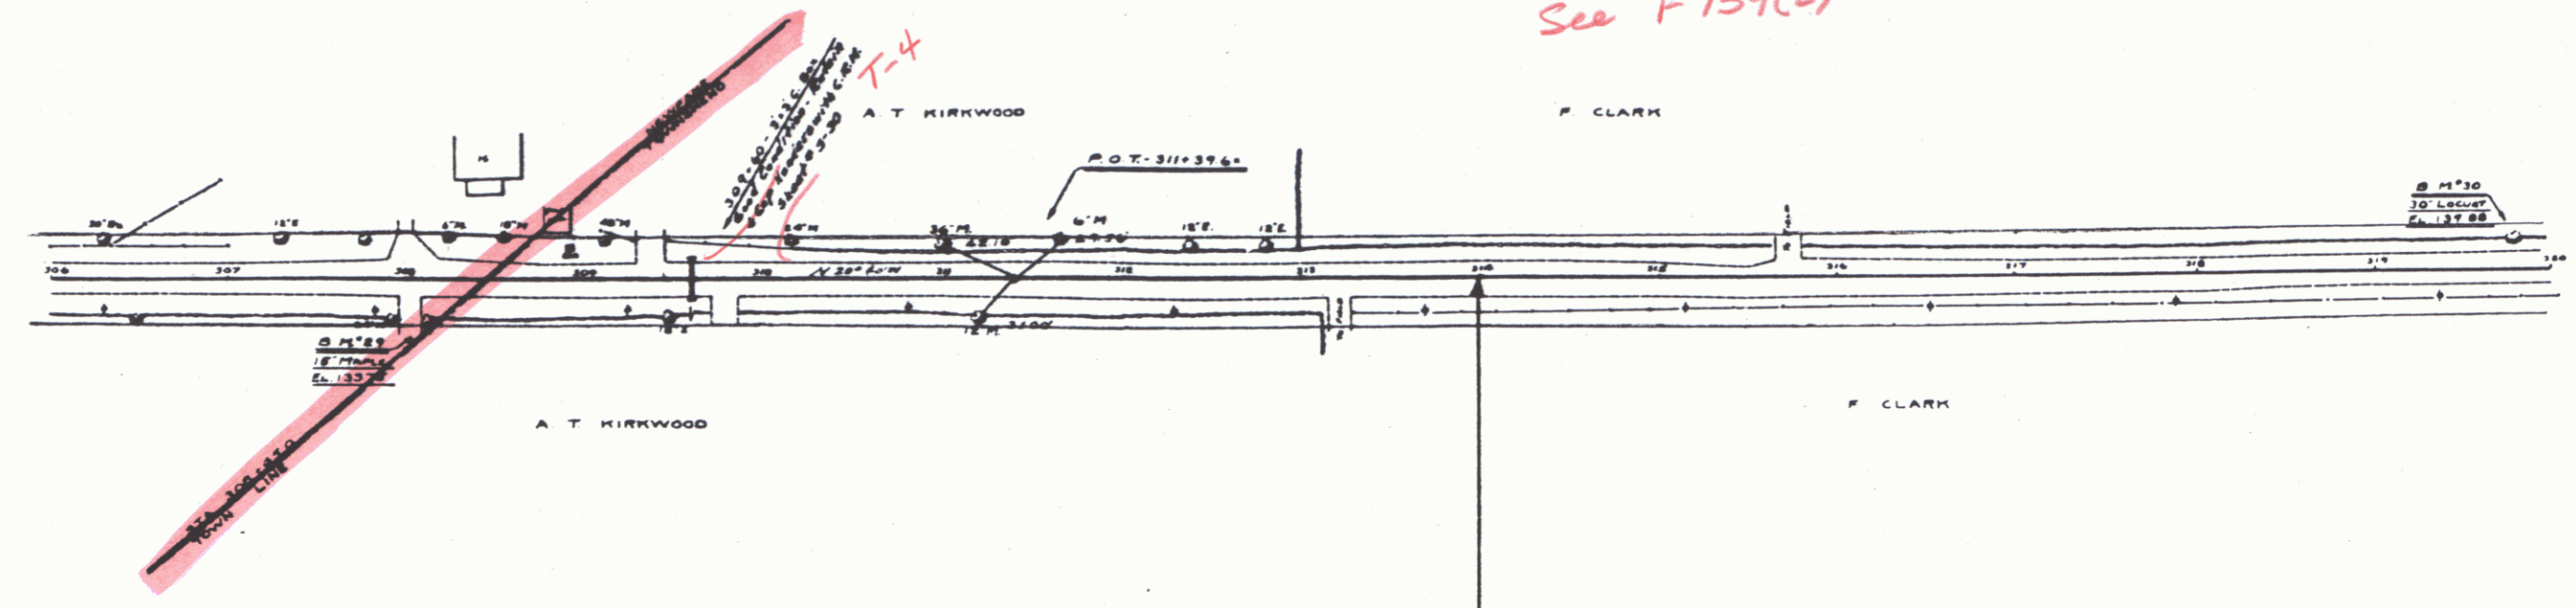

14