
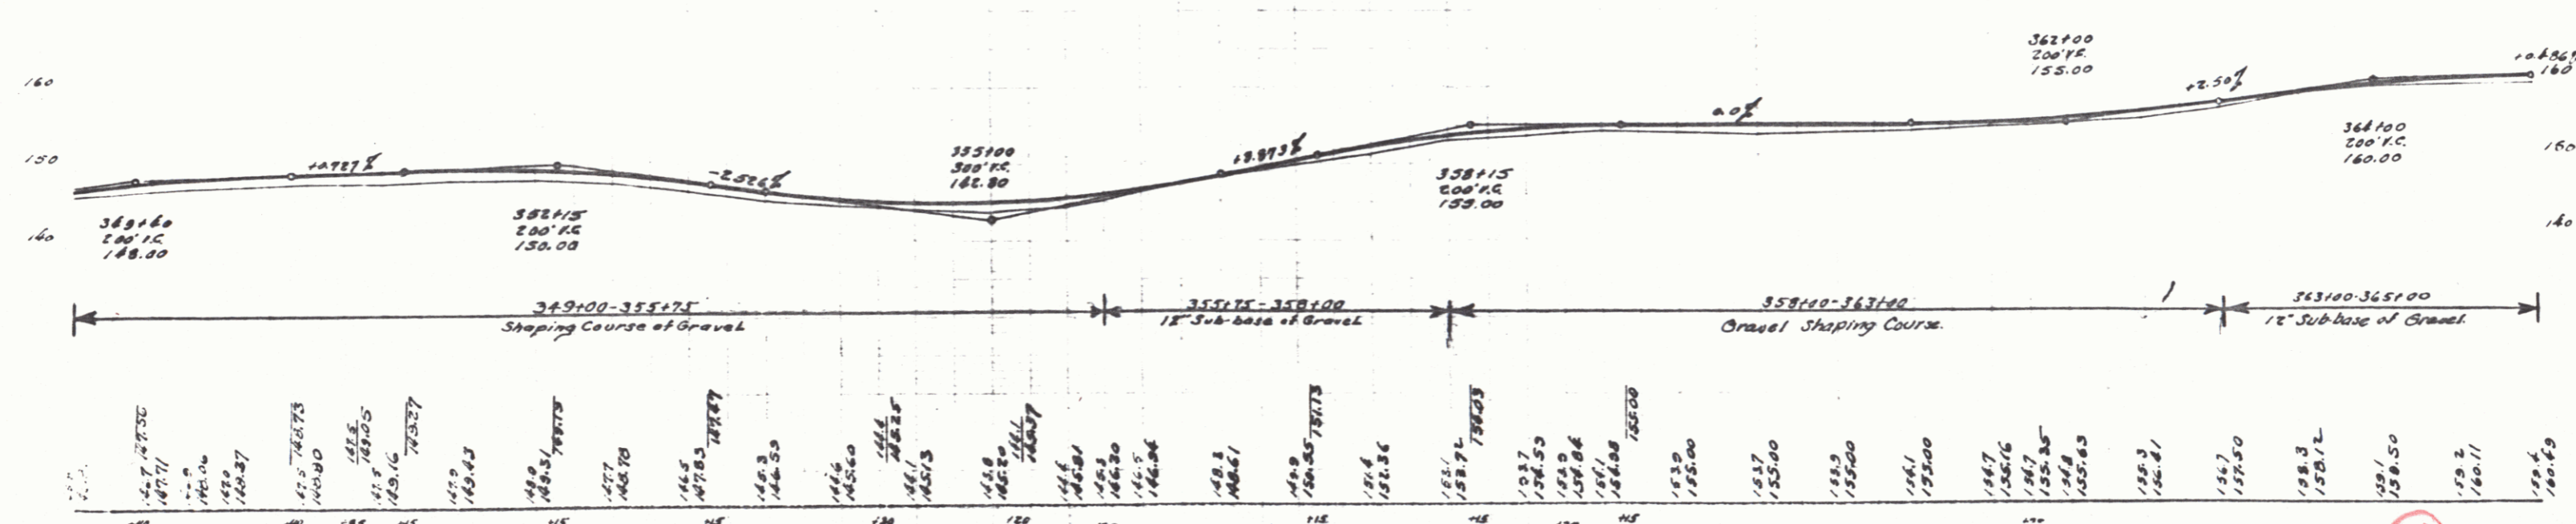


CUTMAN
BLISS
MAY 22
1938

M.P. 3
159 1933 17 77

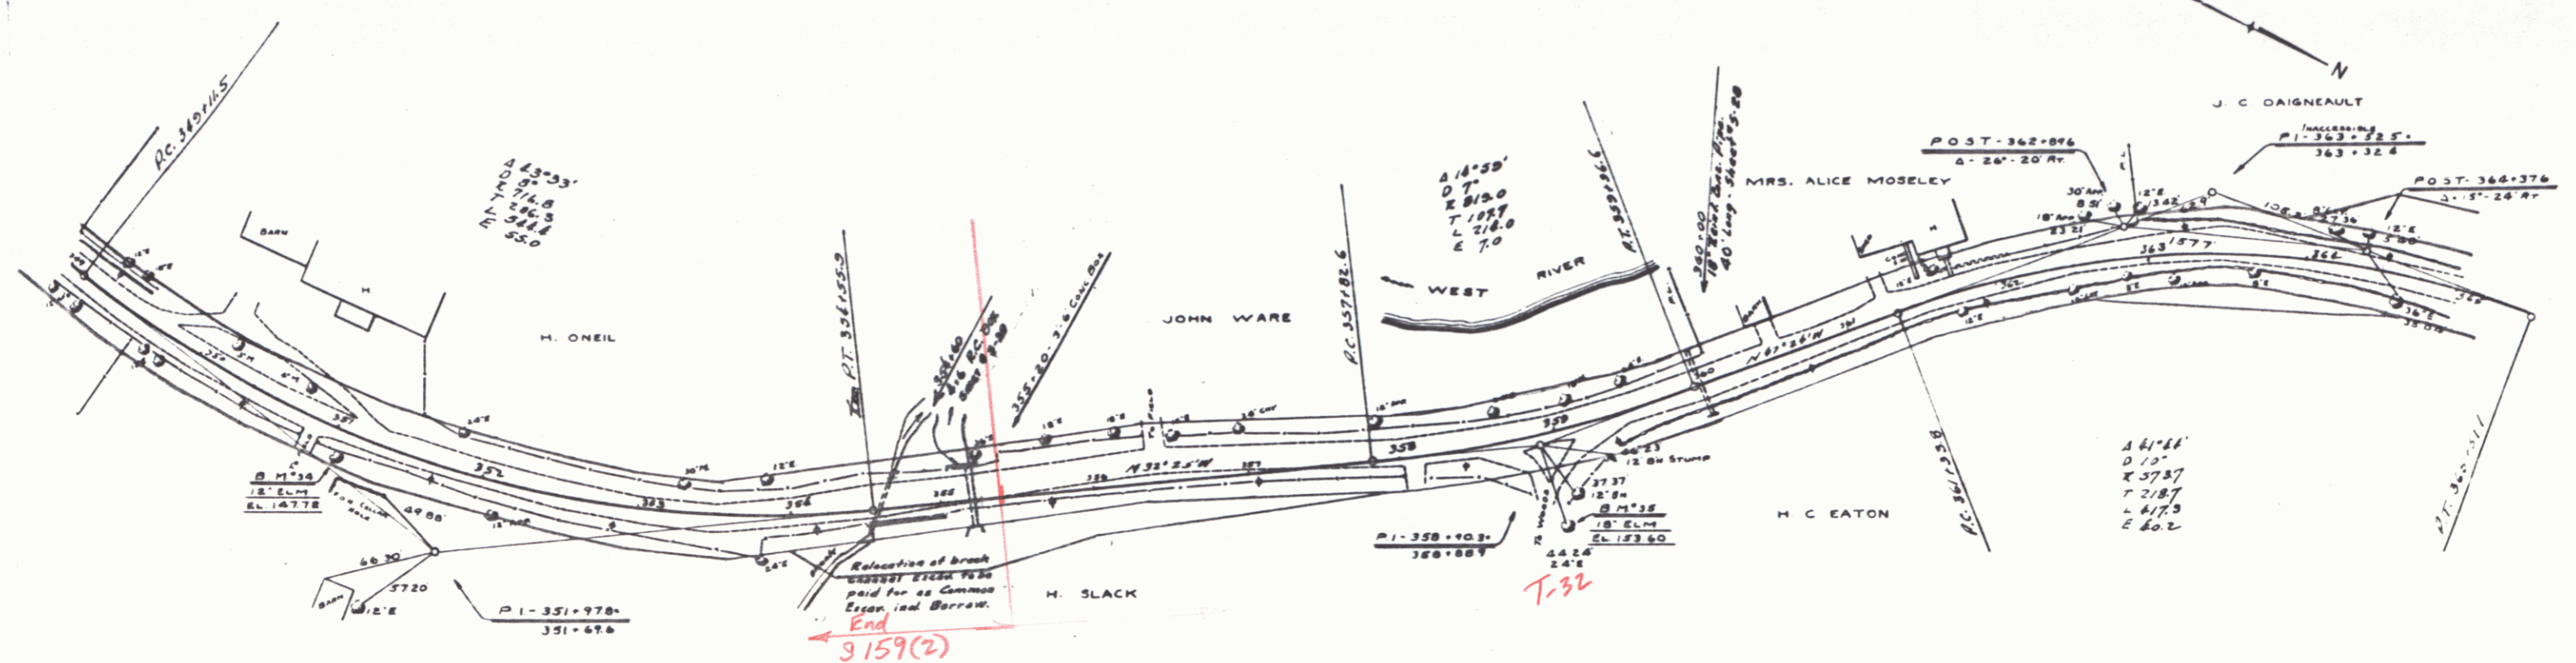

17