



FED. ROAD DIST. NO.	STATE	PROJ. NO.	SHEET NO.	TOTAL SHEETS
9	VT.			

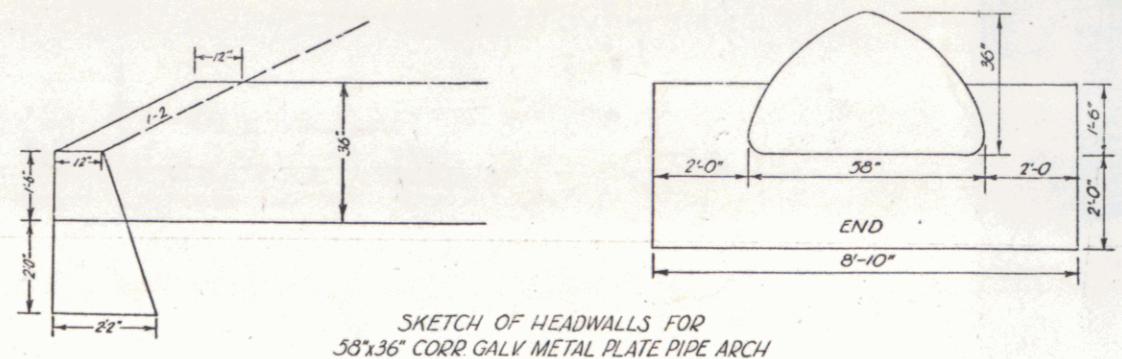

SKETCH OF HEADWALLS FOR
36" CORR GALV METAL PIPE ARCH
11+94

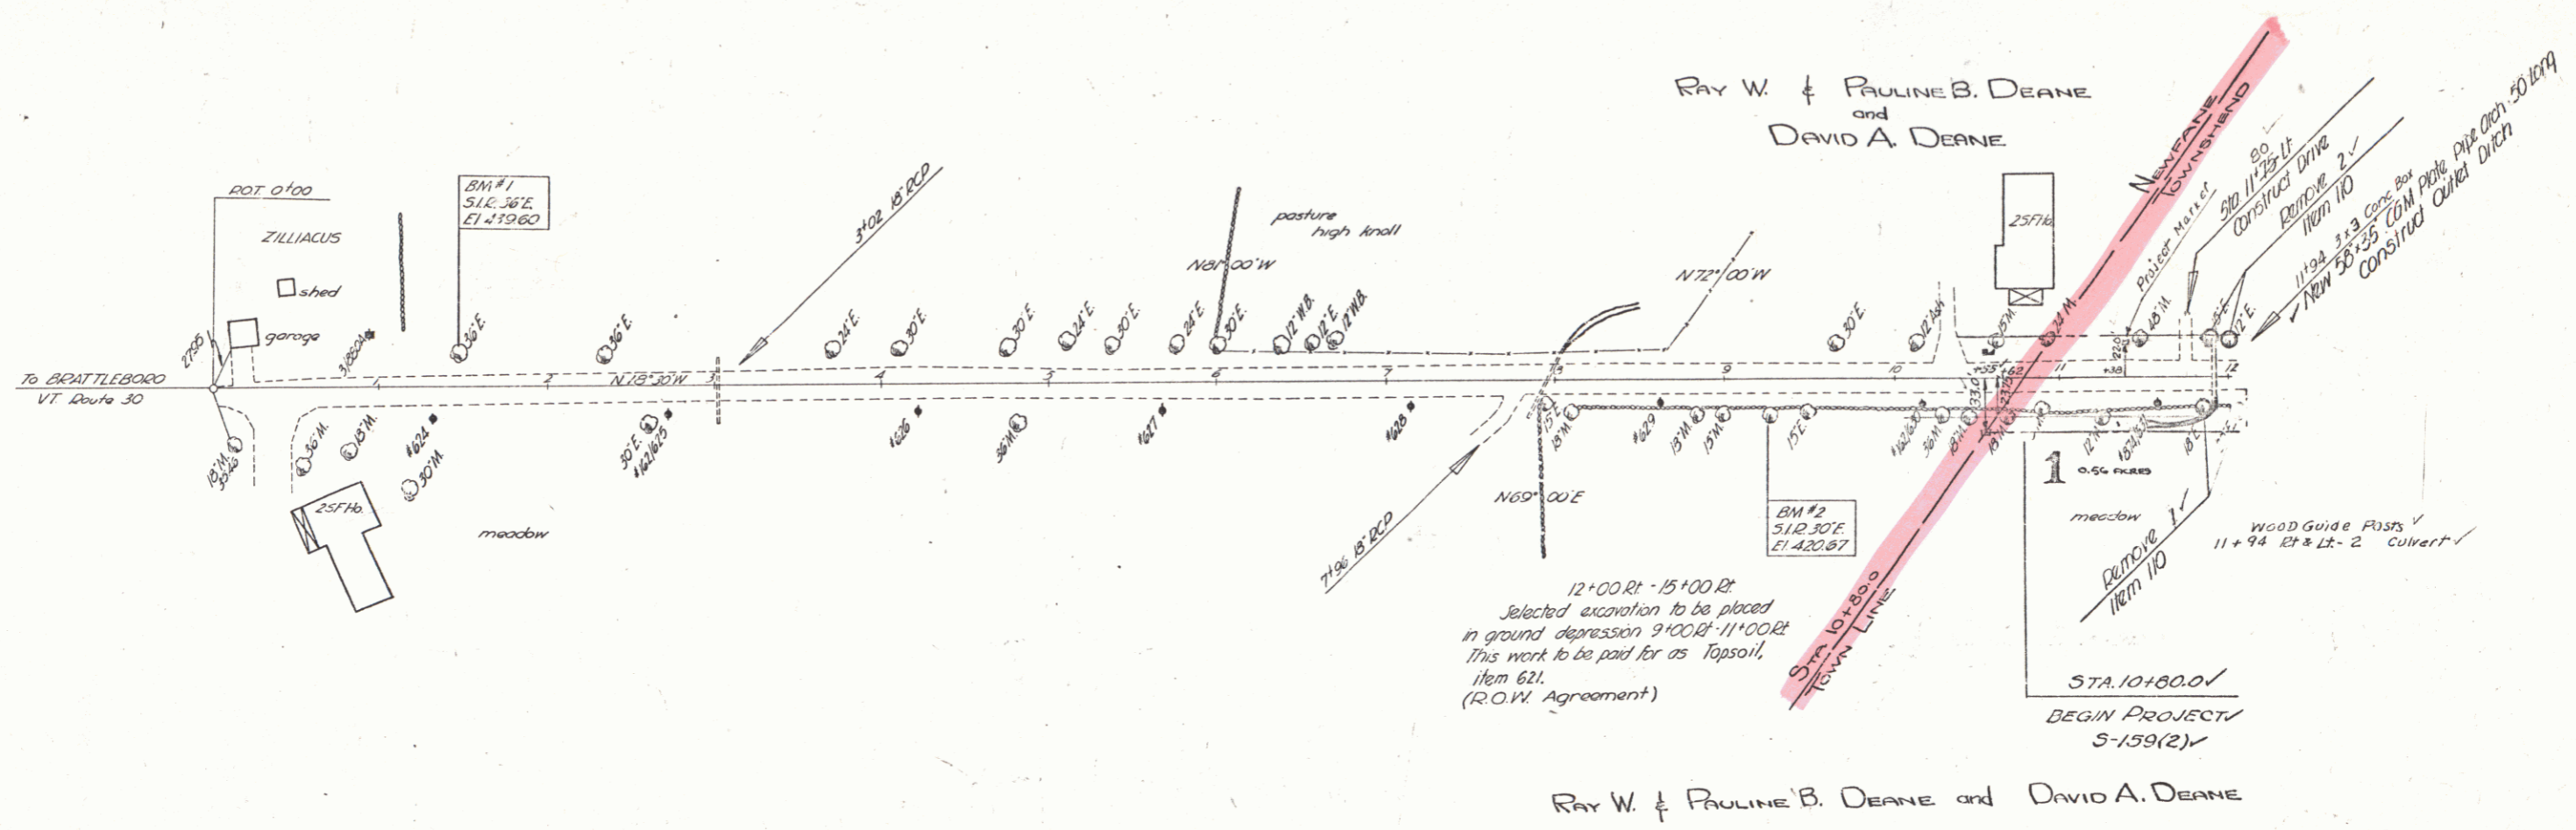

ESTIMATED QUANTITIES

--	--

NEWSPAPER - TOWNSEND

Surveyed by
Designed by
Drawn by NLS Jr
Checked by HAS
Checked by
Series S No. 159(2) Sheet 10 of 10