


PARCEL	INSTRUMENT	DATE	GRANTOR	GRANTEE	RECORDED	REMARKS
1	O.C.O.	6-36	MARY BELLINGER	J.F. V.	31	14-17 6-23-36 400+50

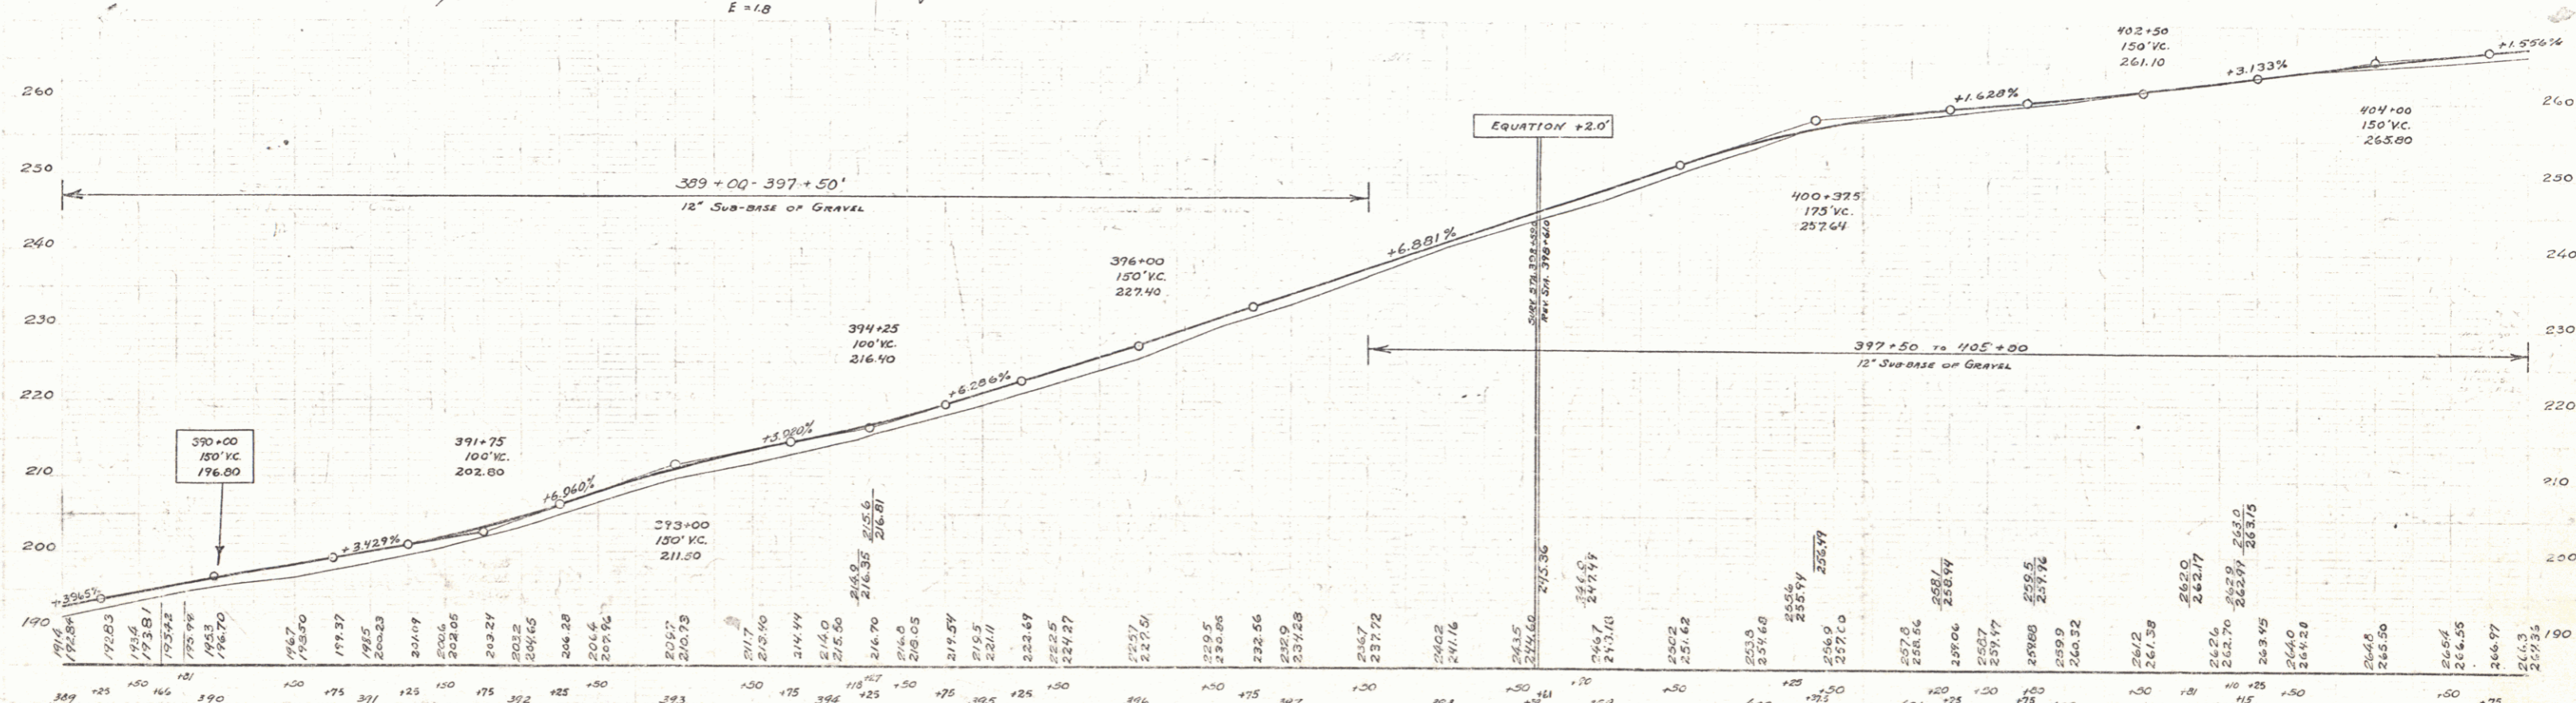

B.M. 139 SPIKE IN SIDE 12" ELM 15 FT. RIGHT 393+12 ELEV. 212.75
 B.M. 140 SPIKE IN ROOT 12" ELM 19 R. LEFT STA. 403+34 ELEV. 263.76

STATE
 139-L 1936 5 26
 CURVE #2
 Δ 5° 04' LT
 D 2'
 R 286.9
 T 126.7
 L 253.3
 E 2.8

REV. CURVE #2
 Δ 11° 39' LT
 D 3'
 R 1910
 T 144.3
 L 388.3
 E 7.4
 DO NOT BANK

B.M. #3
 12' ELM
 61 212.15
 Δ 6° 01' AT
 D = 4' 30"
 R = 1273.6
 T = 66.3'
 L = 133.7'
 E = 1.8