




Townsend
39

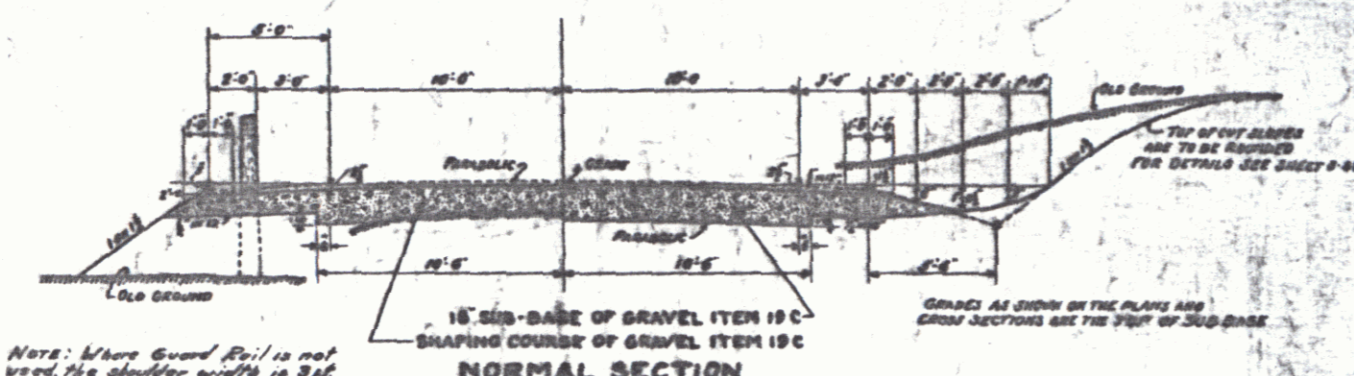

Note: Where Guard Rail is not used, the shoulder width is 3 ft.

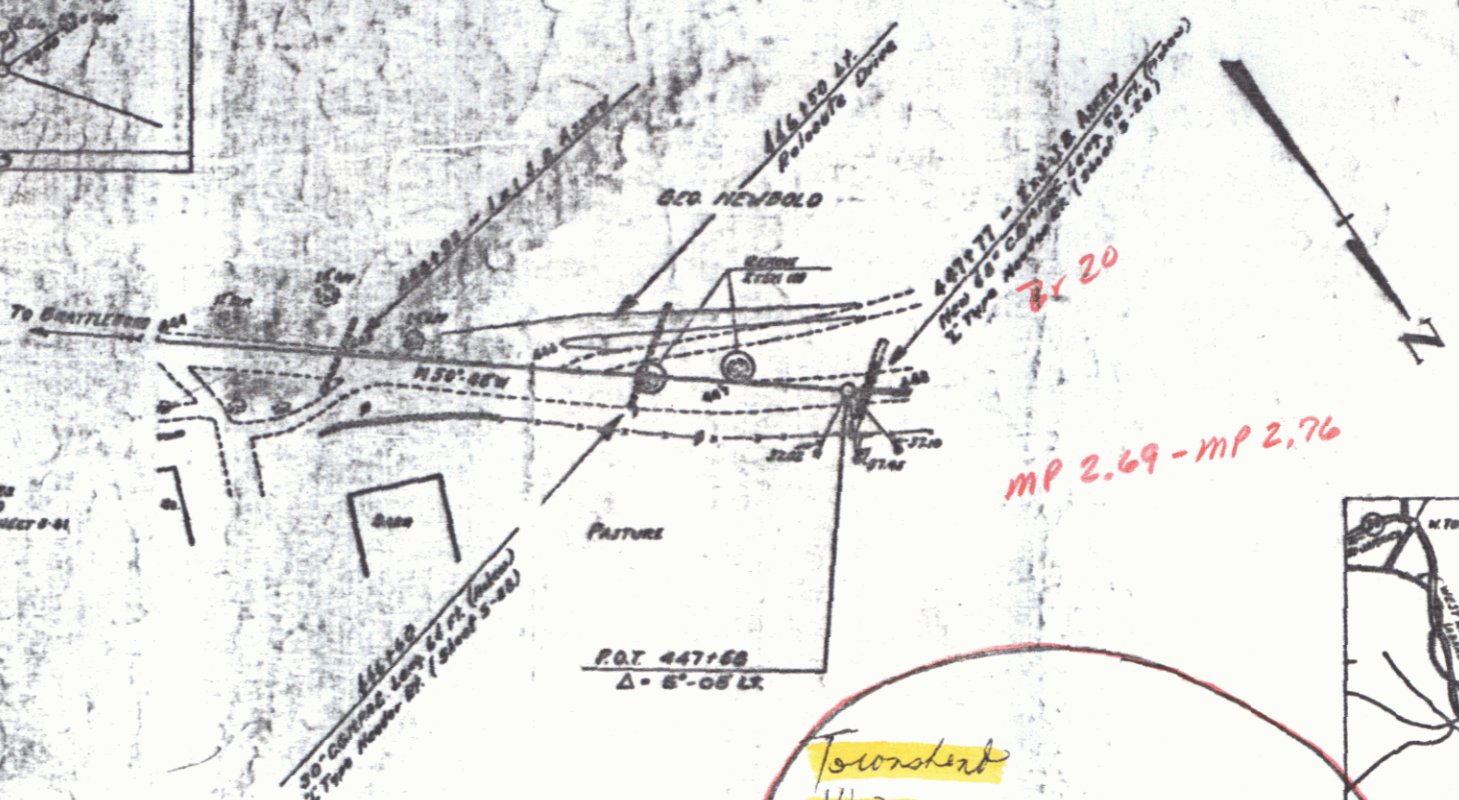

MP 2.69 - MP 2.76

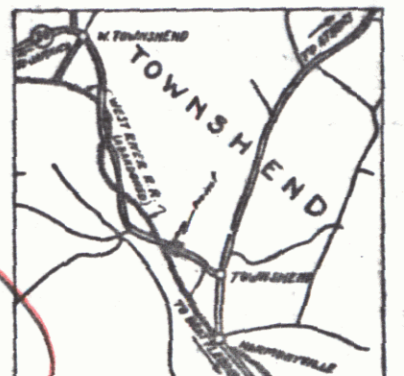


Townsend
Vt 30
Project PWA 1092-F-18
Pin Date 11/30/1938 00R357

SCALE 1" = 1 MILE
APPROVED 1938
Chief Highway Commissioner
CORRECT MAP 19 1938
A.D. Smith
Bridge Engineer
APPROVED 1938
The [Signature]
Commissioner of Highways

POOR ORIGINAL COPY

INDEX OF SHEETS

| SHEET NO. | DESCRIPTION |
|-----------|-----------------------------|
| 1, 2 | PLAN AND PROFILE |
| 3 | DETAILS OF BRIDGE STRUCTURE |
| 4 | DETAILS OF BRIDGE PAVEMENT |
| 5 | DETAILS OF BRIDGE CURBS |
| 6 | DETAILS OF BRIDGE GUTTERS |
| 7 | CROSS SECTION DETAILS |

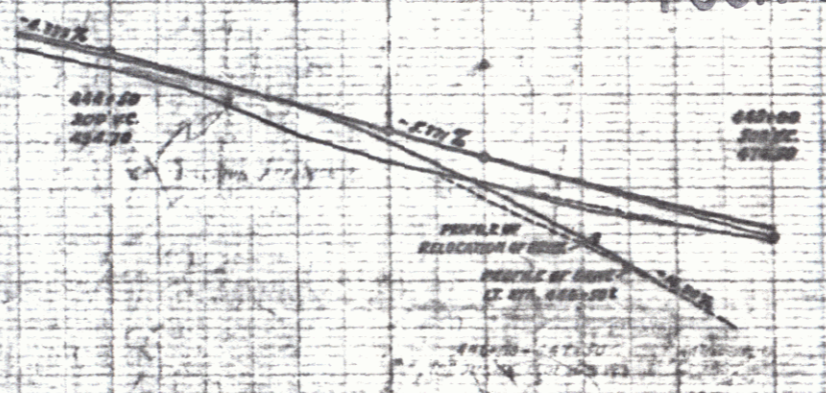

①