


$\Delta = 40^{\circ} 0' LT$   
 $D = 6'$   
 $R = 355.4$   
 $T = 347.7$   
 $L = 666.7$   
 $E = 61.3$

NOTE - Barrow for this Project is to be obtained from excavations to the roof line as shown on the cross-sections from Sta 448+00 - 450+00 (Sheet 7 of 8)

POOR ORIGINAL COPY

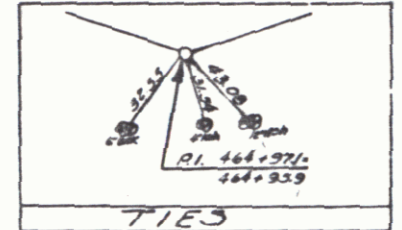

BRIDGE DATA	
TYPE	
OLD	NEW
Width	12'-0"
Height	12'-0"
Span	12'-0"
Abutment	12'-0"
Centerline	12'-0"
Clearance	12'-0"

Parcel	Instrument Date	Grator	Grantee	Recorded	Remarks
ABC	18.3.38	George Herbold	John	31 3078.9	17.39 Cd. 4301.25 9' x 16' 10"

2