


PARCEL	INSTRUMENT	DATE	GRANTOR	GRANTEE	RECORDED TOWNSHIP	REMARKS
A	VDGE	8-23-41	J.L. MCCORSON & BROTHERS	ST OF VT	BOOK 32 PAGE 51	10-24-41
A'	VDGE	11-1-41	FRED & EVELYN HOARD	ST OF VT	32 105-6	11-7-41
A' & C	VDGE	10-3-41	MRS. C. WATSON	ST OF VT	32 83-4-5	10-26-41 CURY @ 5.78 493.00 & 497.50

POOR ORIGINAL COPY

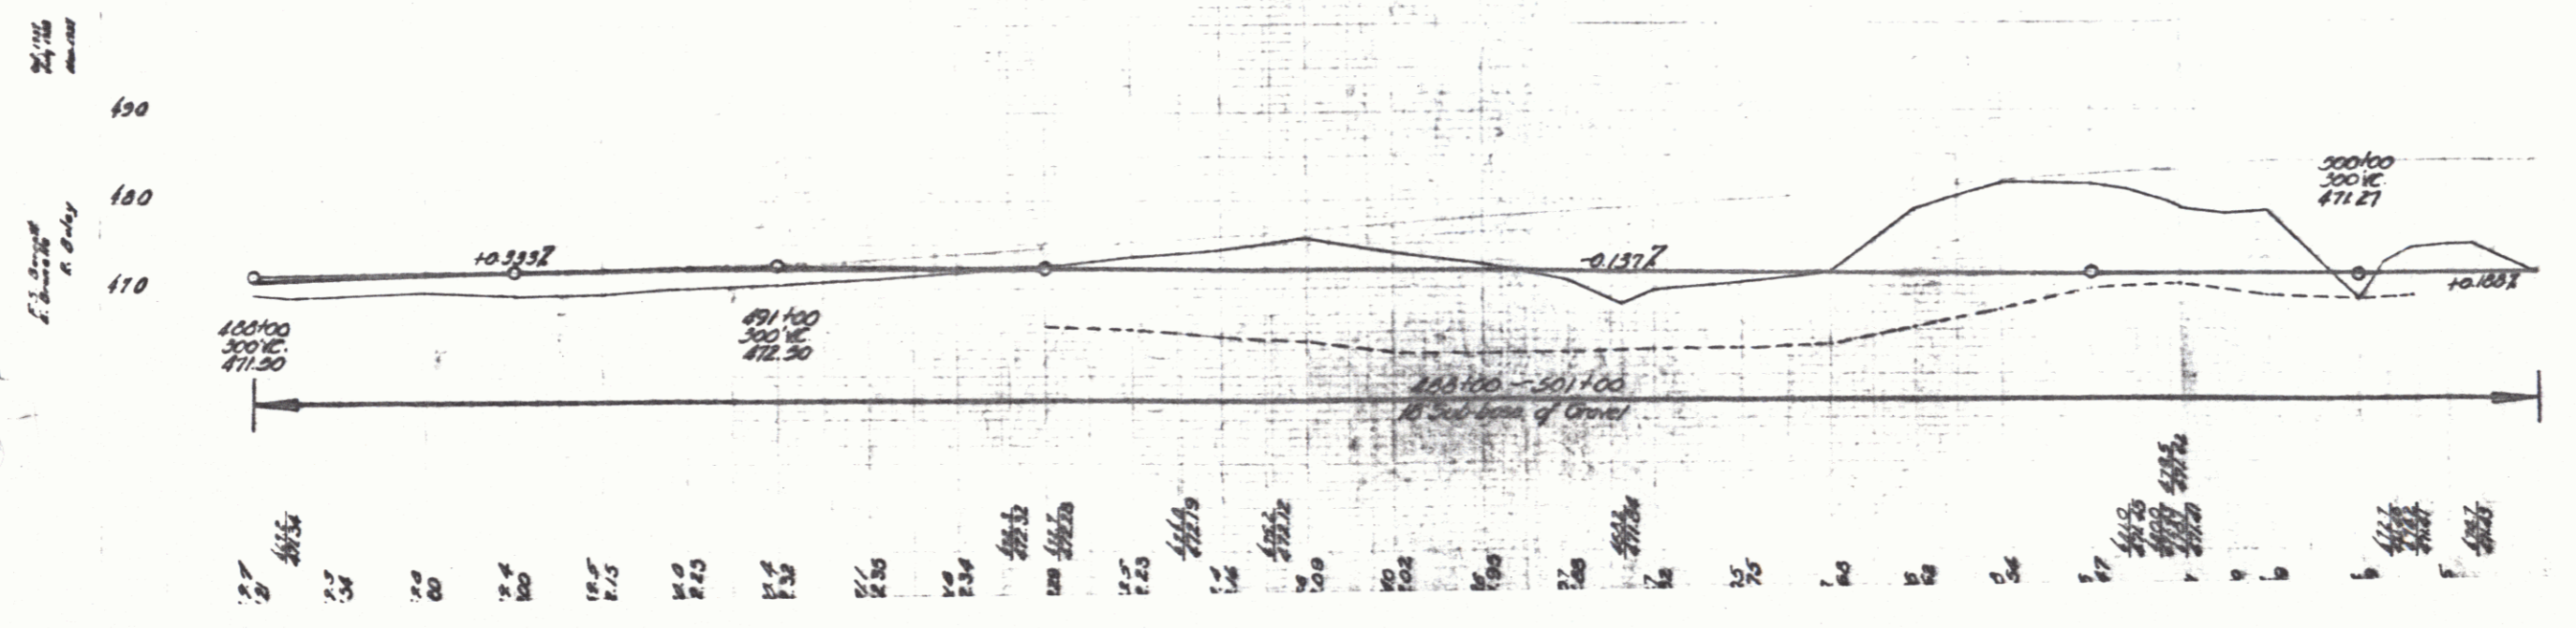

6

4