
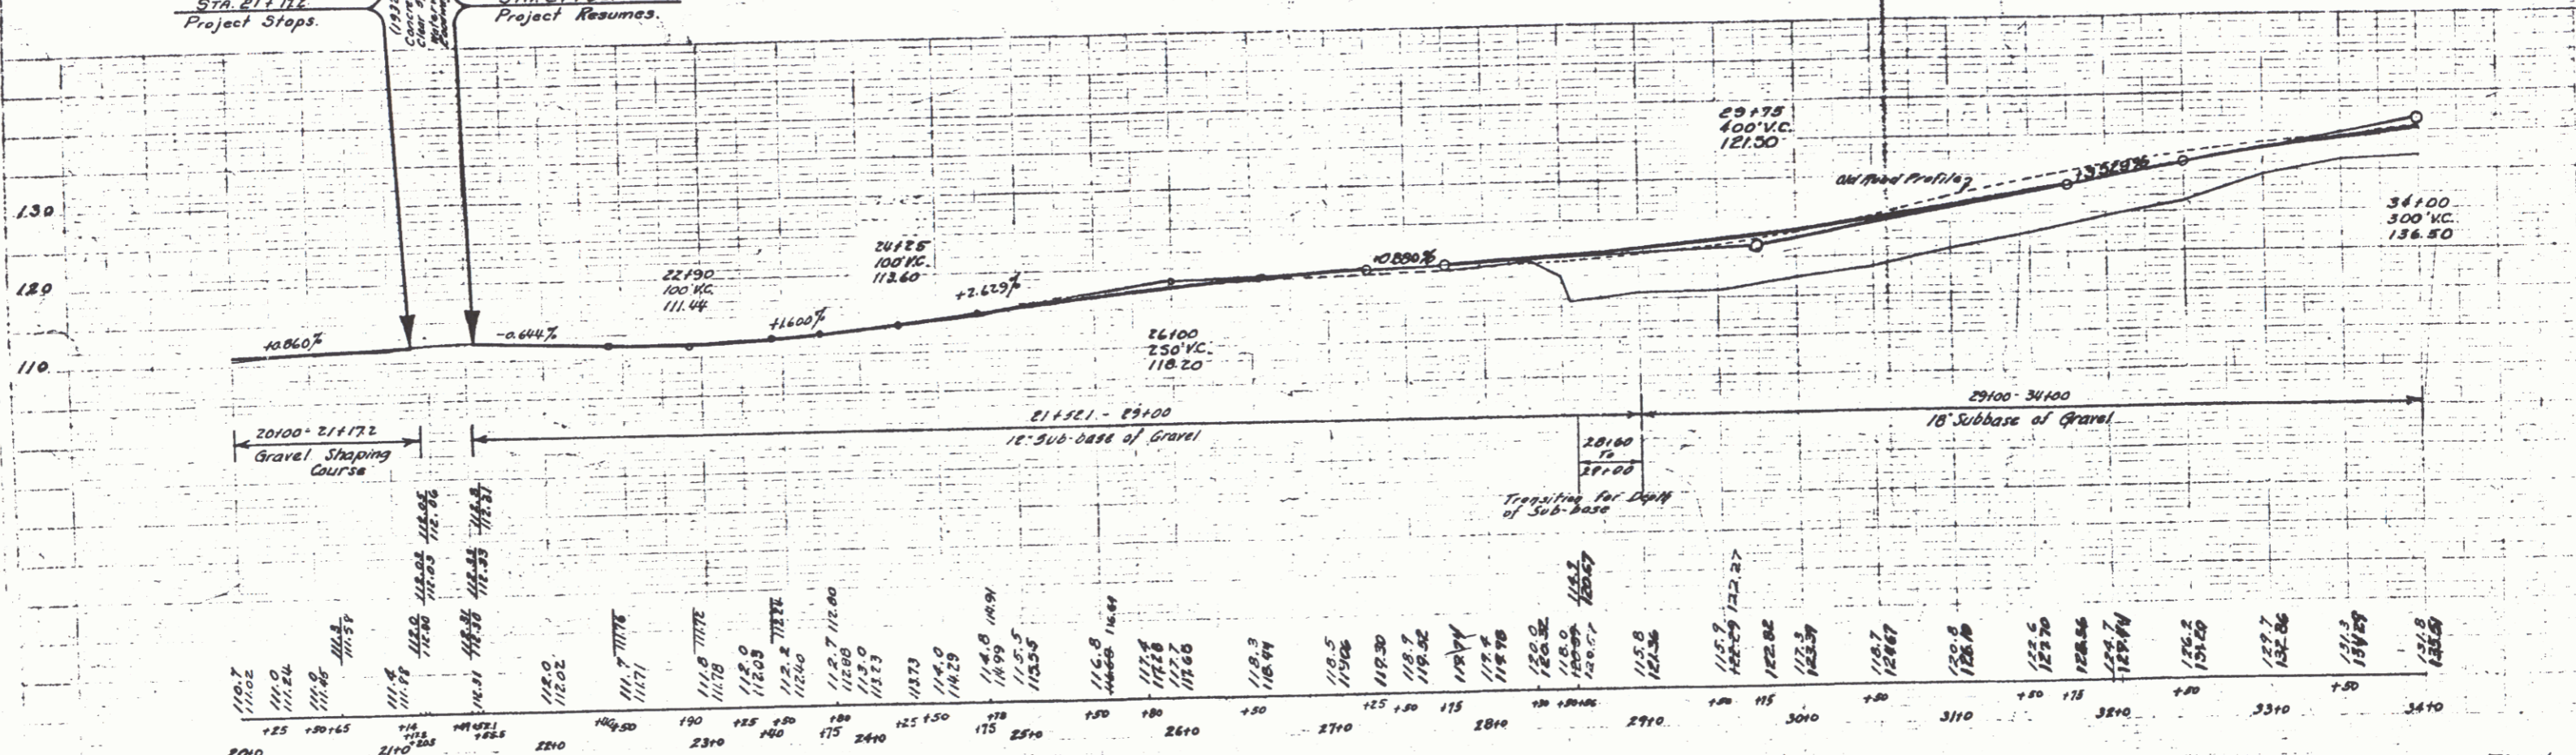


PARCEL INSTRUMENT DATE GRANTOR GRANTEE RECORDED REMARK
 A-B Q.C.D. 2-28-40 FRED G. STONE STA. 11. 20 282 3-2-40 2C.M.

FED. ROAD STATE FED. AID. DISCAL. SHEET TOTAL
 DIST. IN. 1118.0 1940 3 74

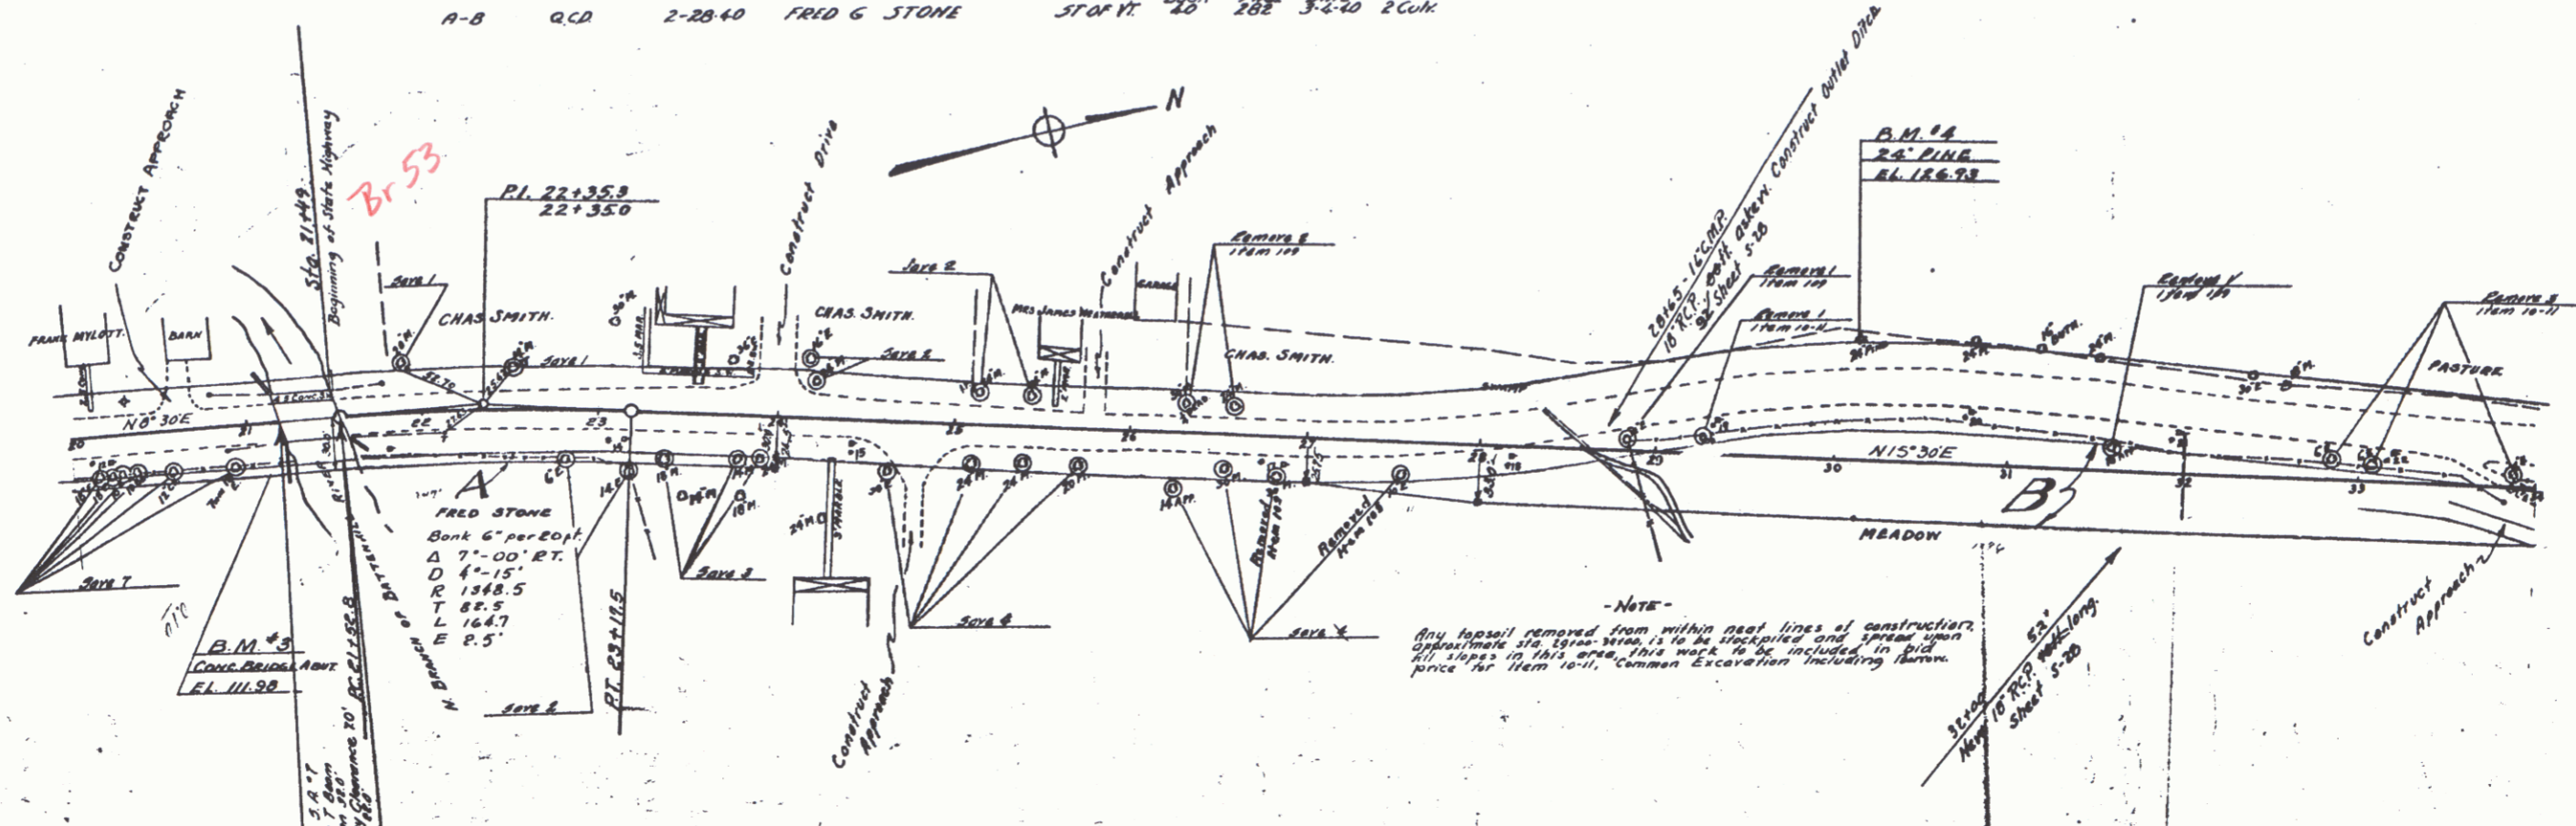

B.M. #3 SPOT ON CONC. BRIDGE ABUT. 11' RT. STA. 21+20 ELEV. 111.98
 B.M. #4 S.I.R. 24" PINE 67' LT. STA. 30+11 ELEV. 126.93

SERIES 745 No. 1113
 SHEET 3 OF 74