


PARCEL INSTRUMENT	DATE	GRANTOR	GRANTEE	RECORDED	REMARKS
C	OCD	2-28-60	C.H. ALLEN	ST 014	MANCHESTER PAGE 235 DATE 3-2-30

PLANNED STATE ROAD A. FISCAL SHEET NO. 11587 1940 9 74

Δ 80° 02' Lt.
 D 0° 30'
 E 674.7
 T 566.0
 L 941.6
 E 205.6

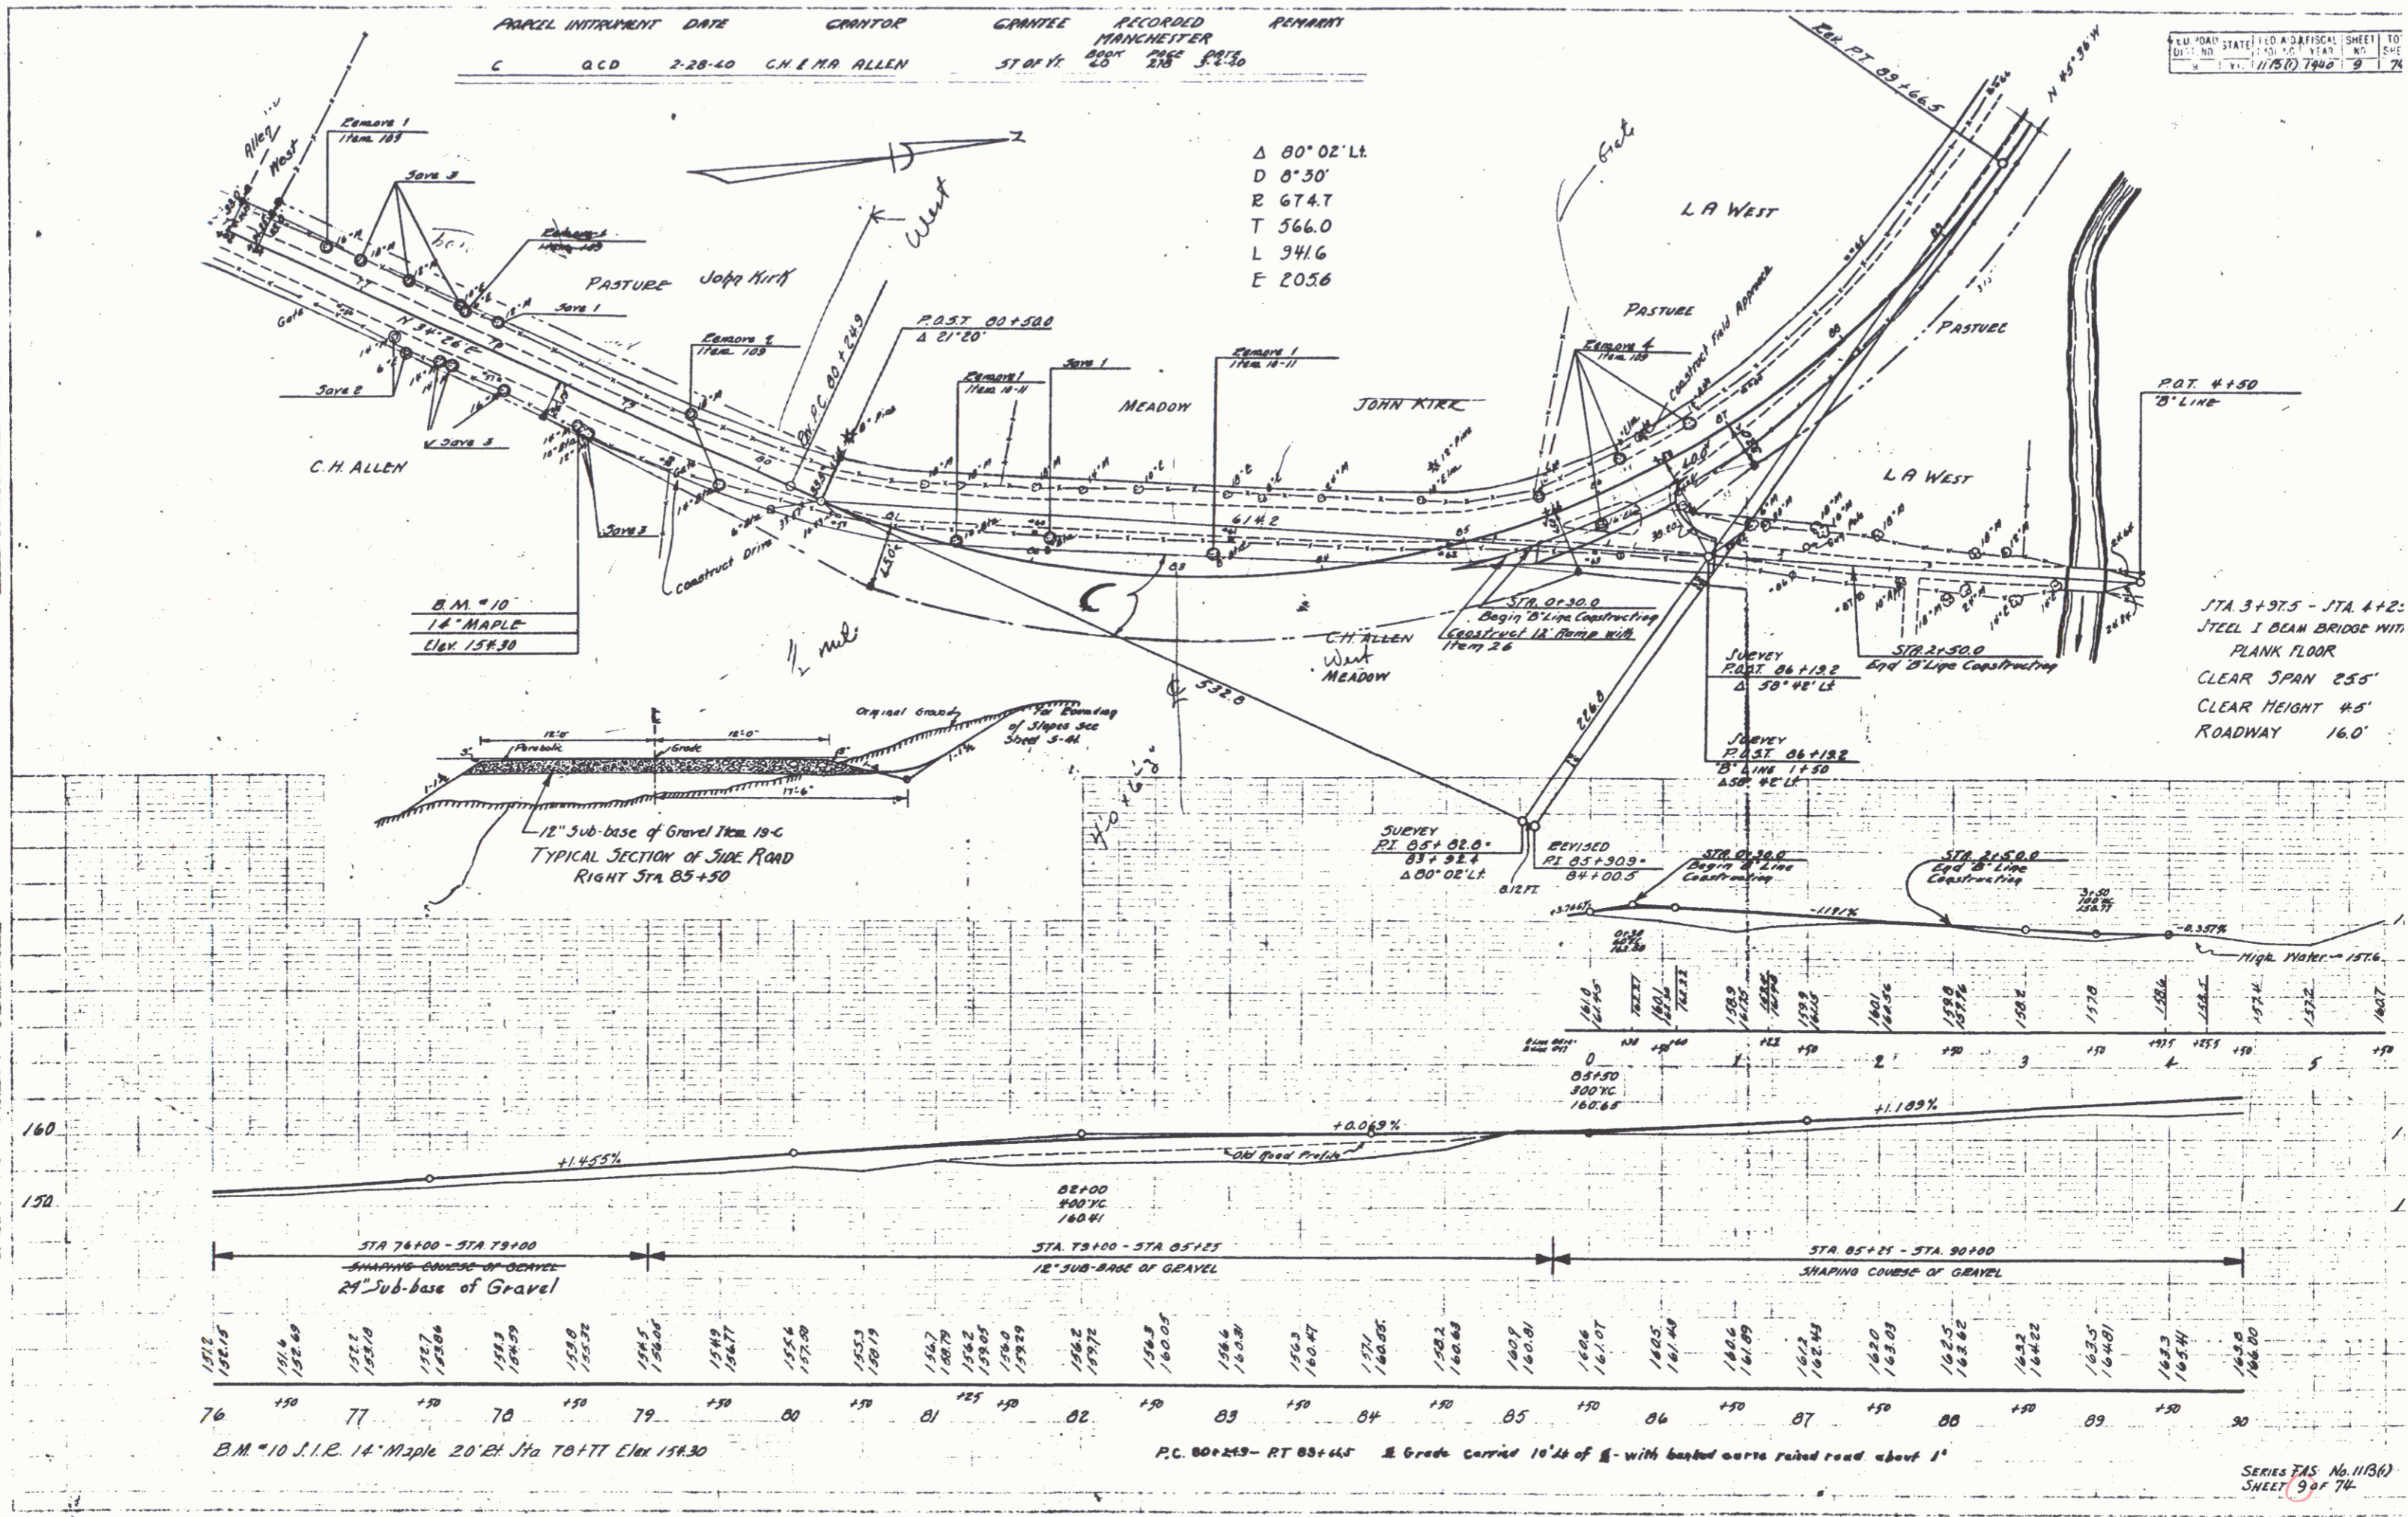

STA 3+97.5 - STA 4+2:
 STEEL I BEAM BRIDGE WITH
 PLANK FLOOR
 CLEAR SPAN 25'
 CLEAR HEIGHT 45'
 ROADWAY 16.0'

SERIES PAS No. 113(6) SHEET 9 of 74