
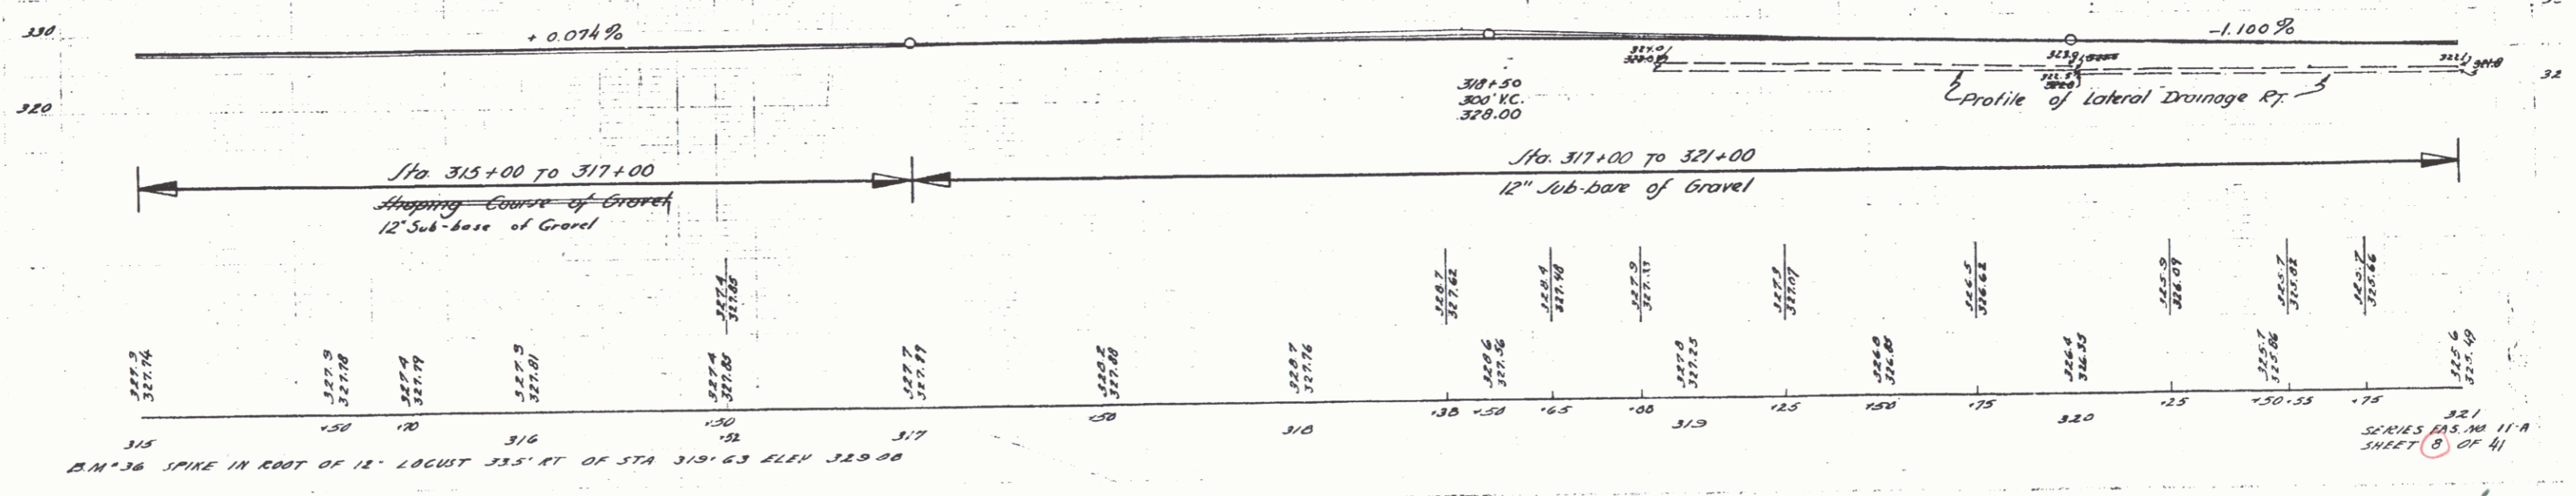


ELIZABETH  
GARHAET

F.S. BARRETT 017  
R.J. BALLEW 017

F.S. BARRETT 017  
R.J. BALLEW 017

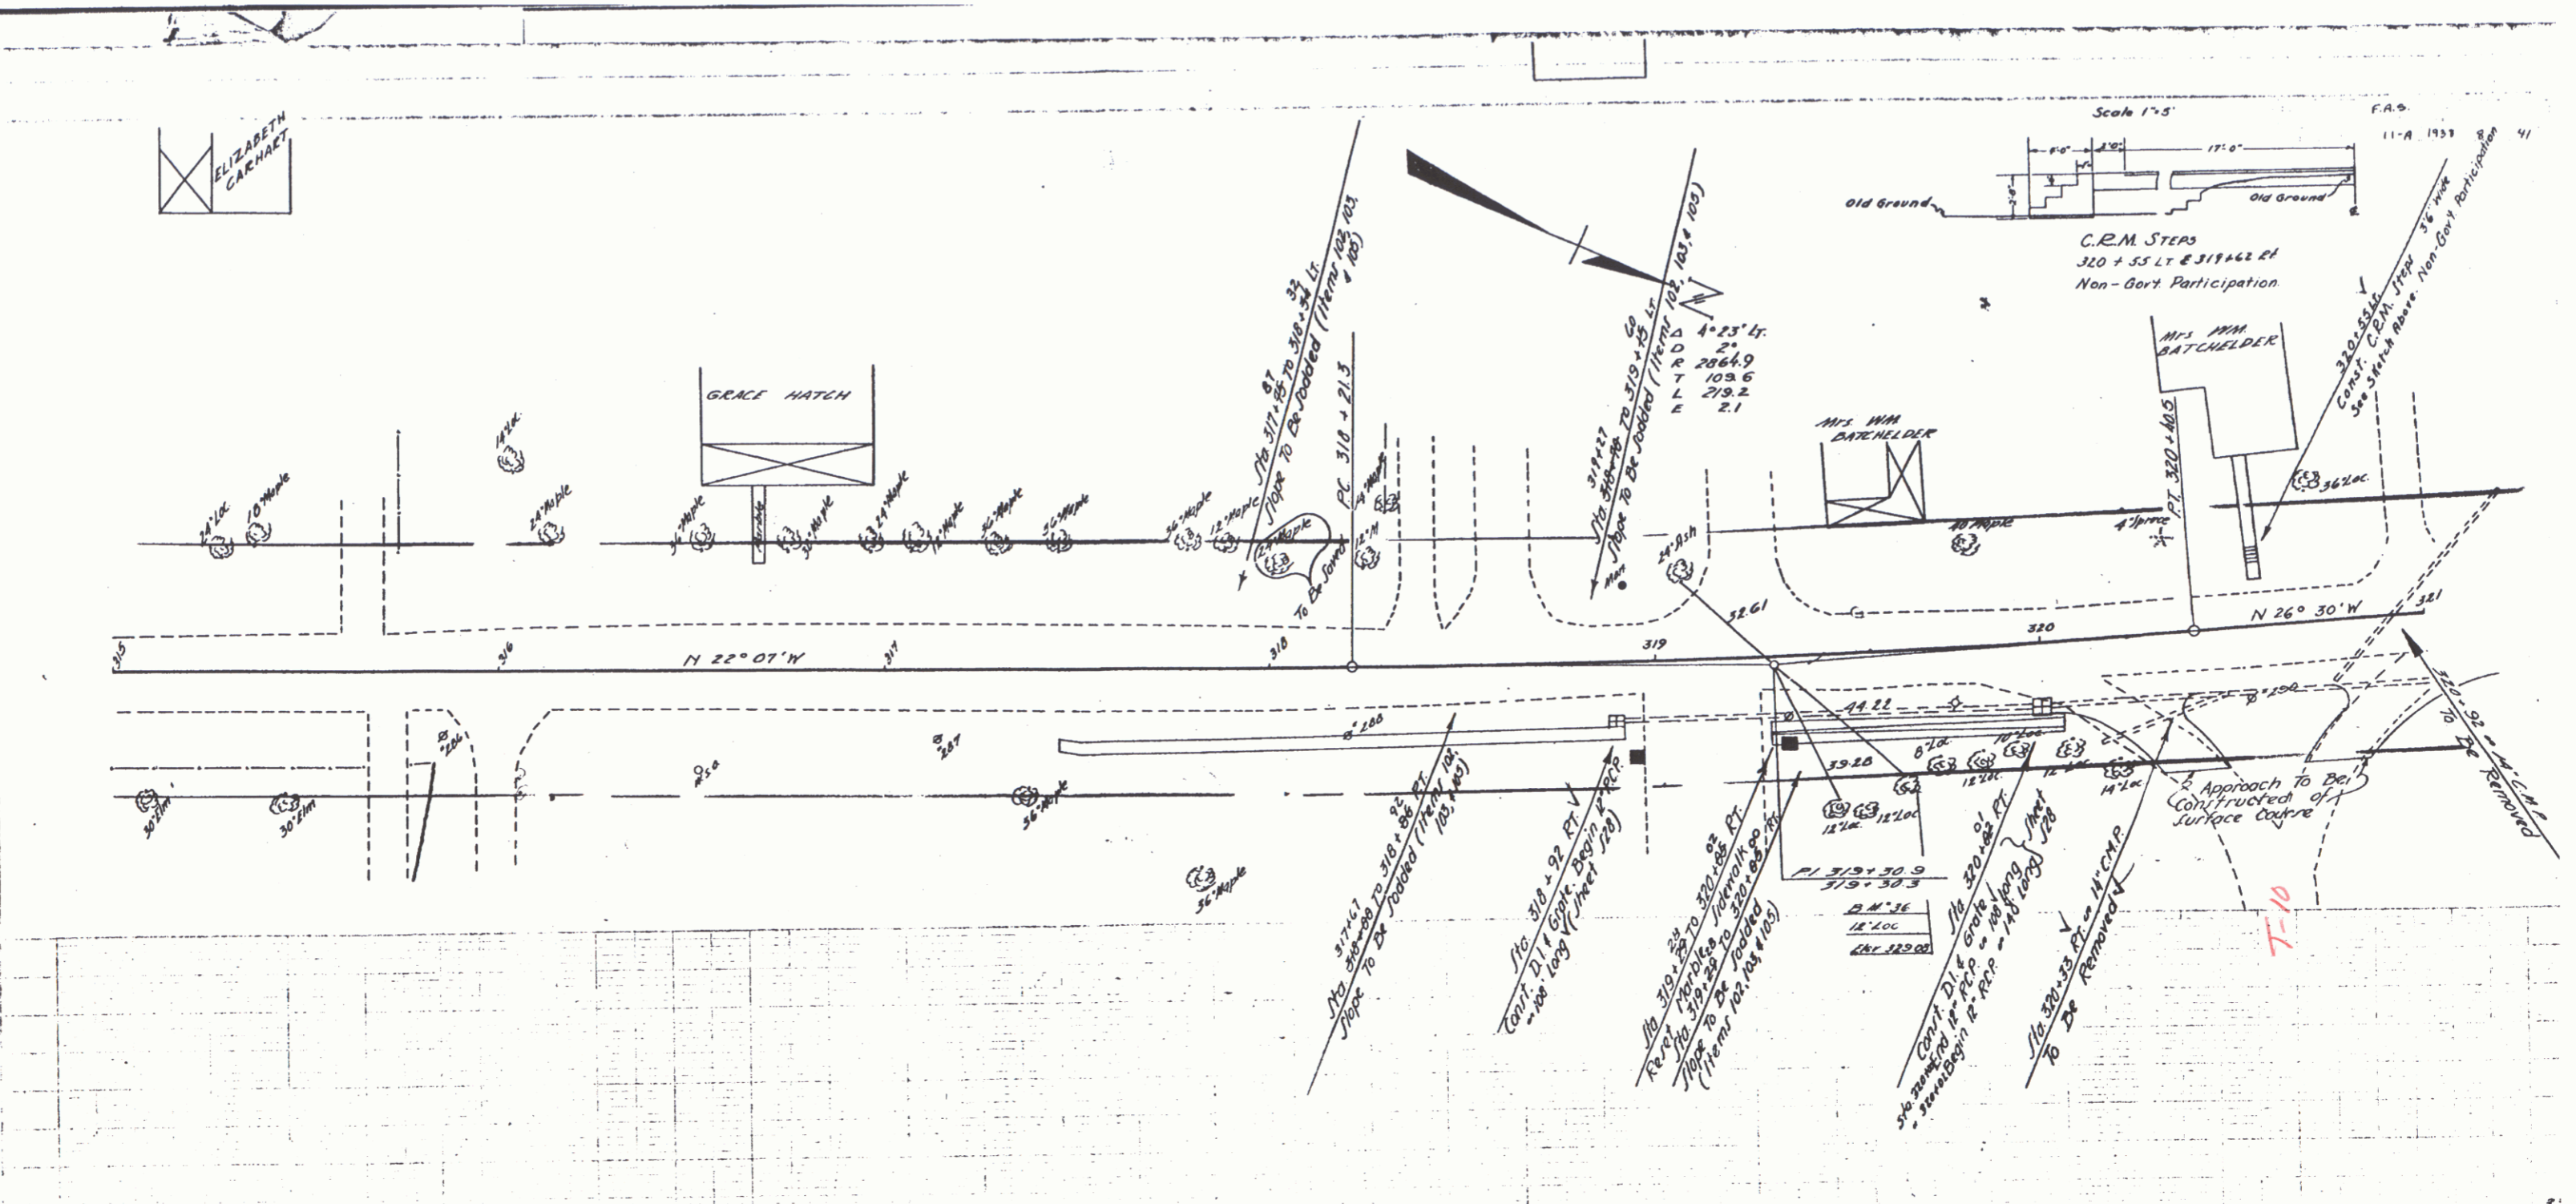

B.M. 36 SPIKE IN ROOT OF 12" LOCUST 335' RT OF STA 319+63 ELEV 329.08

SERIES PAS. NO. 11-A  
SHEET (8) OF 41