
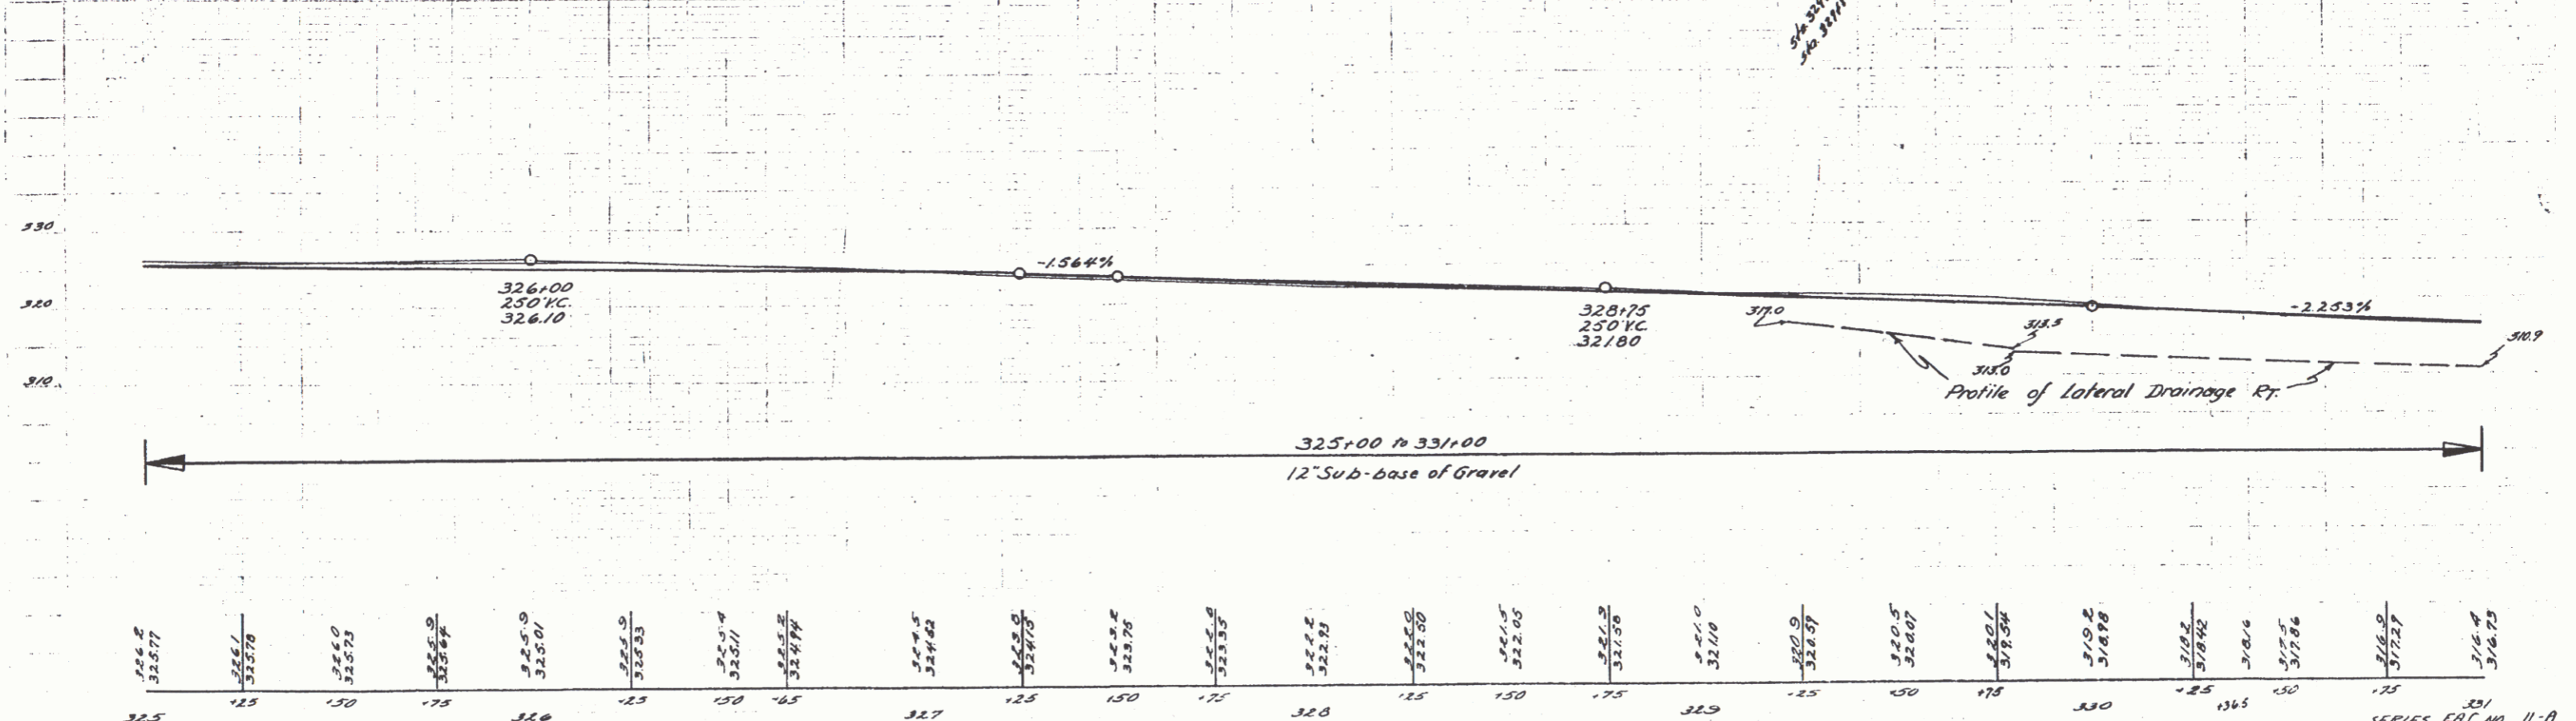


C.S. BARRETT
P.U. BAILEY 0137

C.S. BARRETT
P.U. BAILEY 0137

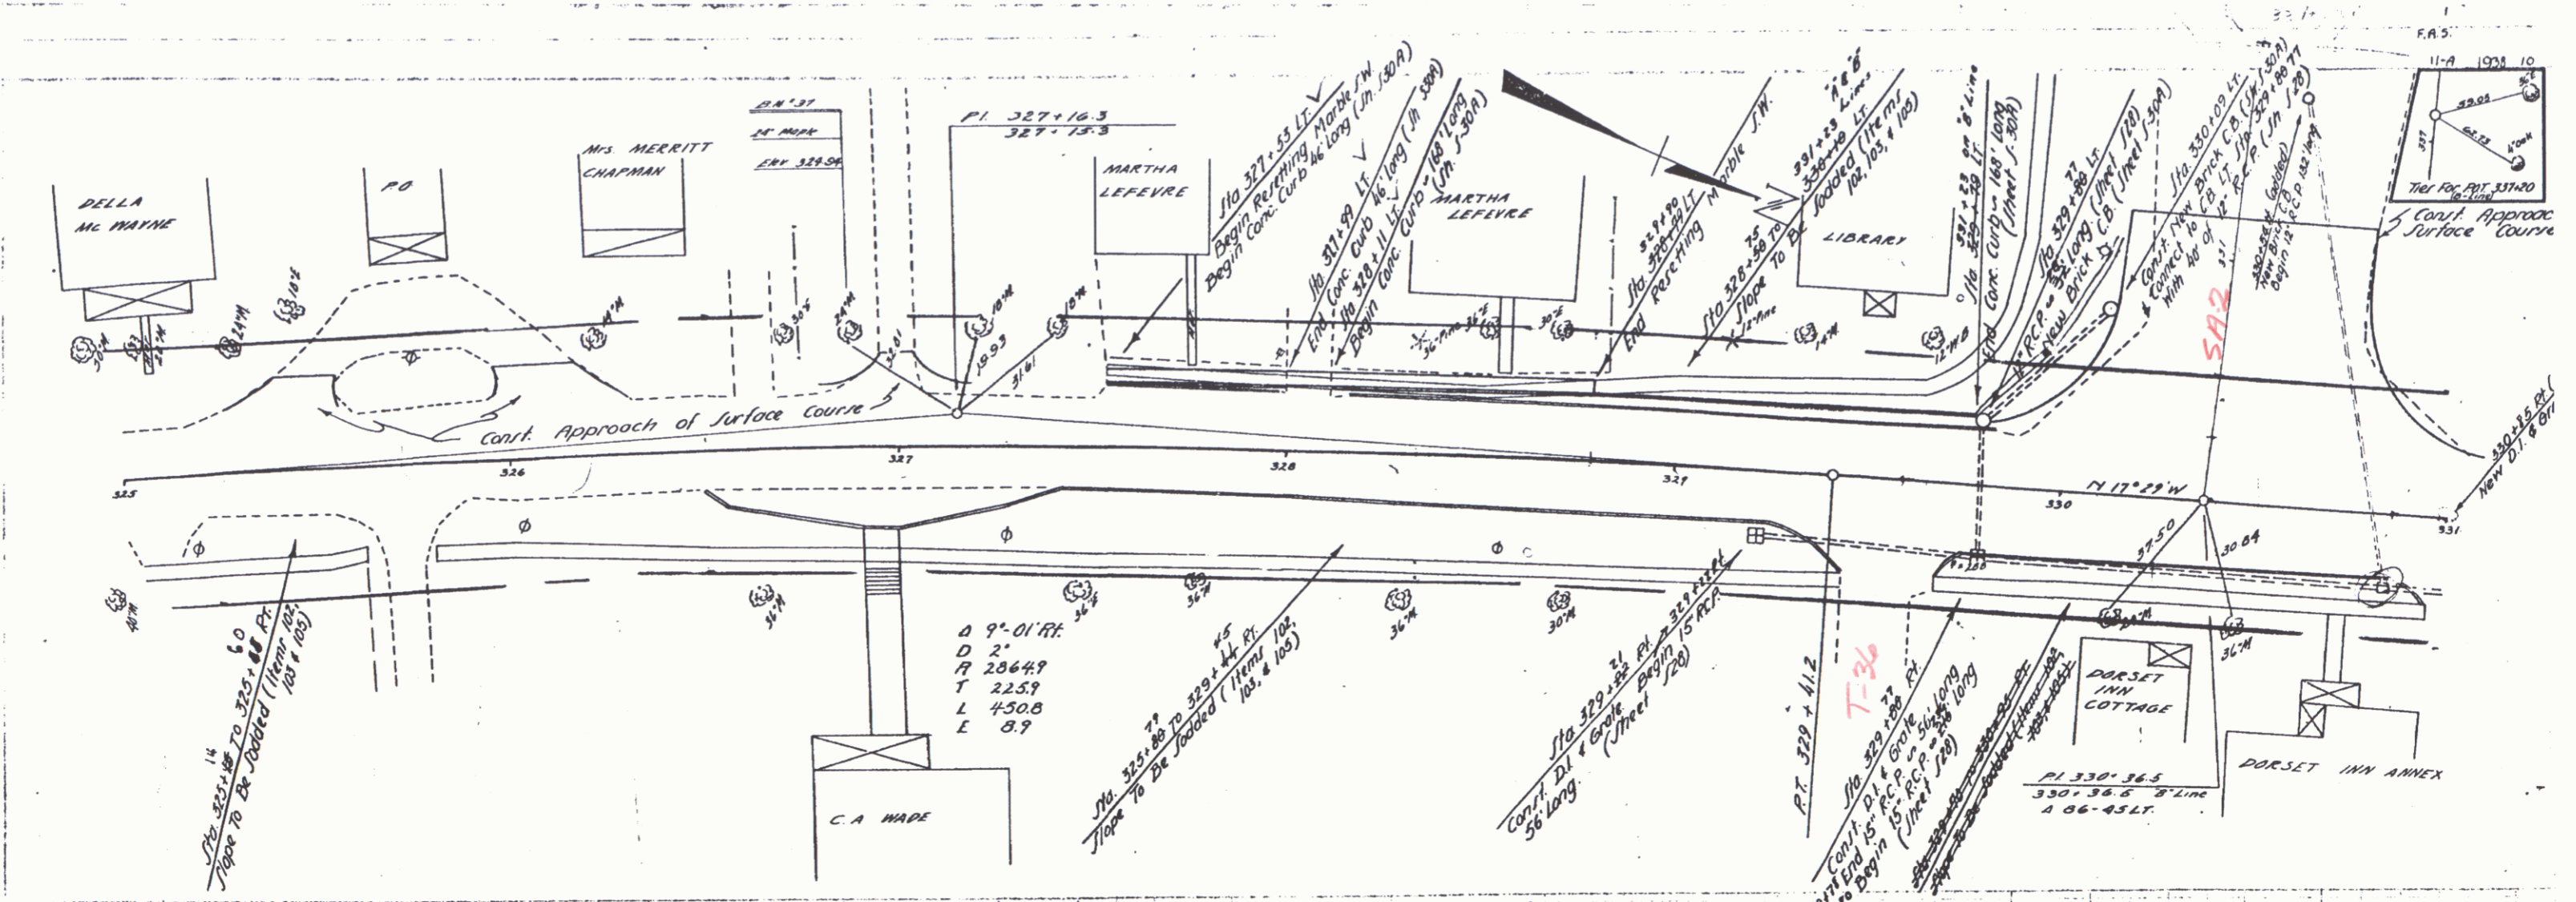

24" x 37" SPIKE IN ROOT OF 24" MAPLE 275' LT. OF STA. 326+00 ELEV. 324.94

SERIES ERT NO 11-A
SHEET 10 OF 41

80