


NOTE: DRAINAGE 338+25 - 339+64  
NON-GOV'T. PARTICIPATION

STA. 338+25  
END OF PROJECT  
F.A.S. 11-A  
mp 3.53

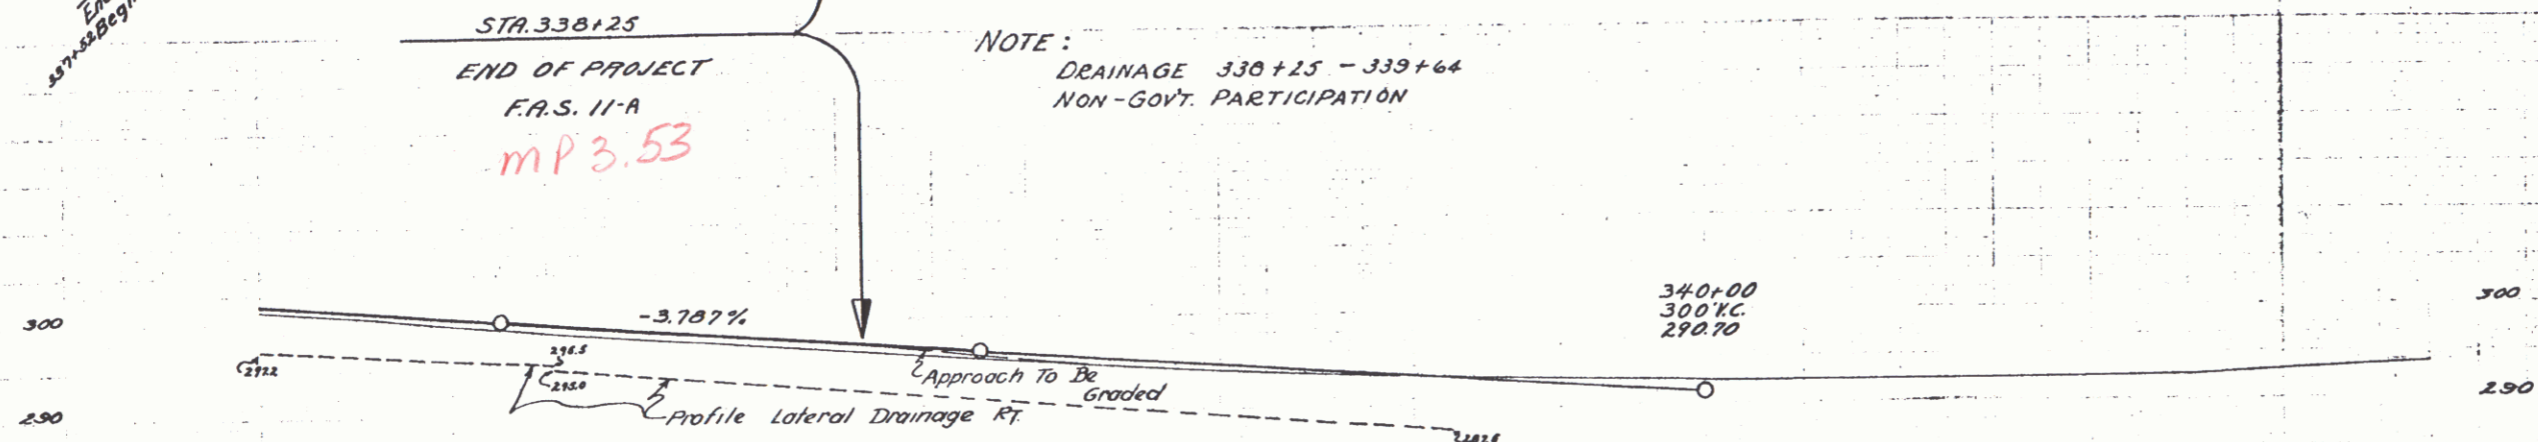

337+00 to 338+25  
Shaping Course of Gravel

337	337+25	338	338+25	339	339+50	340	340+50	341	341+50
291.5	290.7	290.4	290.7	290.9	291.5	291.6	291.5	292.4	292.6
301.98	301.01	300.17	300.27	299.7	299.5	299.6	299.5	299.4	299.0

B.M. 40 SPIKE IN ROOT OF 18" MAPLE 27' RT OF STA 341+05 ELEV 292.34