


MP Dorset 437-5.23
Rupert 0.00-0.45

RIGHT-OF-WAY DIVISION
TOWN FILE
PERPETUAL

Rte. VT 30
Town of VT 30
(To Be Returned To R.O.W. Division)

TOWNS OF
DORSET-RUPERT
Project 1938
Pin # COR363
Route VT30
Date 3/1/1938

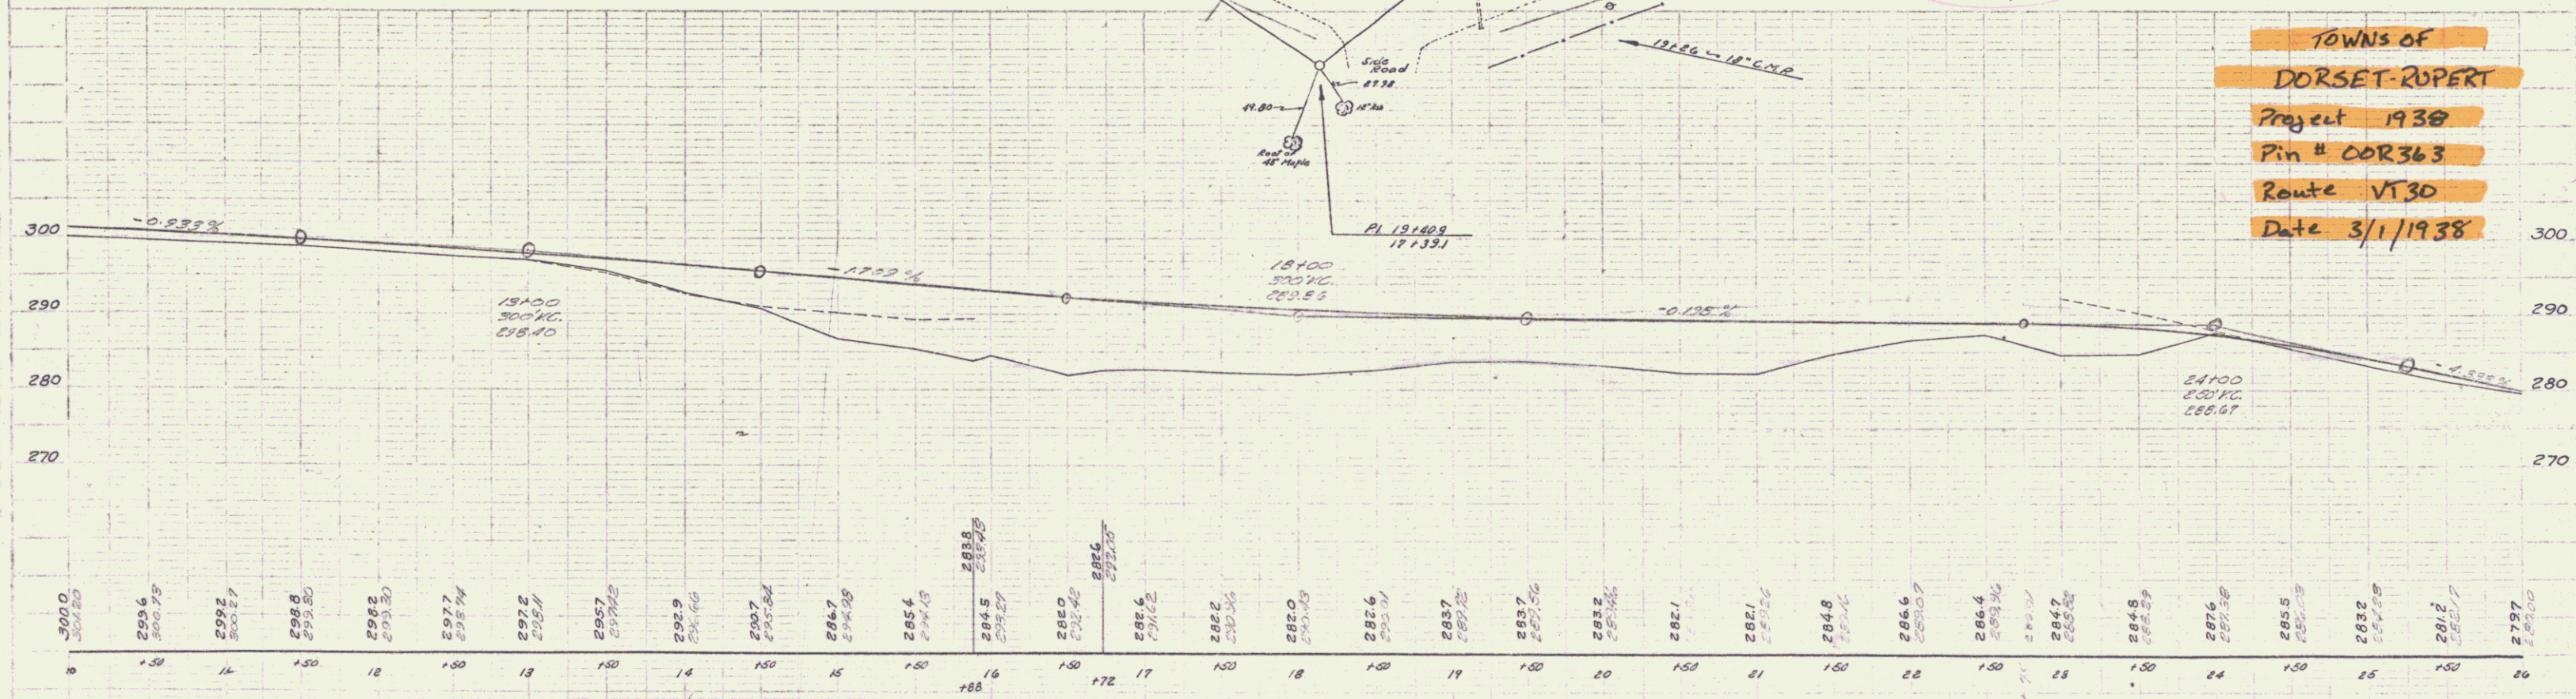

B.M.#1 SPOT ON 2000' HIGH 1278 62' HIGH CLARKWOOD
B.M.#2 SPOT ON CULVERT 33' BY 15" 15' CLARKWOOD
B.M.#3 SPINE IN TRUNK 24' 10" 12' 11" 15175 CULVERT

DORSET
30110
Sheet 1 of 1