


1972  
 SHEET  
 4  
 DATE  
 DRAWN BY  
 CHECKED BY  
 TITLE  
 PROJECT  
 NO.

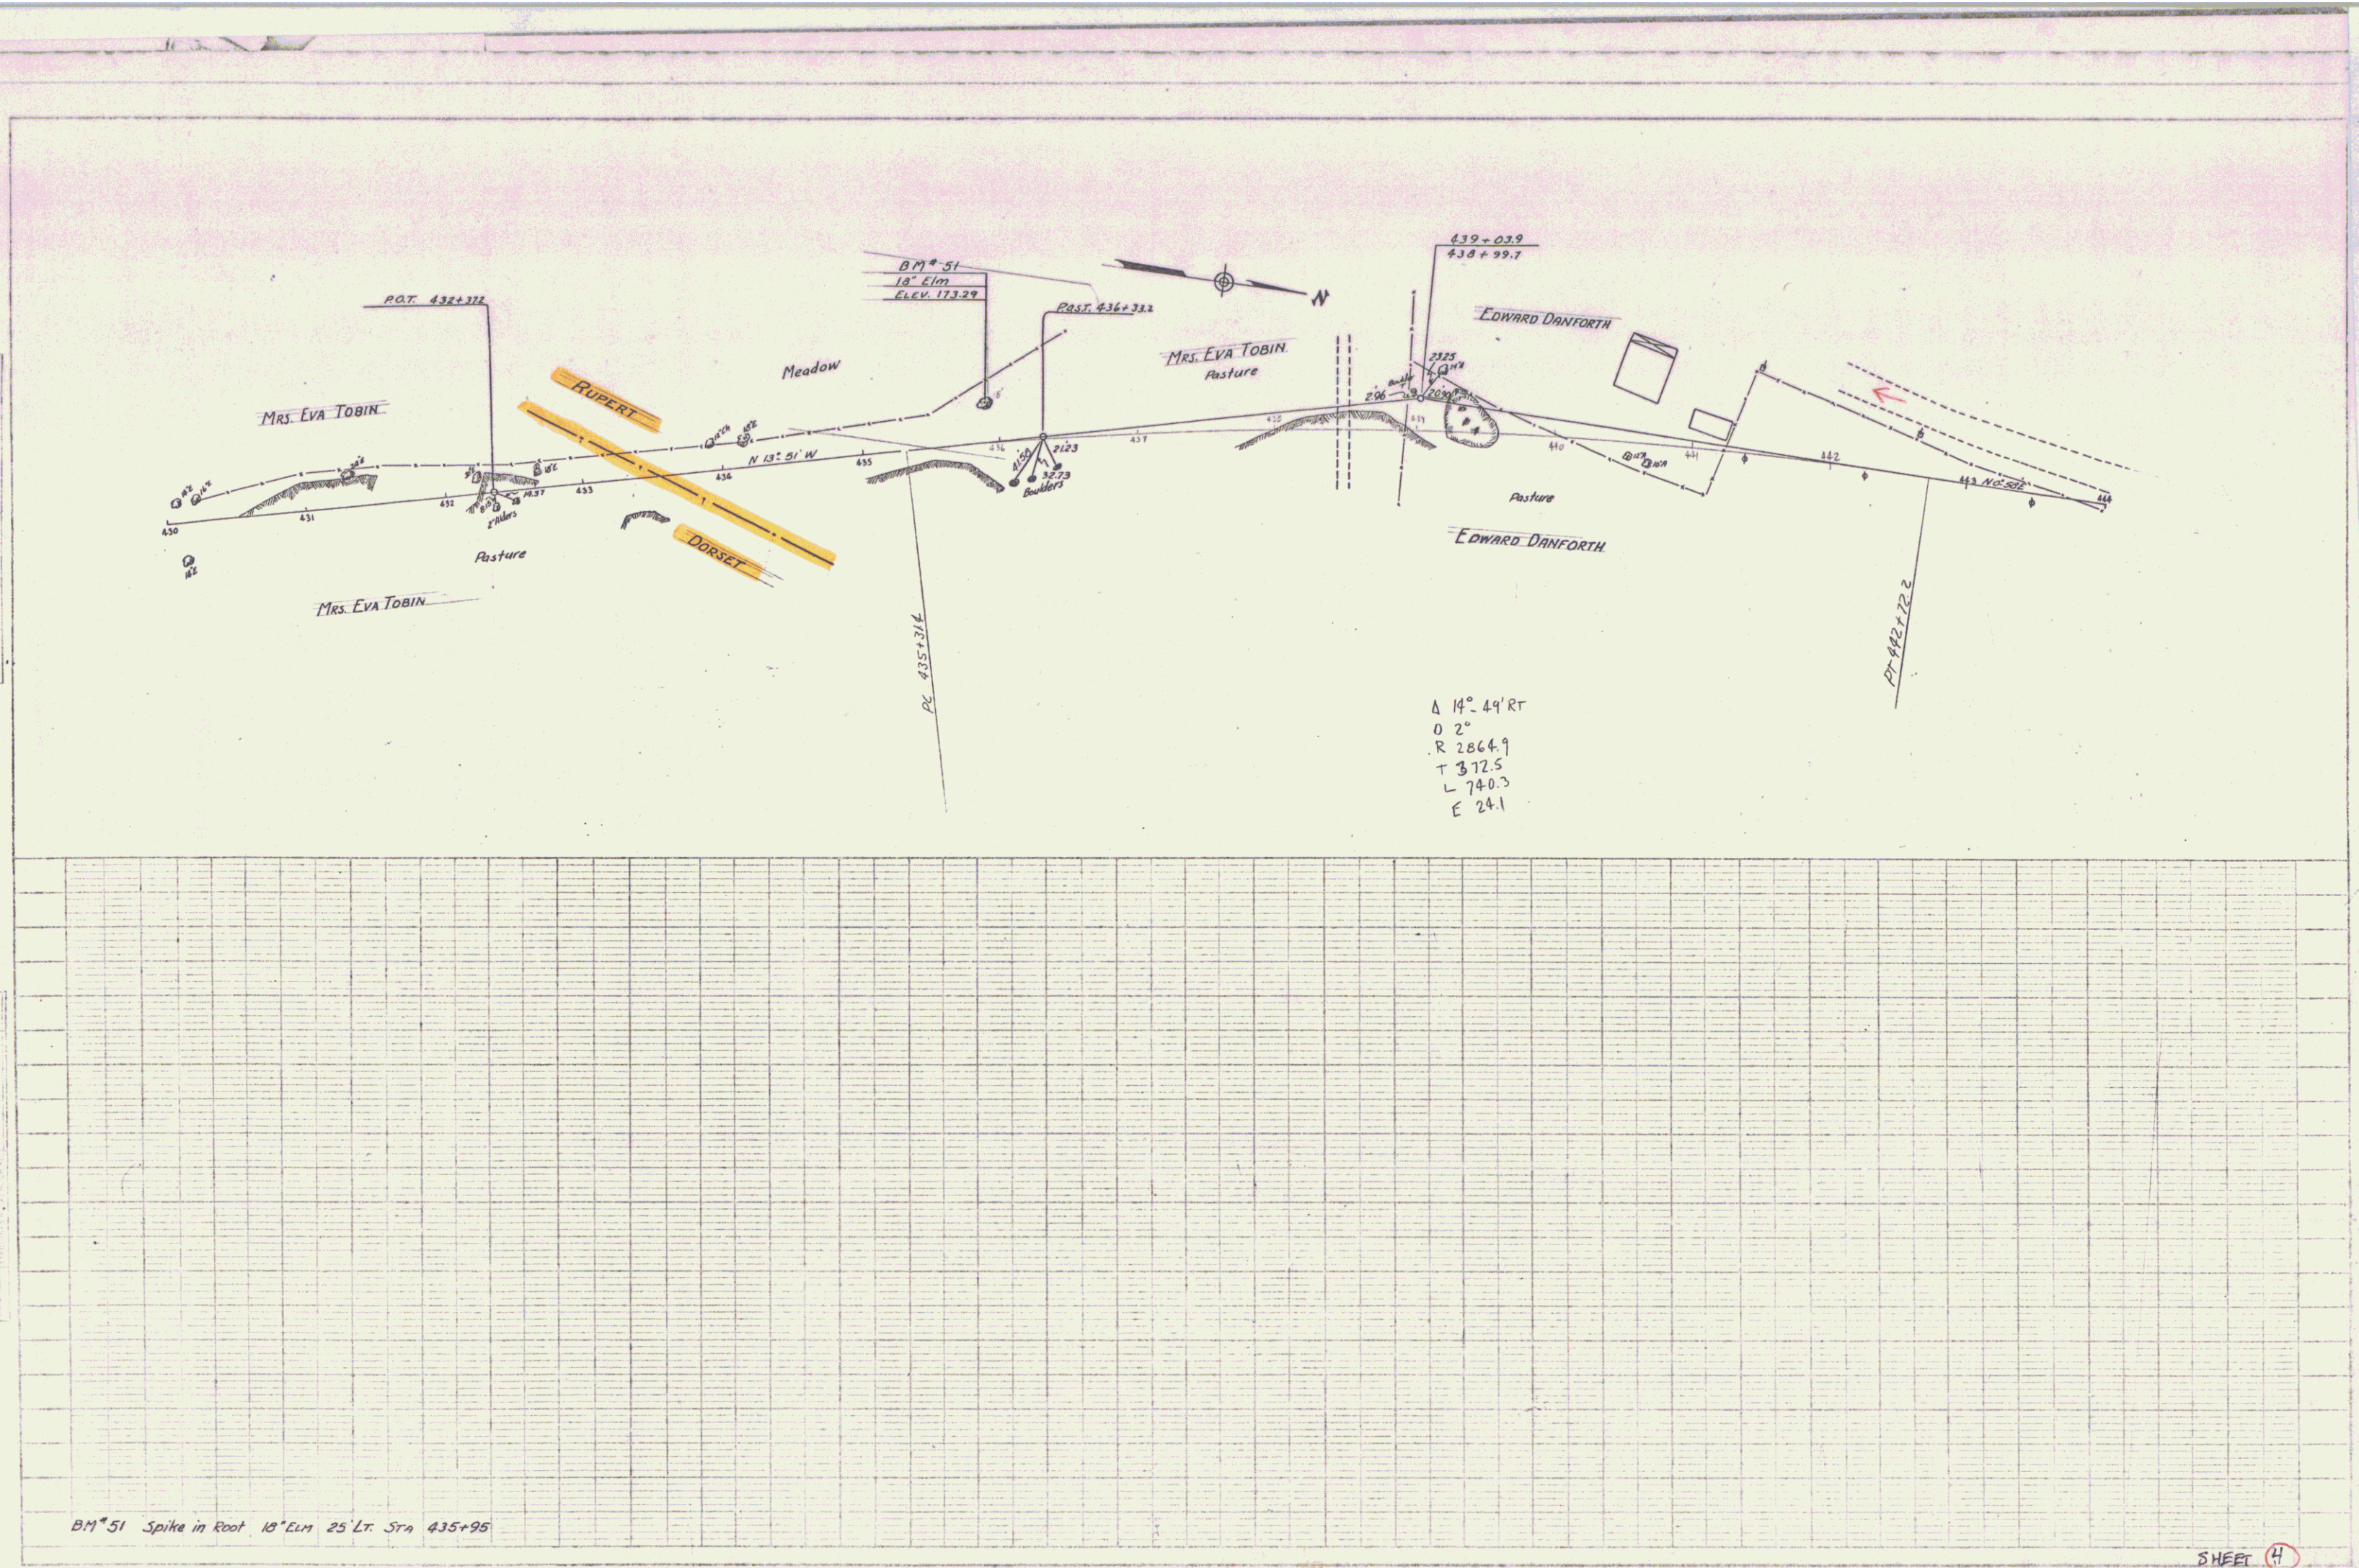

BM # 51 Spike in Root 18' Elm 25' Lt. Str 435+95

SHEET 4

5