


MP Dorset 437-523  
Rupert 0.00-0.45

RIGHT-OF-WAY DIVISION  
TOWN FILE  
PERPETUAL



Rte VT 30  
To Be Returned To R.O.W. Division

TOWNS OF  
DORSET-RUPERT  
Project 1938  
Pin # COR363  
Route VT30  
Date 3/1/1938

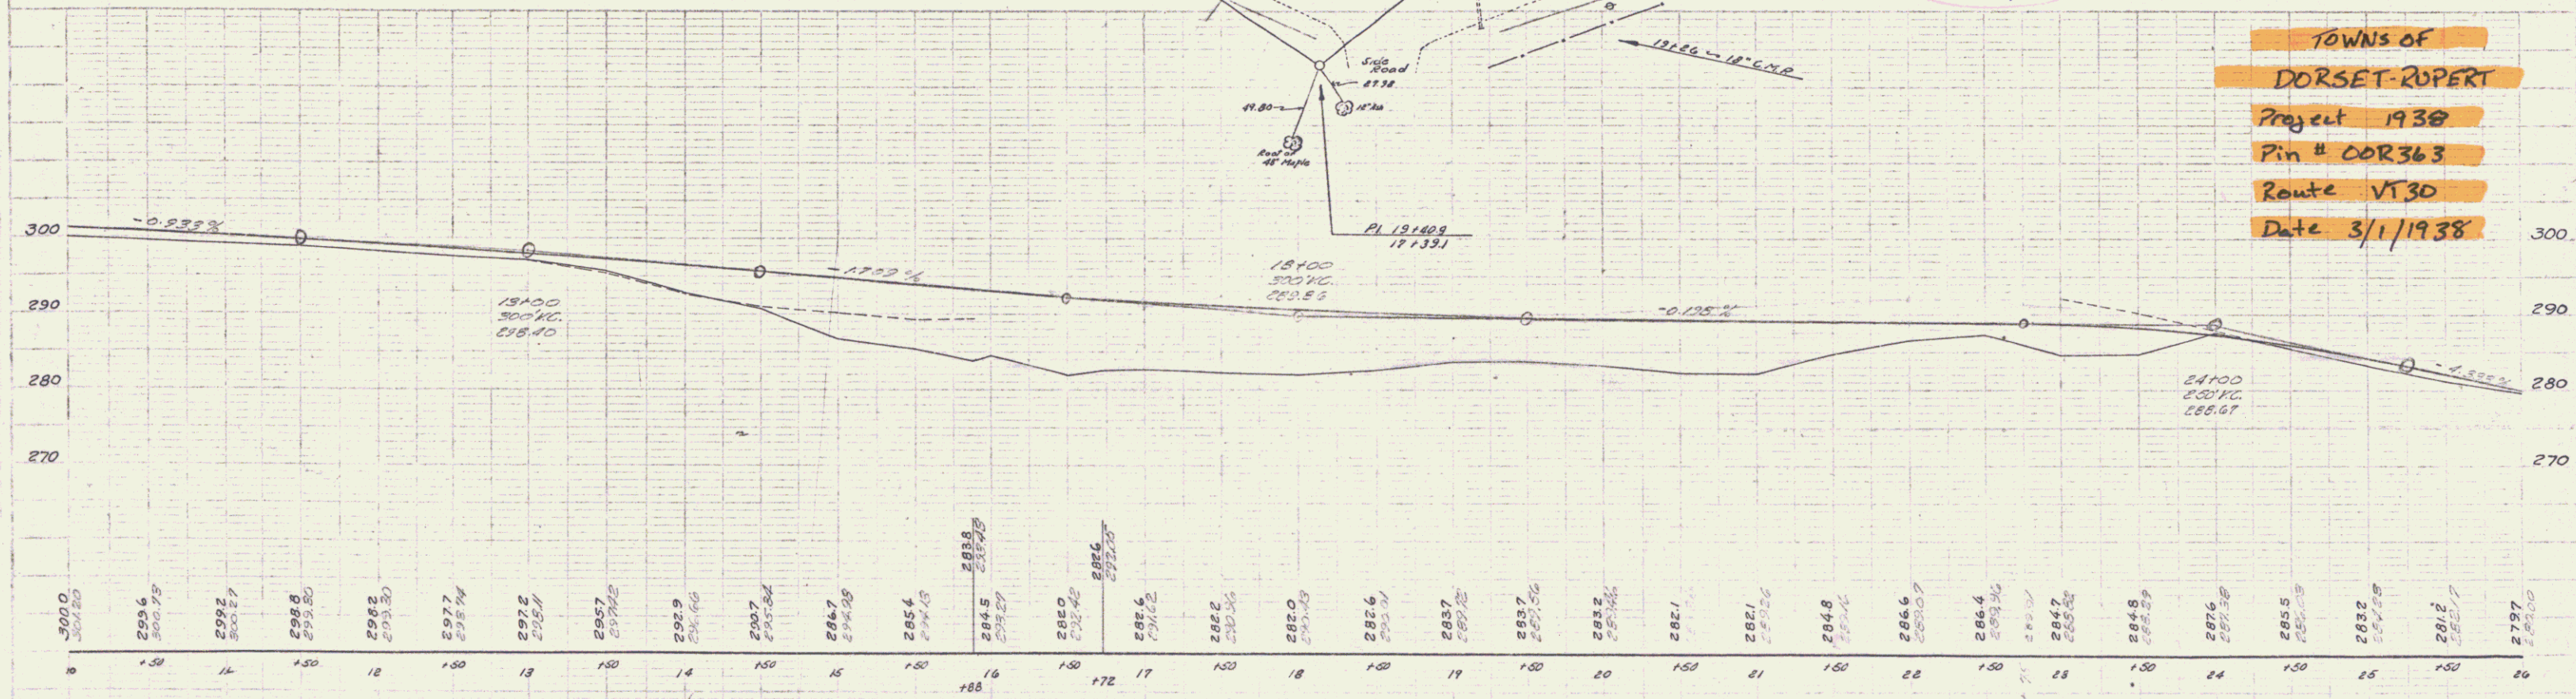

B.M.#1 SPOT ON 2000' WIDE 12" WIDE DIRT ROAD  
B.M.#2 SPOT ON CURB HEAD 3.5' BT 151.50' CIVIL 288.40  
B.M.#3 SPINE IN IRON 24" DIA 12" LT 151.75' CIVIL 288.45

DORSET  
Sheet 1 of 1

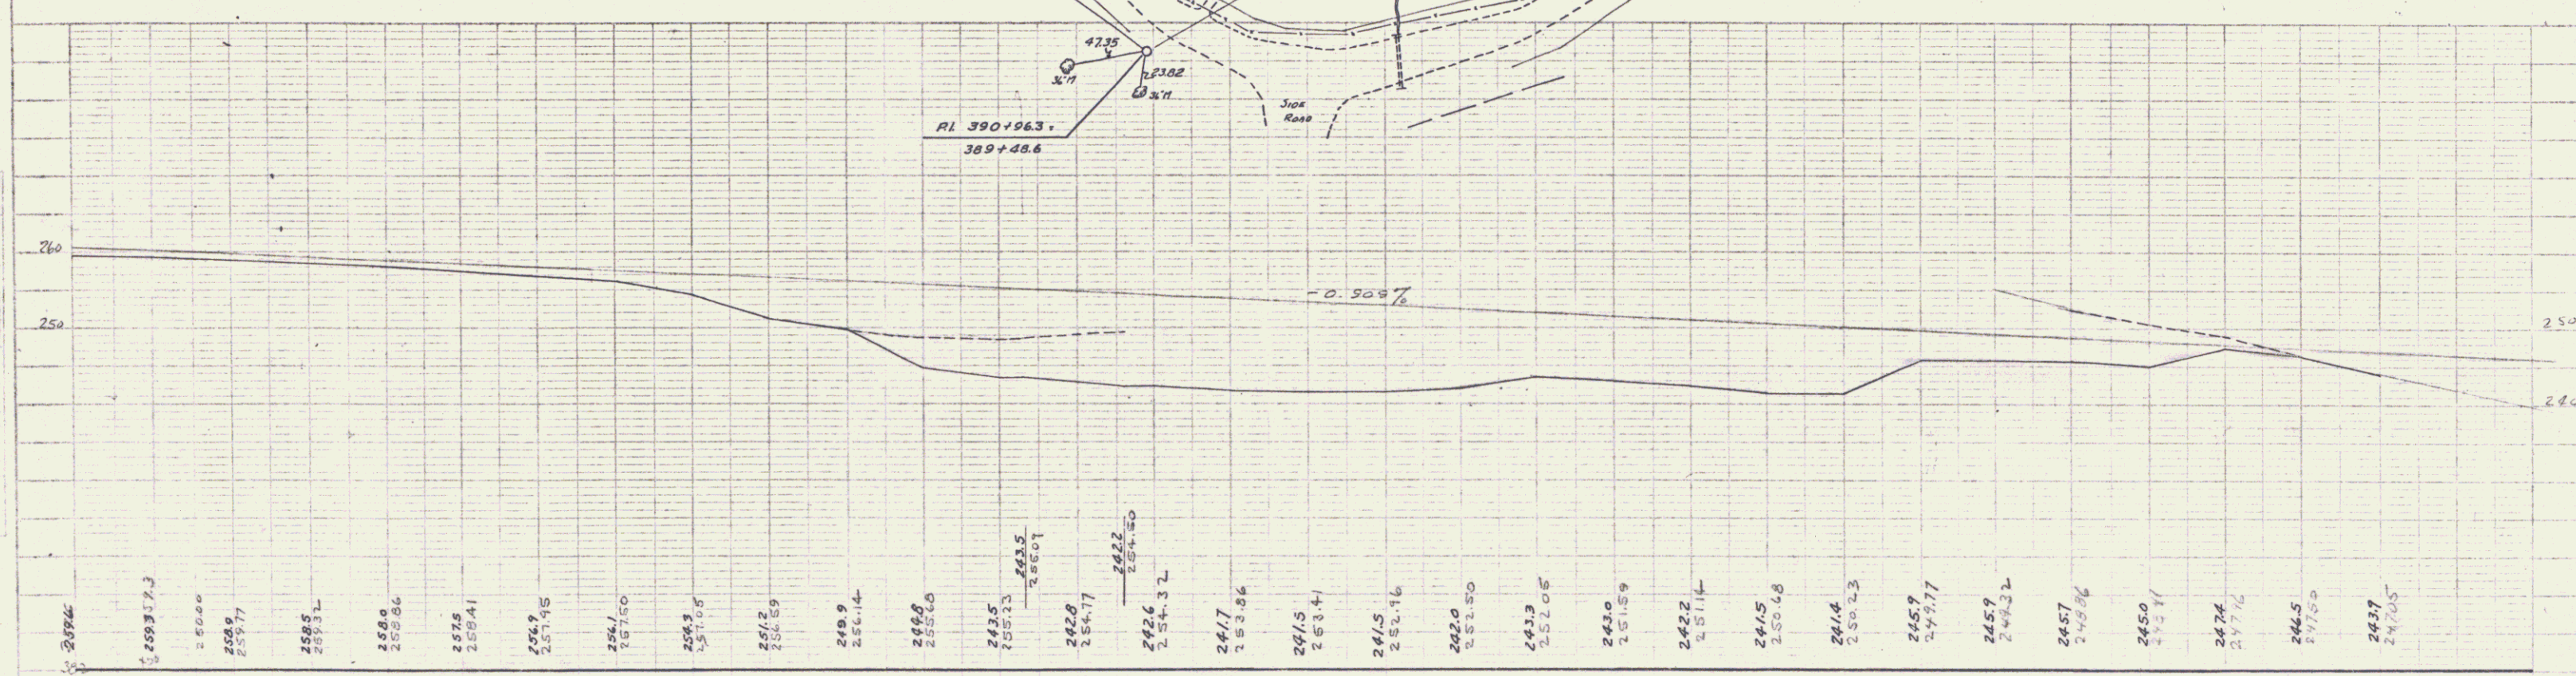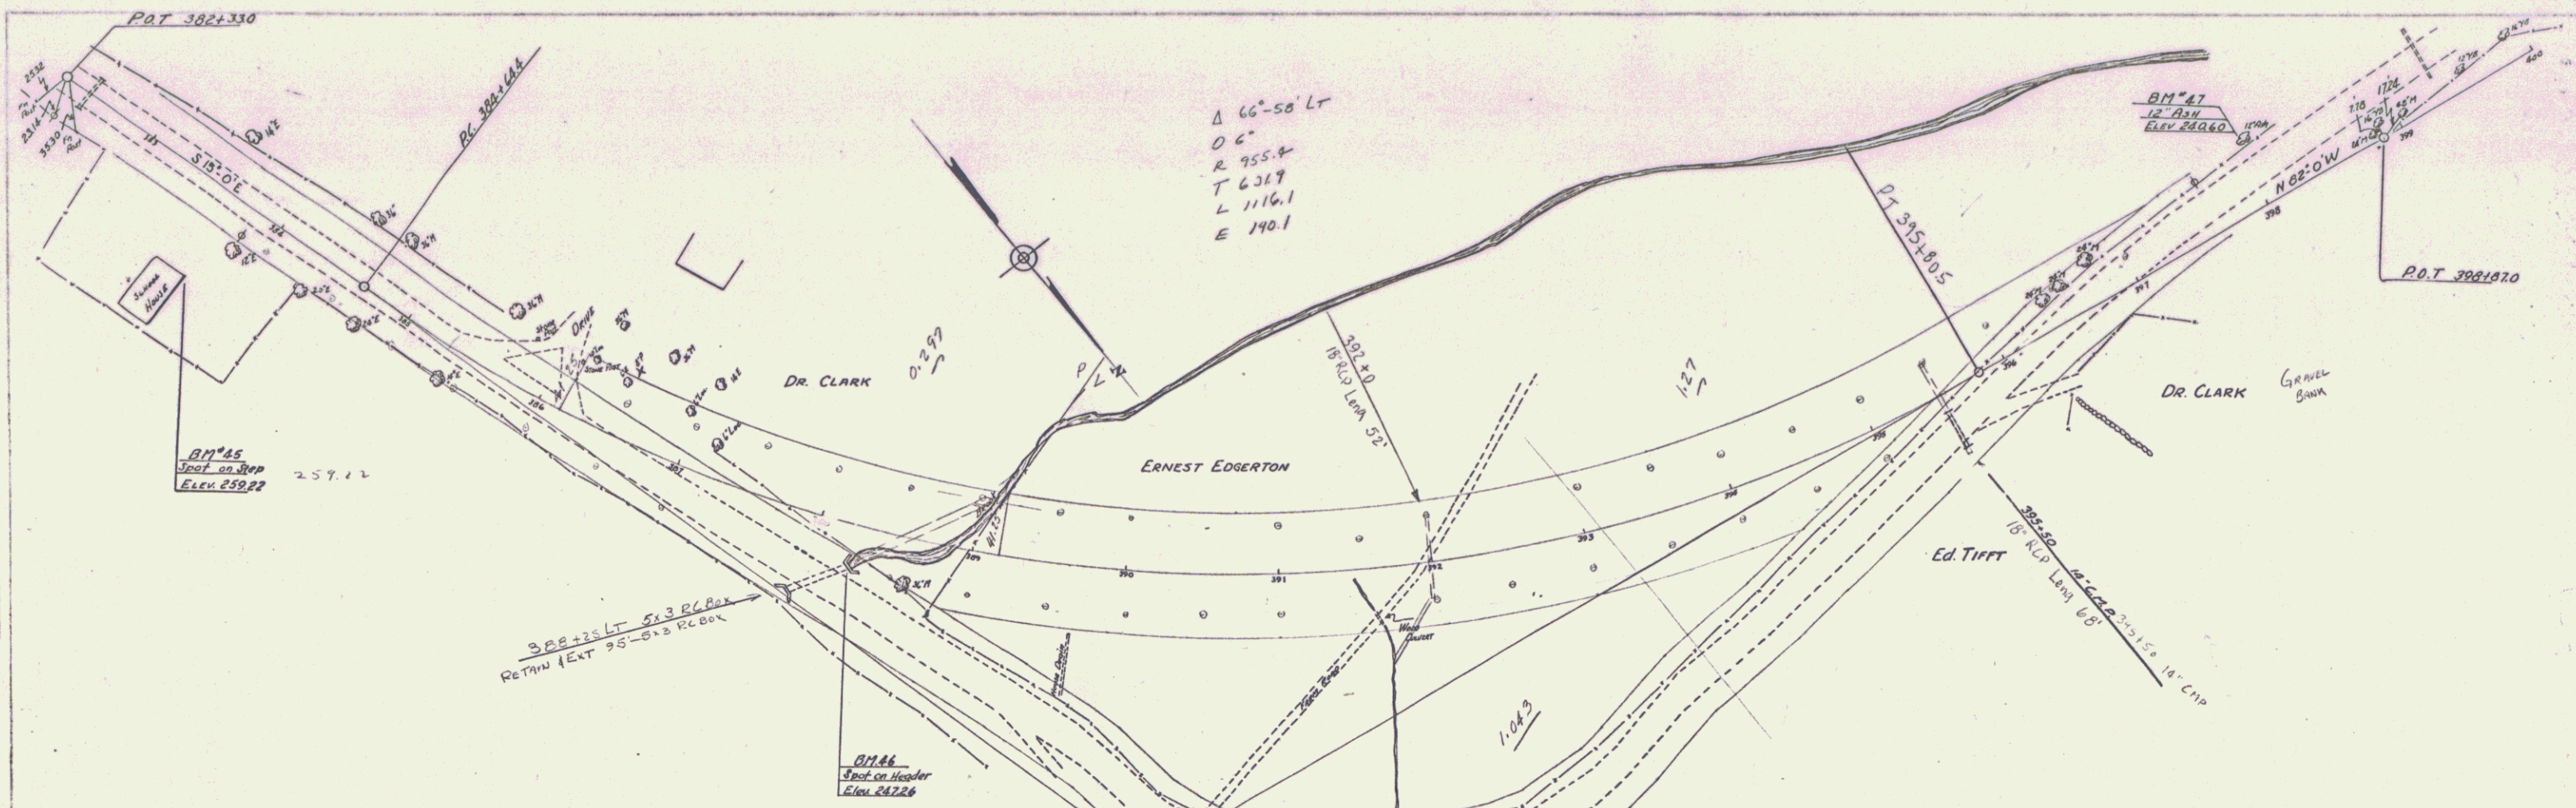


382	259.773	383	259.22	384	247.26	385	240.60	386		387		388		389		390		391		392		393		394		395		396		397
BM*45	Spot on School House Steps	60' Lt. Sta. 383+65	ELEV. 259.22	BM*44	Spot on Culvert Header	33' Pt. Sta. 388+25	ELEV. 247.26	BM*47	Spike in Trunk 12" Ash	40' Lt. Sta. 398+05	ELEV. 240.60																			

4172  
 4173  
 4174  

PLM  
 DATE  
 BY  
 CHECKED  
 APPROVED

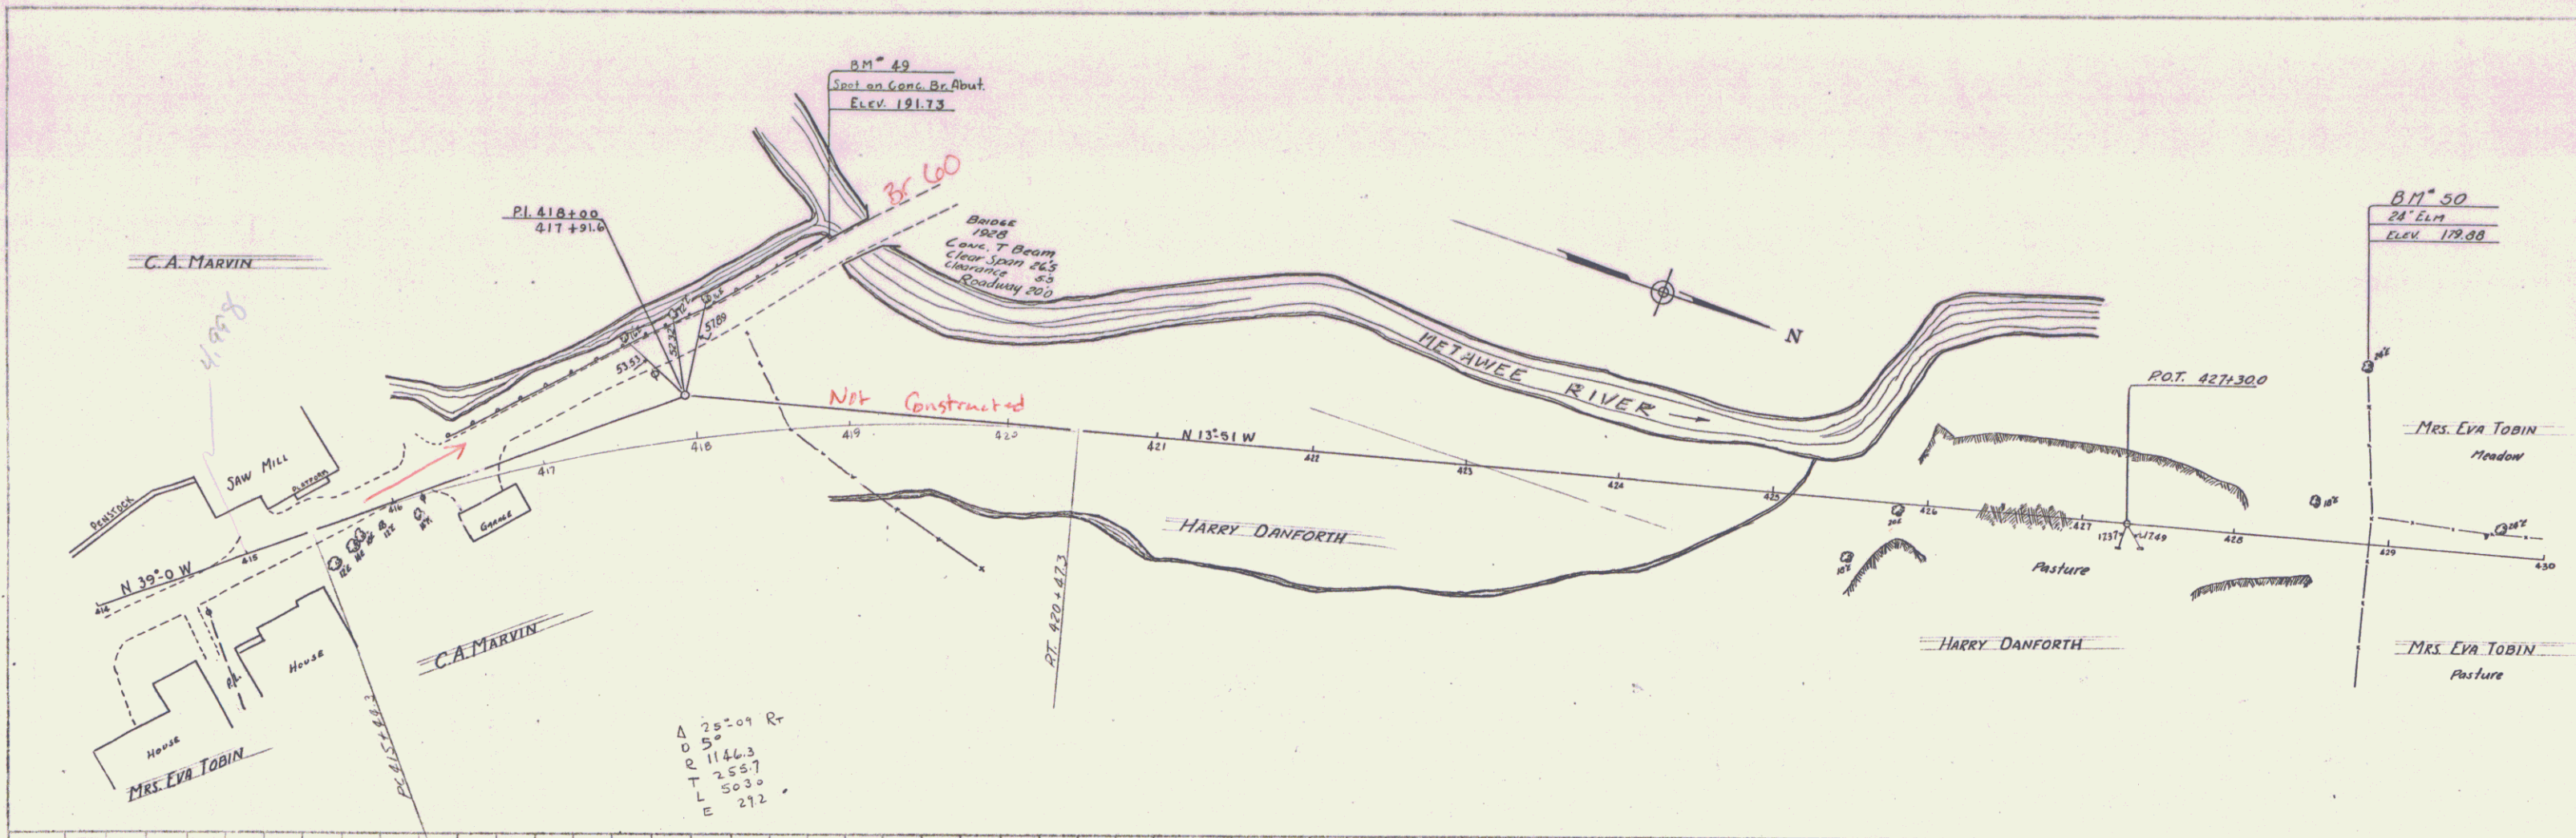

BM 49 Spot on Conc. Bridge Abut. 122 Lt. Sta. 417+90 Elev. 191.73  
 BM 50 Spike in Root 20 Elm 1125 Lt. Sta. 428+77 Elev. 179.88



Survey  
Station  
No. 52  
Elev. 172.86

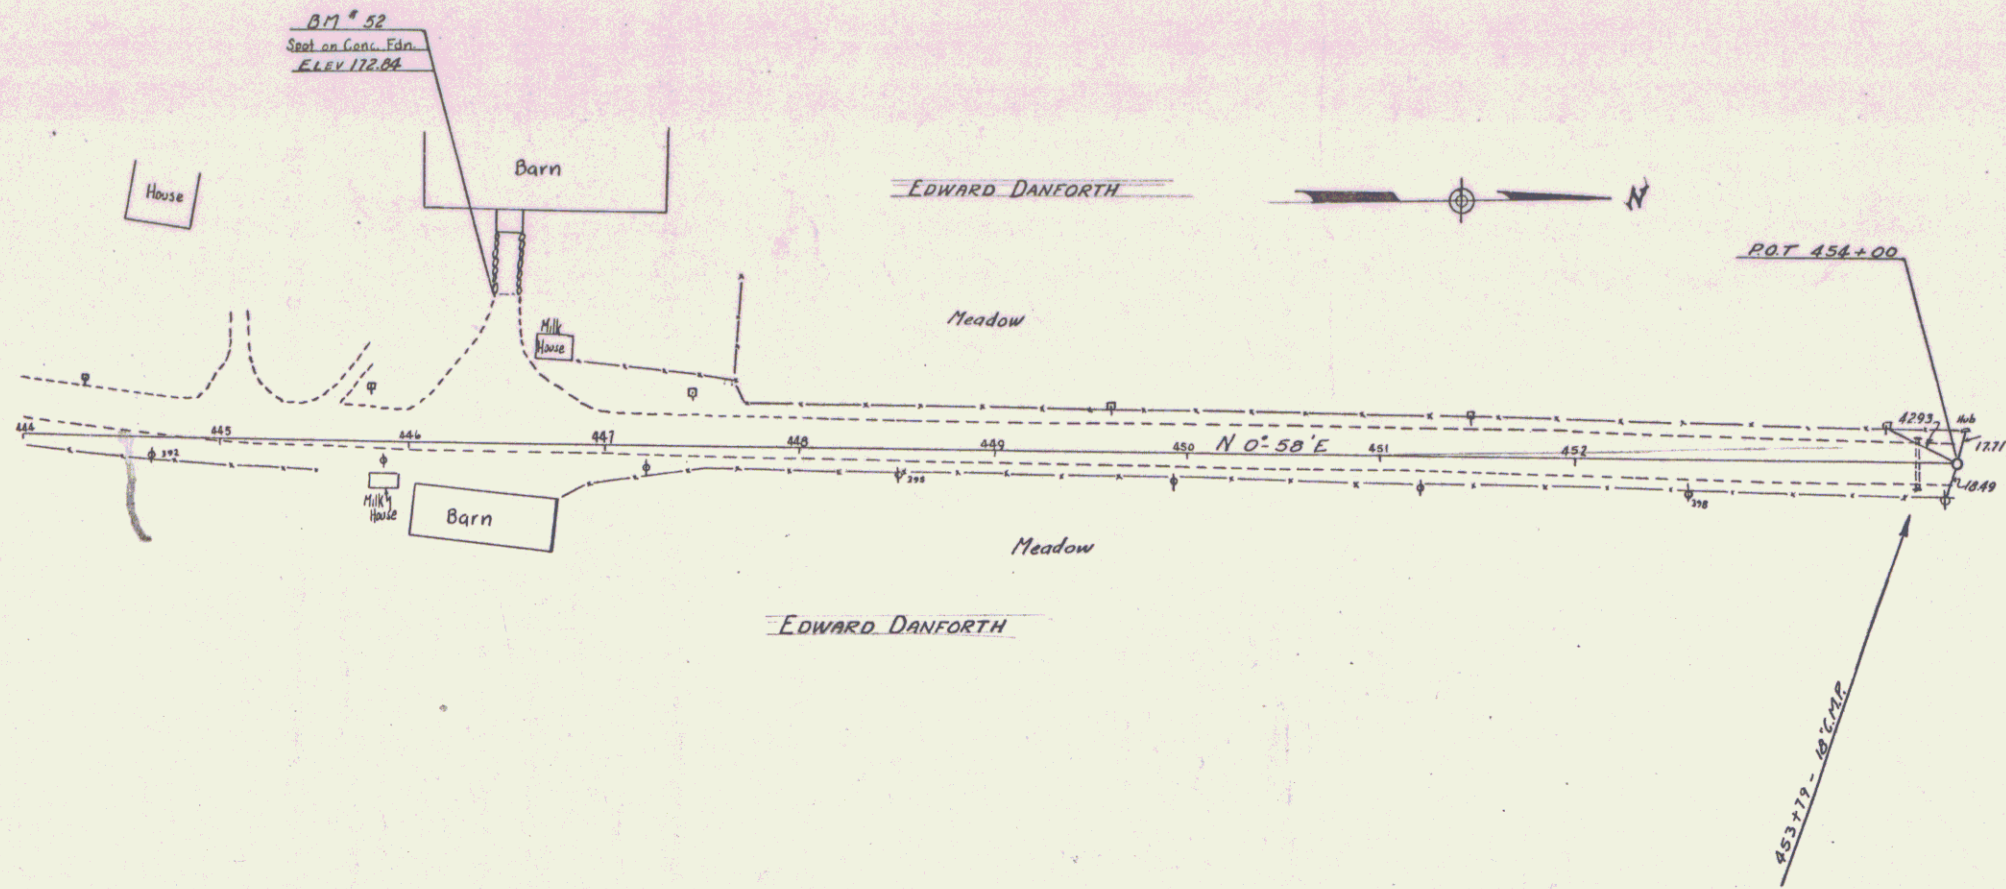

BM 52 Spot on Concrete Foundation 79' Lx Str. 446+44 Elev 172.86

SHEET 5

6