

APPROACHES
303+50 Rt. town road

DRIVES

LT	RT
305+77	305+77
305+90	305+90
305+100	305+100
305+100	305+100
305+160	305+160

CLEANING & GRUBBING ITEM 13
Sta. 303+00-309+00 Lt.


CONSTRUCTED DRIVES

RT	LT
300+30	300+30
300+25	300+25
300+25	300+25
300+25	300+25

RECORDED DORSET

PARCEL	INSTRUMENT	DATE	GRANTOR	GRANTEE	BOOK	PAGE	DATE	REMARKS
#3 A & B	W. D. O. E.	9-20-48	SARAH CLARKE COLBOURN LAURA CLARKE GAFFNEY MARJORIE C. NOYES	ST. OF VT.	38	297	10-8-48	

CONTROL OF SECTION OF OLD HIGHWAY BETWEEN STA 303+75 (35' RT)
AND STA 304+23 (53' RT) RISING 15' IN EL. TO TOWN OF DORSET
RECORDED VOLUME 33, PAGE 267, JANUARY 13, 1950

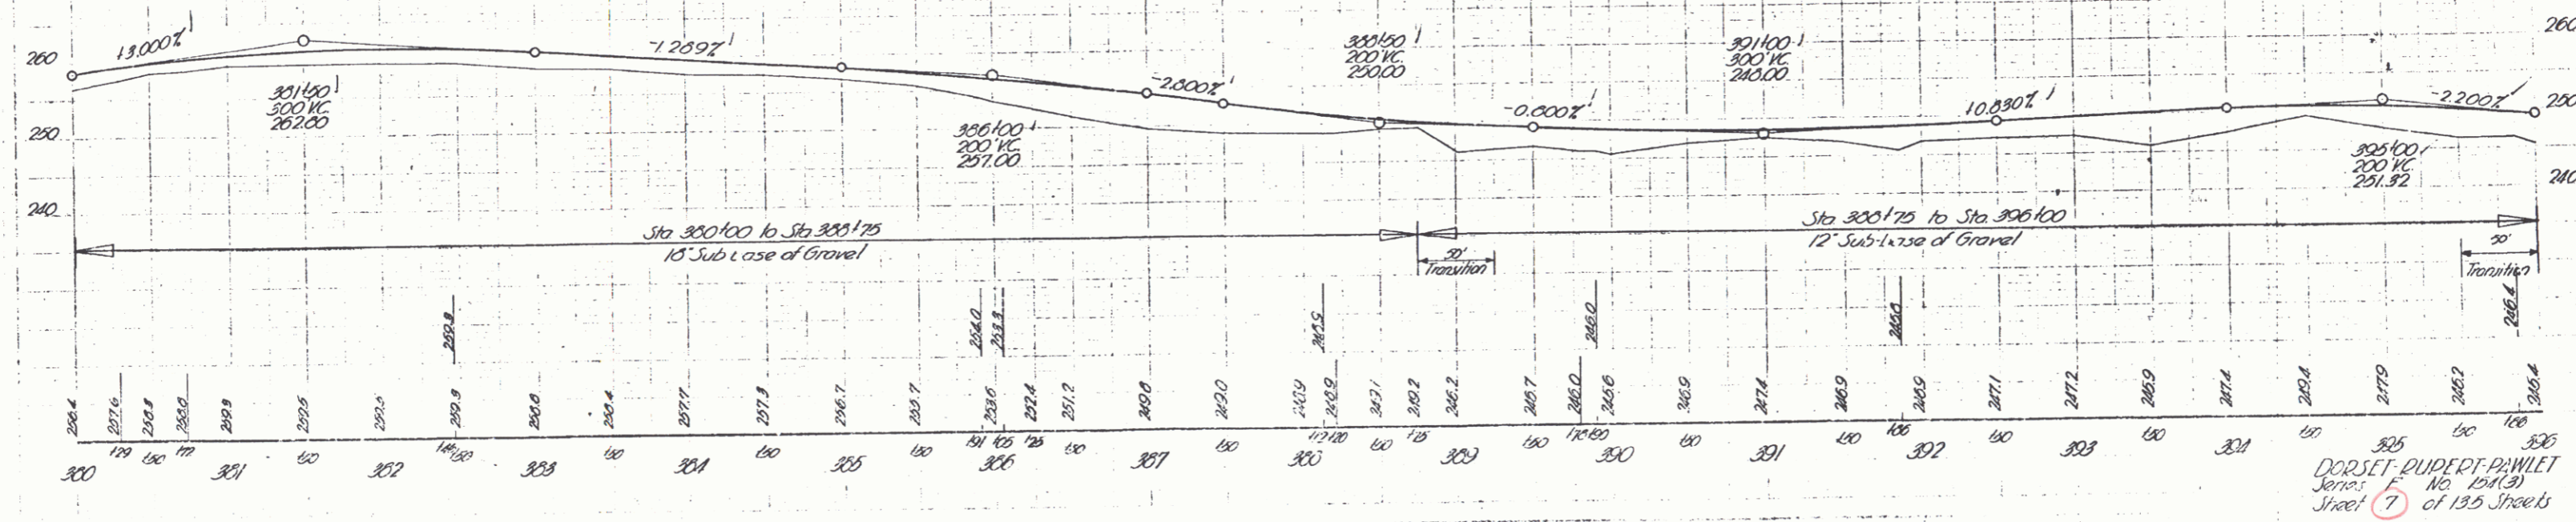

DORSET-DUDERT-PAWLET
Jens. E. No. 151(3)
Sheet 7 of 135 Sheets