


PARCEL	INSTRUMENT	DATE	GRANTOR	GRANTEE	RECORDED DORSET	REMARKS
#5 A	W. D. O. E.	9-20-48	SARAH CLARKE COLBOURN	ST. OF VT.	BOOK 38 PAGE 280	9-30-48
#4 A	W. D. O. E.	9-21-48	C.A. & SARAH N. MARVIN	ST. OF VT.	BOOK 38 PAGE 284	9-30-48

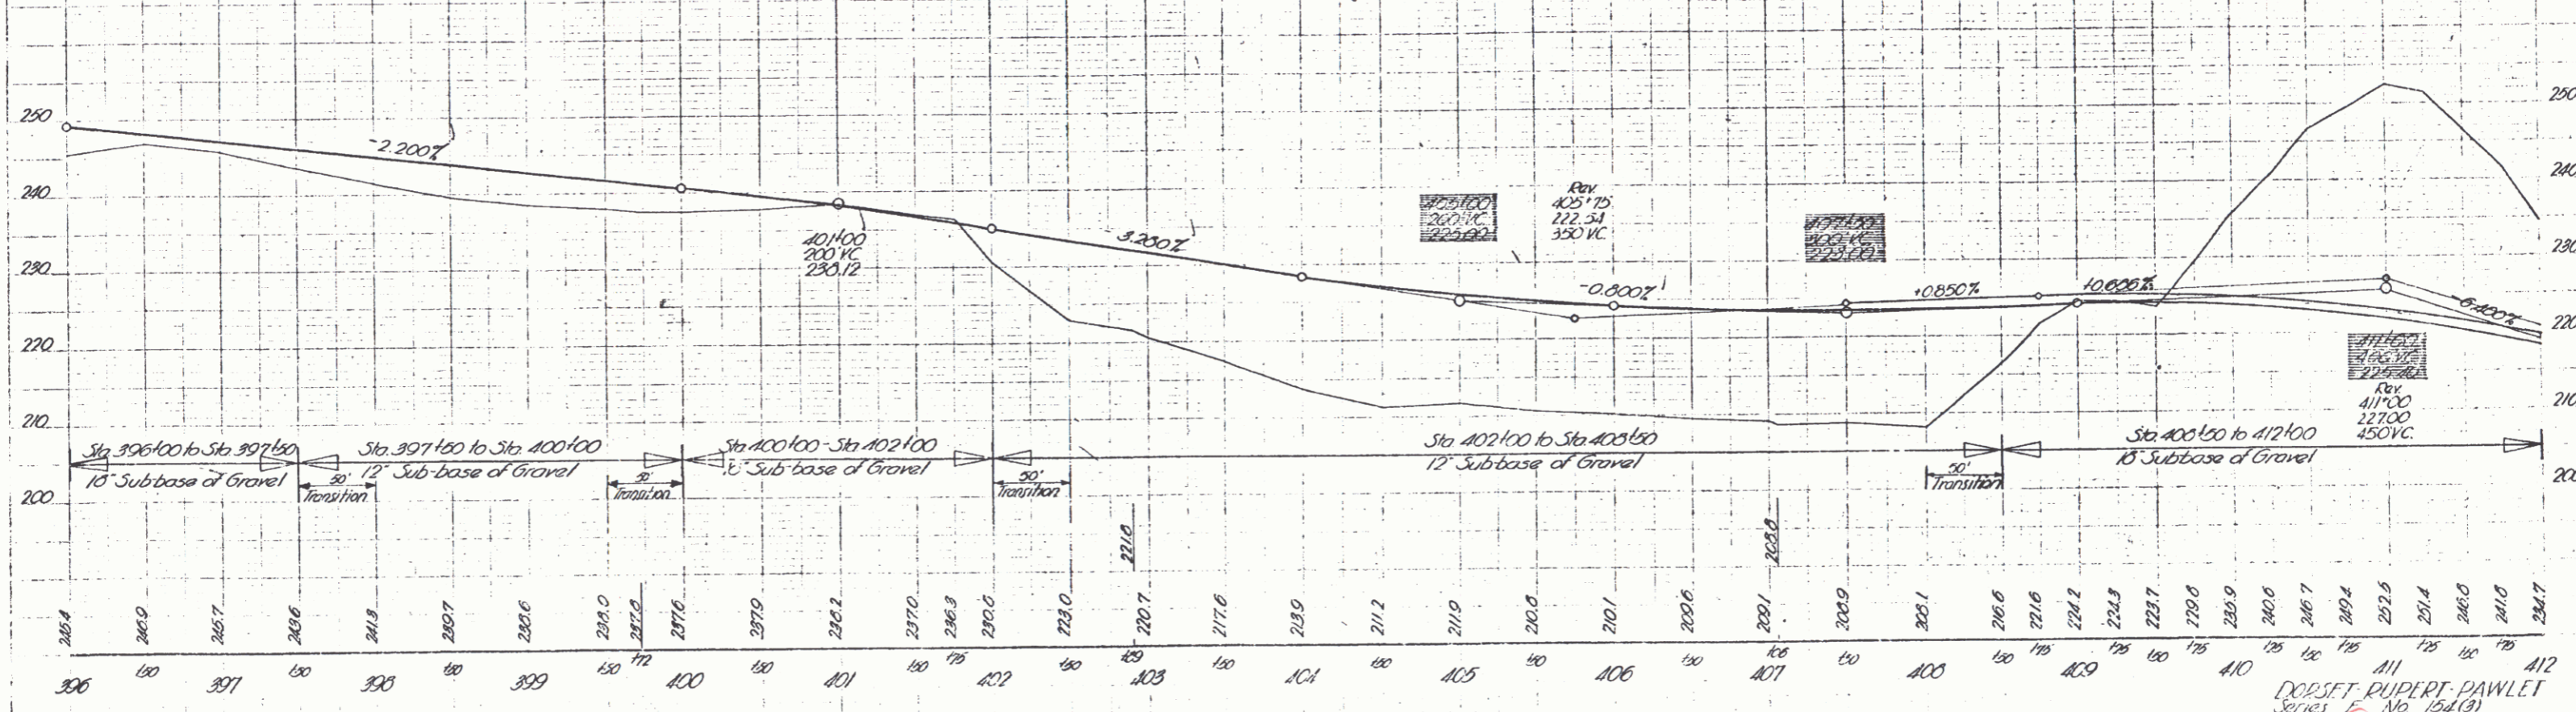

DORSET RUPERT PAWLET  
 Series No. 154(3)  
 Sheet 6 of 125 Sheets