


CONSTRUCTED DRIVES

Rt.	Lt.
417+40	412+20
417+15	423+55
427+65	

RECORDED DORSET

BOOK	PAGE	DATE	REMARKS
890K	286	3-28-48	
	282	9-30-48	

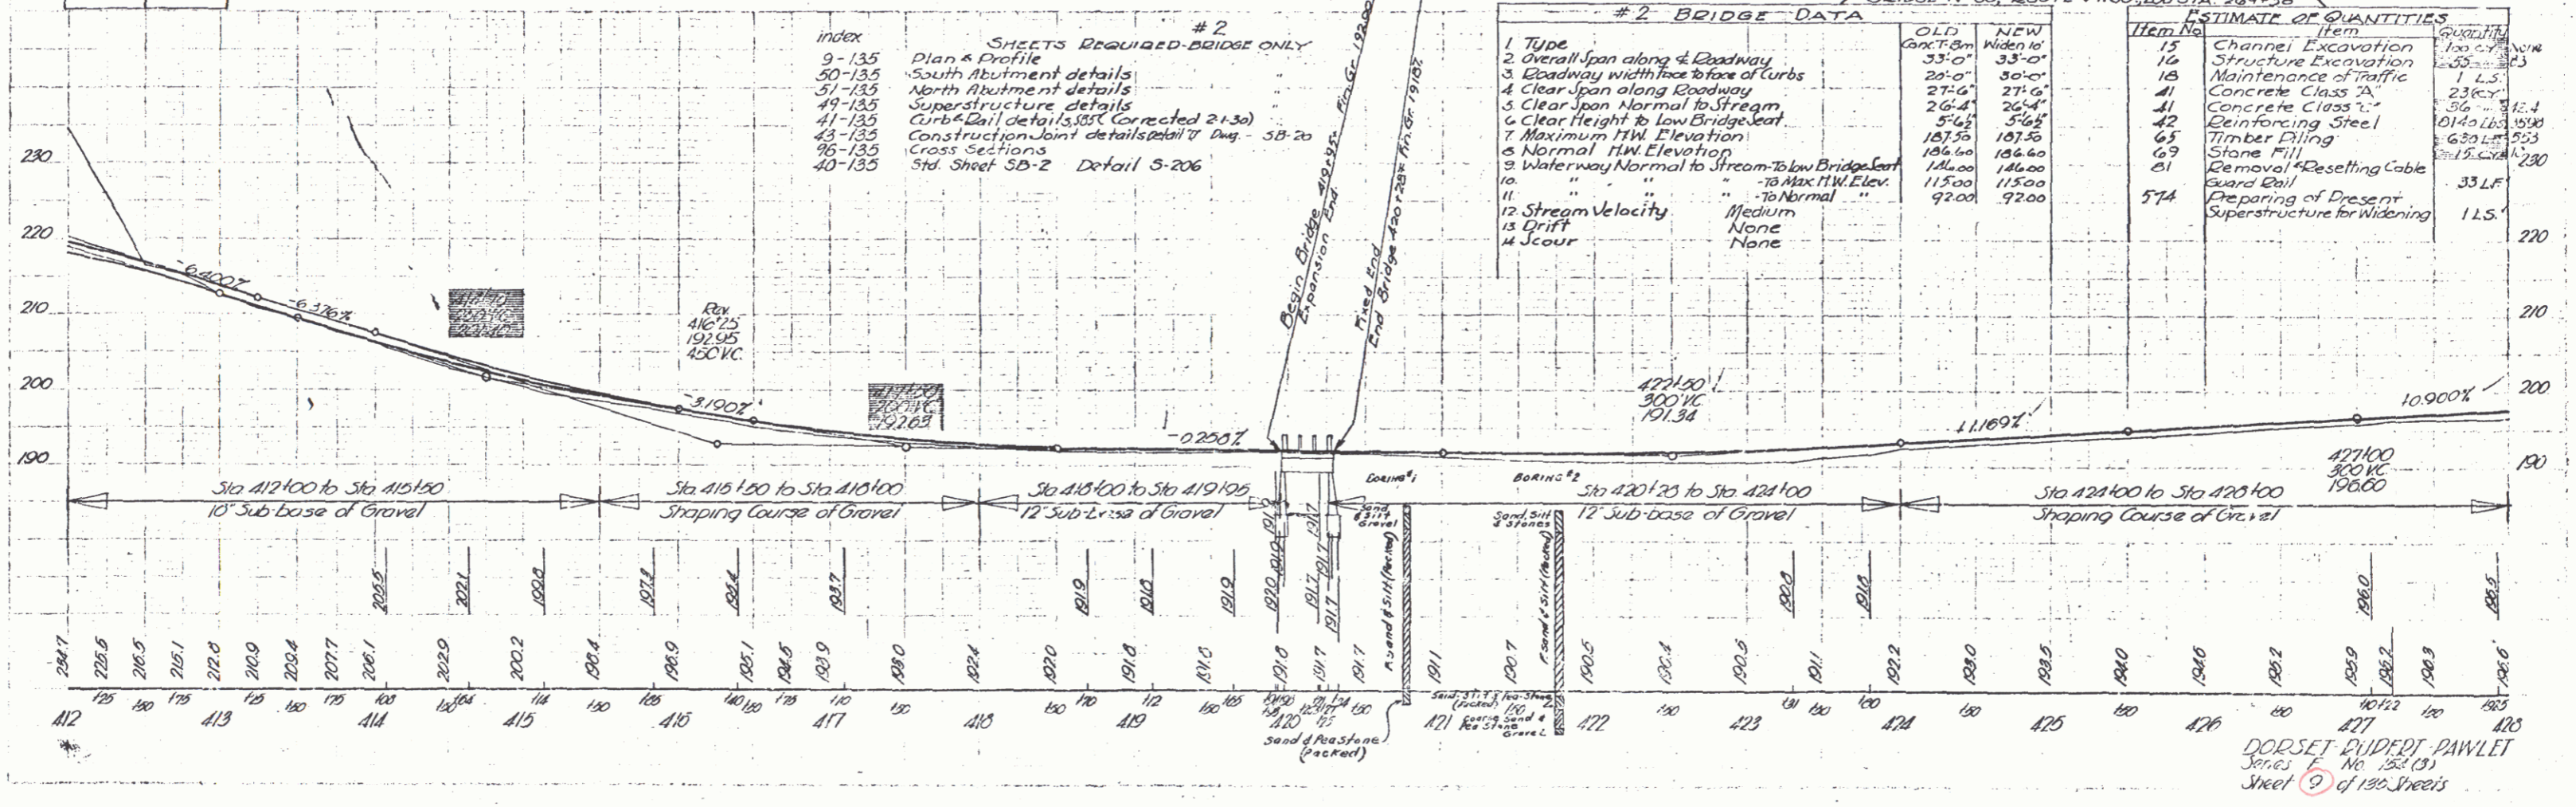

DORSET DUDERT PAWLET
 Series F No. 152 (3)
 Sheet 9 of 130 Sheets