


CONSTRUCT DRIVES		CONSTRUCTED DRAWS	
LEFT	RIGHT	RT	LT
444+40	444+40	446+25	451+00
451+00	446+25	446+25	452+50
452+25	446+78	451+57	
452+50	452+00	452+25	
452+67	452+25	452+50	
452+84	452+05		

154(9) 1947. 12. 13.

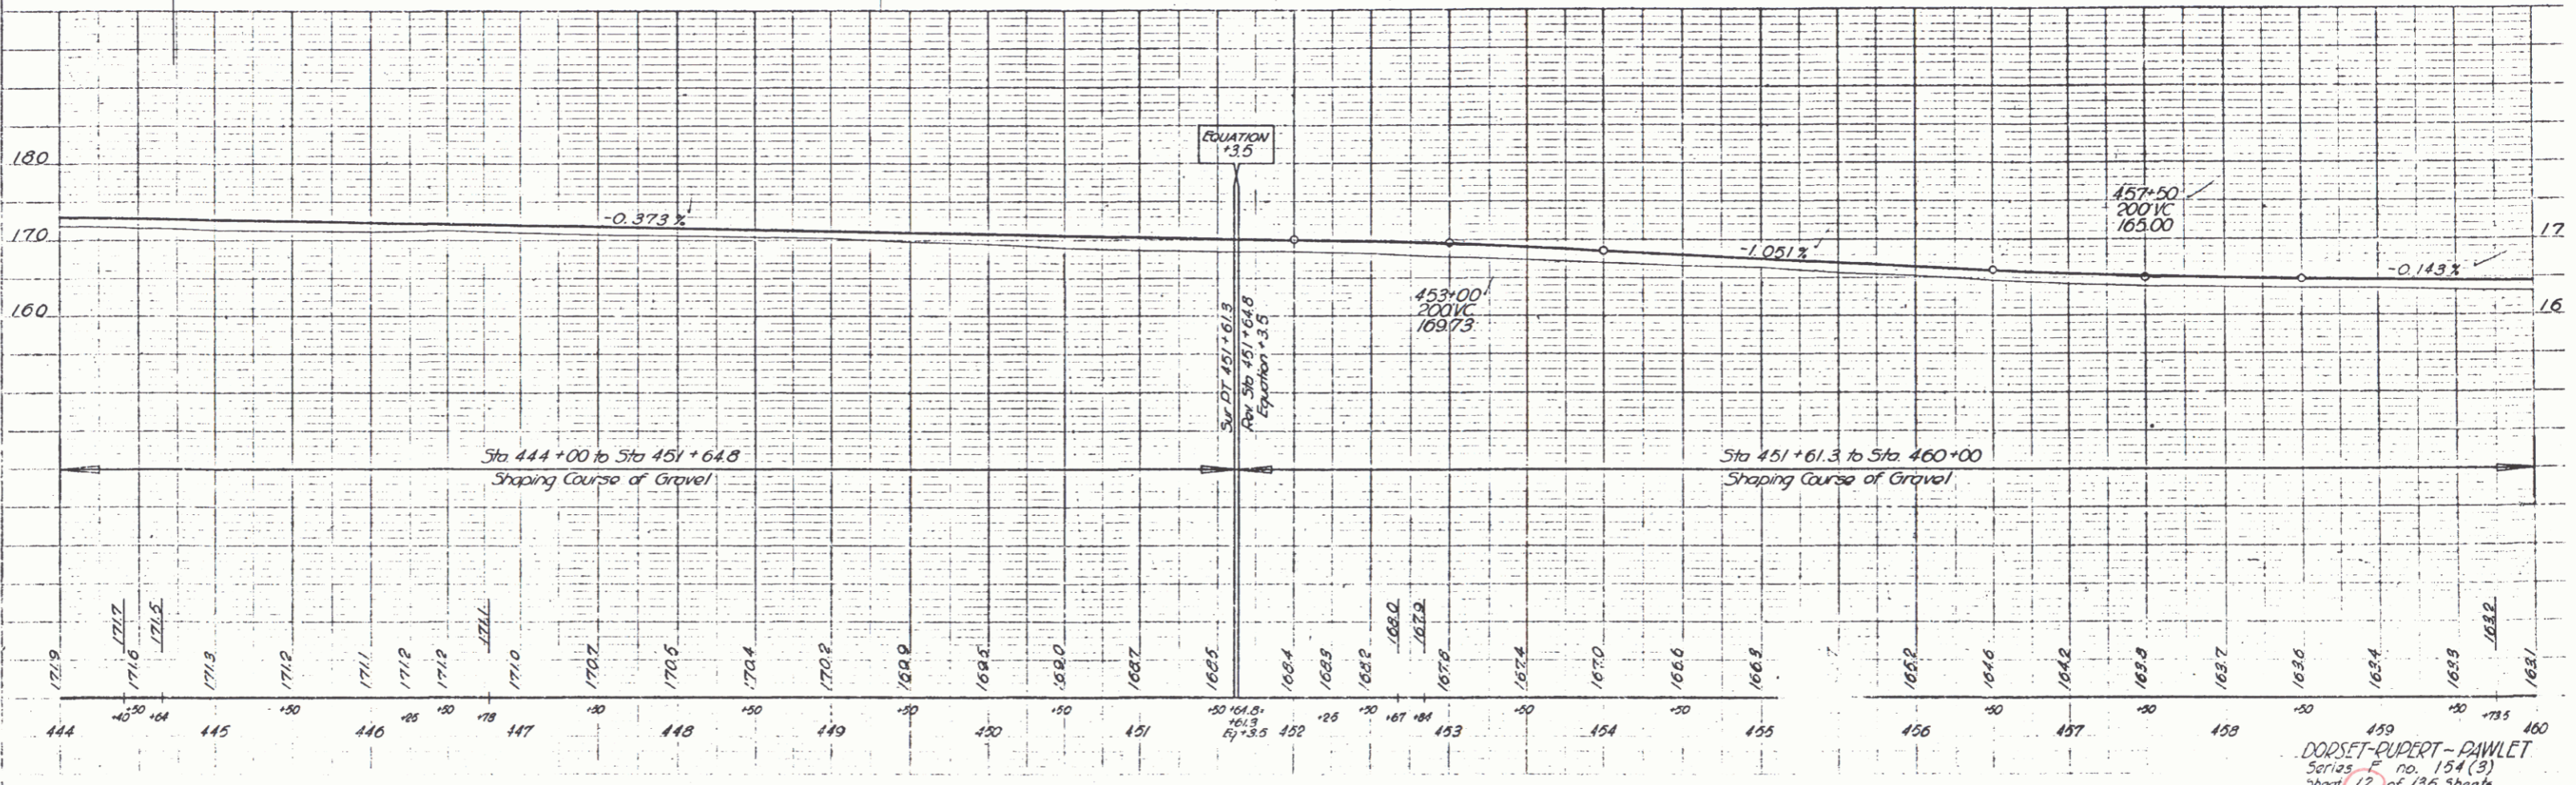

1/4  
25/11  
Jones

1/16  
Jones