


Construct Drives	
LI	PI
490+50	495+74
490+57	
CONTRACTED LIMITS	
490+75	494+70

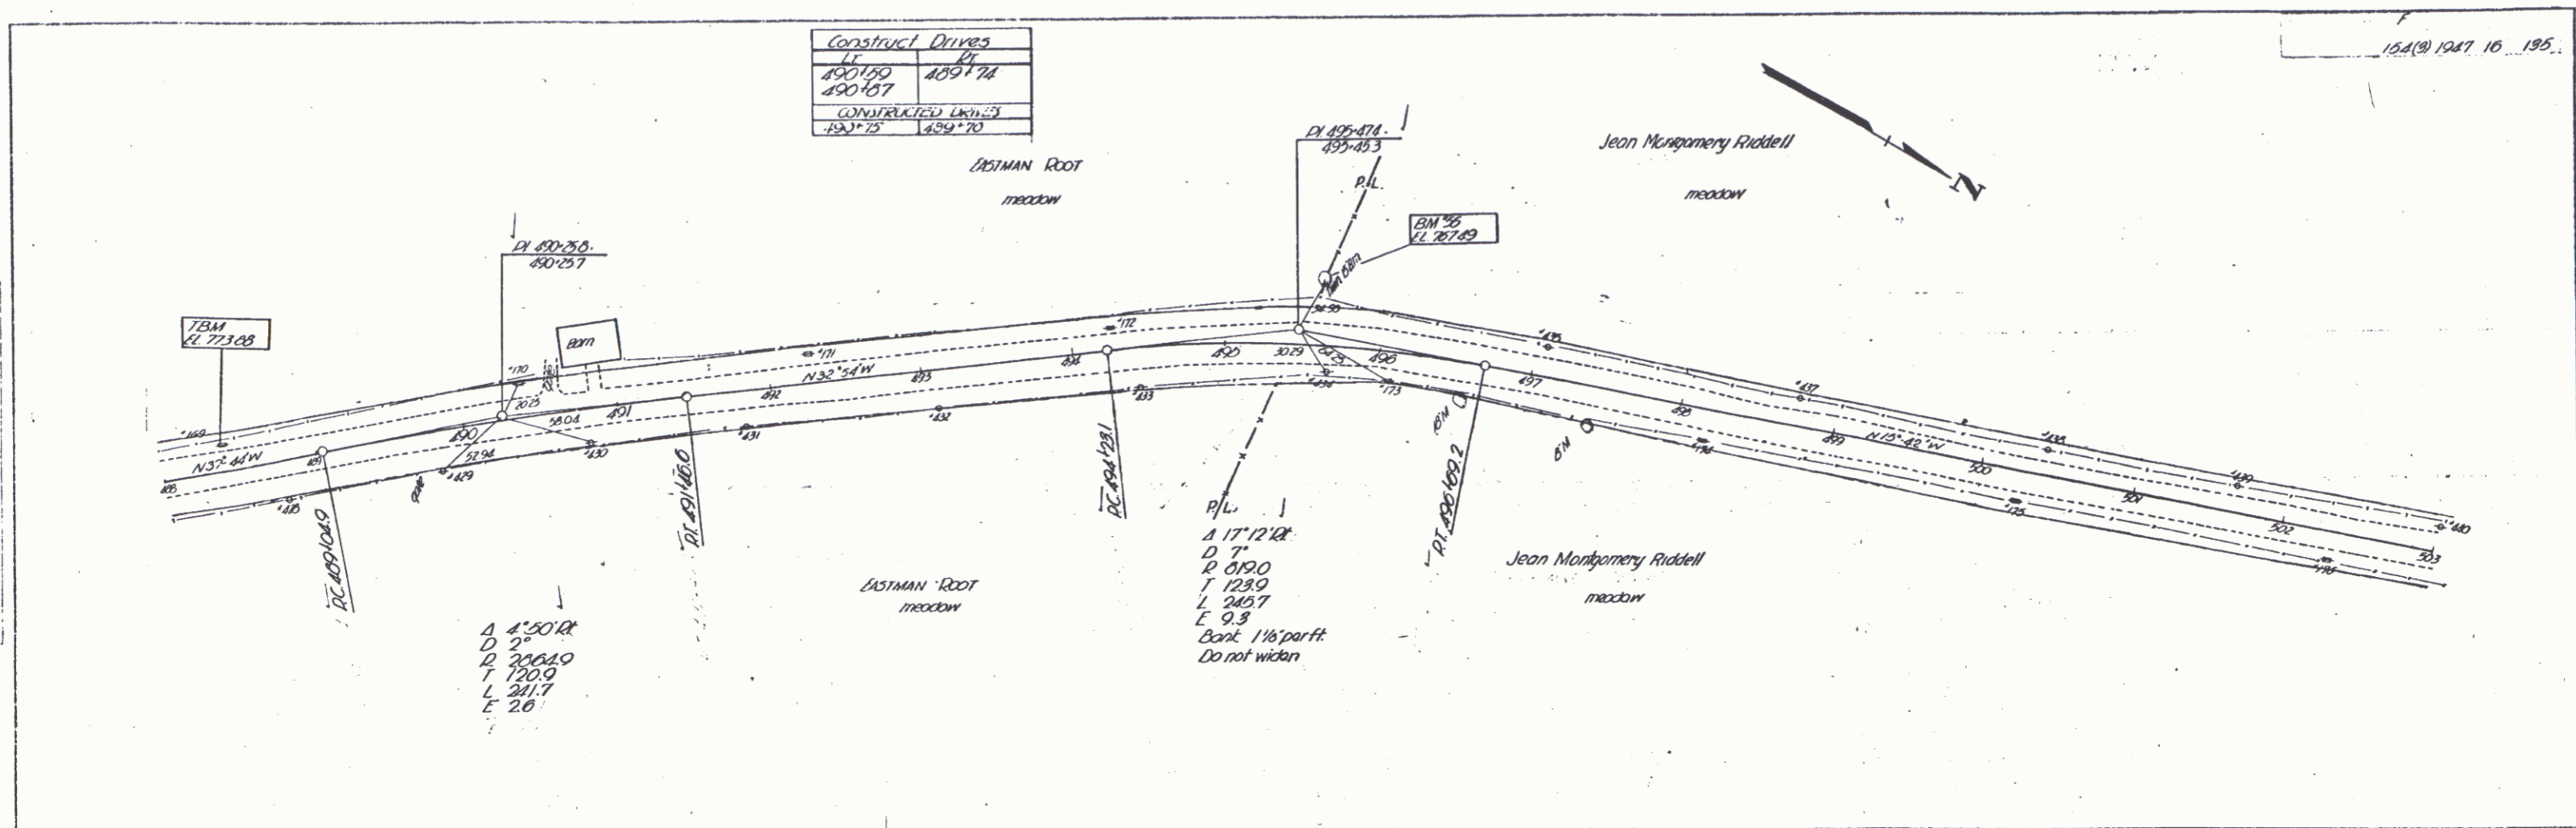


A 4'50" R
D 2'
T 200.60
L 120.0
E 281.7
E 20

P.L. 1
A 17'12" R
D 7'
T 123.0
L 240.7
E 9.3
Bank 1 1/2' per ft
Do not widen

DATE: 5-11-51
BY: [Signature]
CHECKED: [Signature]
SCALE: AS SHOWN

DATE: 5-11-51
BY: [Signature]
CHECKED: [Signature]
SCALE: AS SHOWN

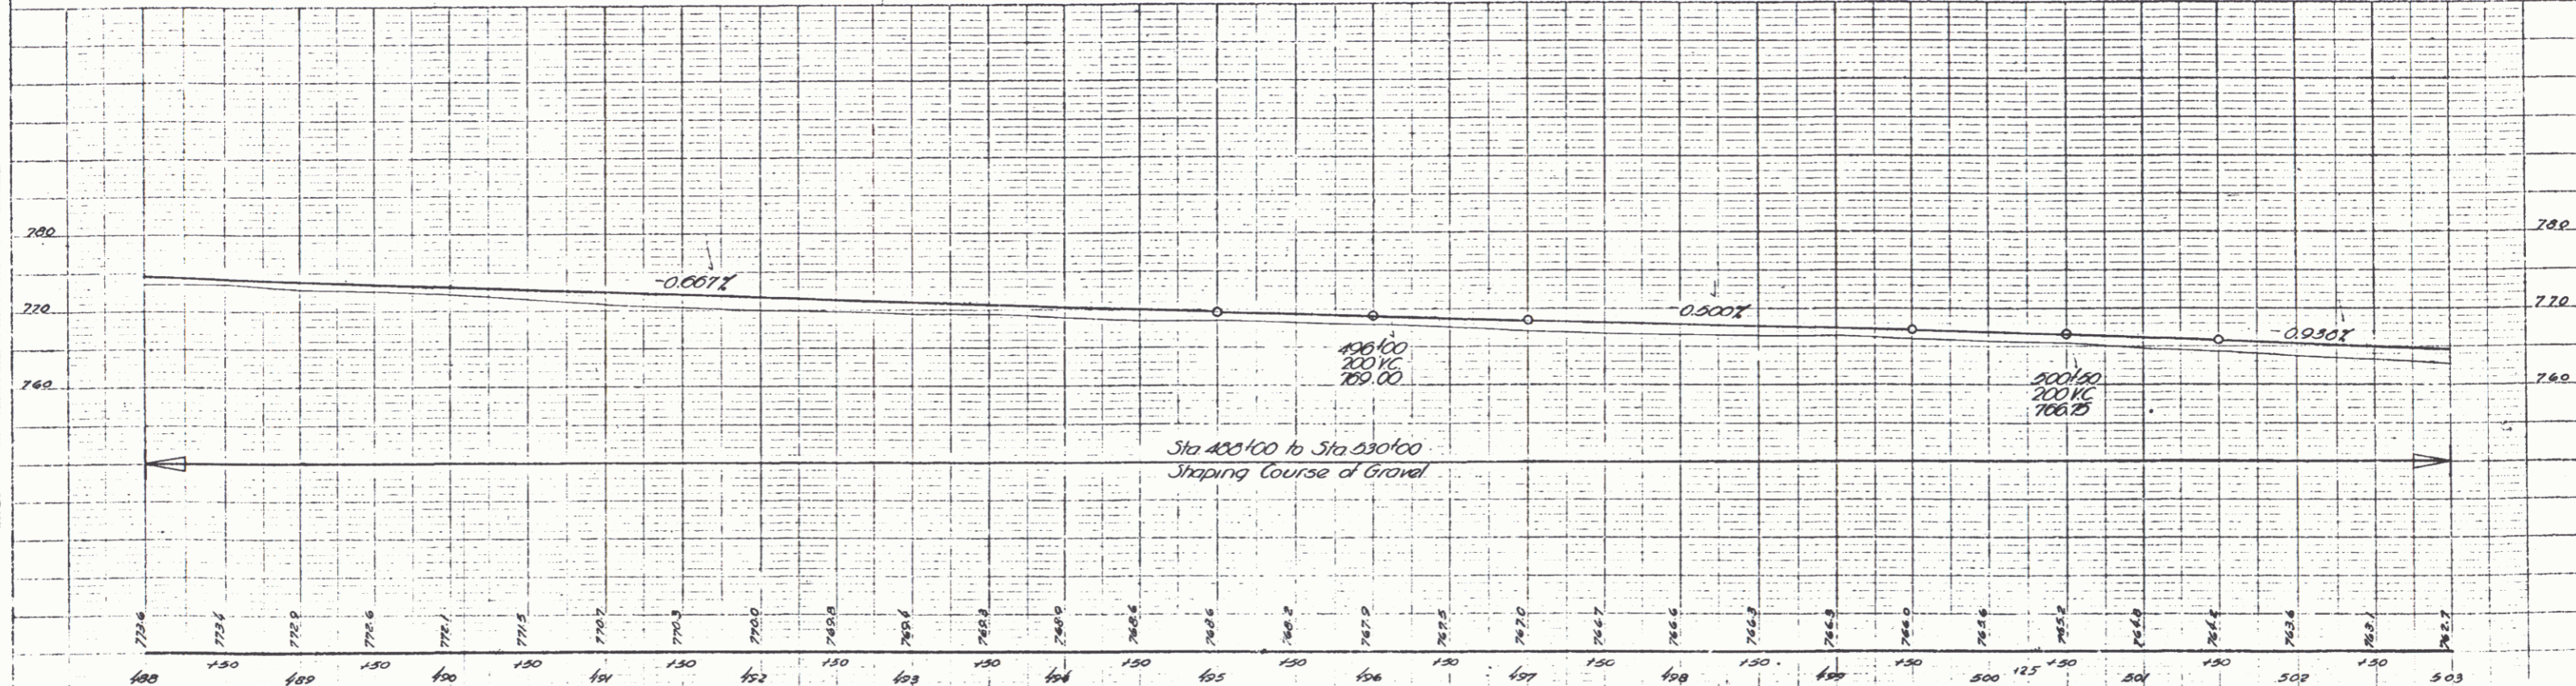

T.B.M. Spike in Power Pole #166 15.5 Ft. Lt. Sta. 482+20 Elevation 777.22
T.B.M. Spike in Power Pole #169 16 Ft. Lt. Sta. 488+30 Elevation 773.88
DM 56 Brass Spike in Root Twin 15" Elm 41 Ft. Lt. Sta. 495+60 Elevation 767.69

DORSET-RUPERT - PLANET
Series F no. 154(9)
sheet 10 of 195 sheets