
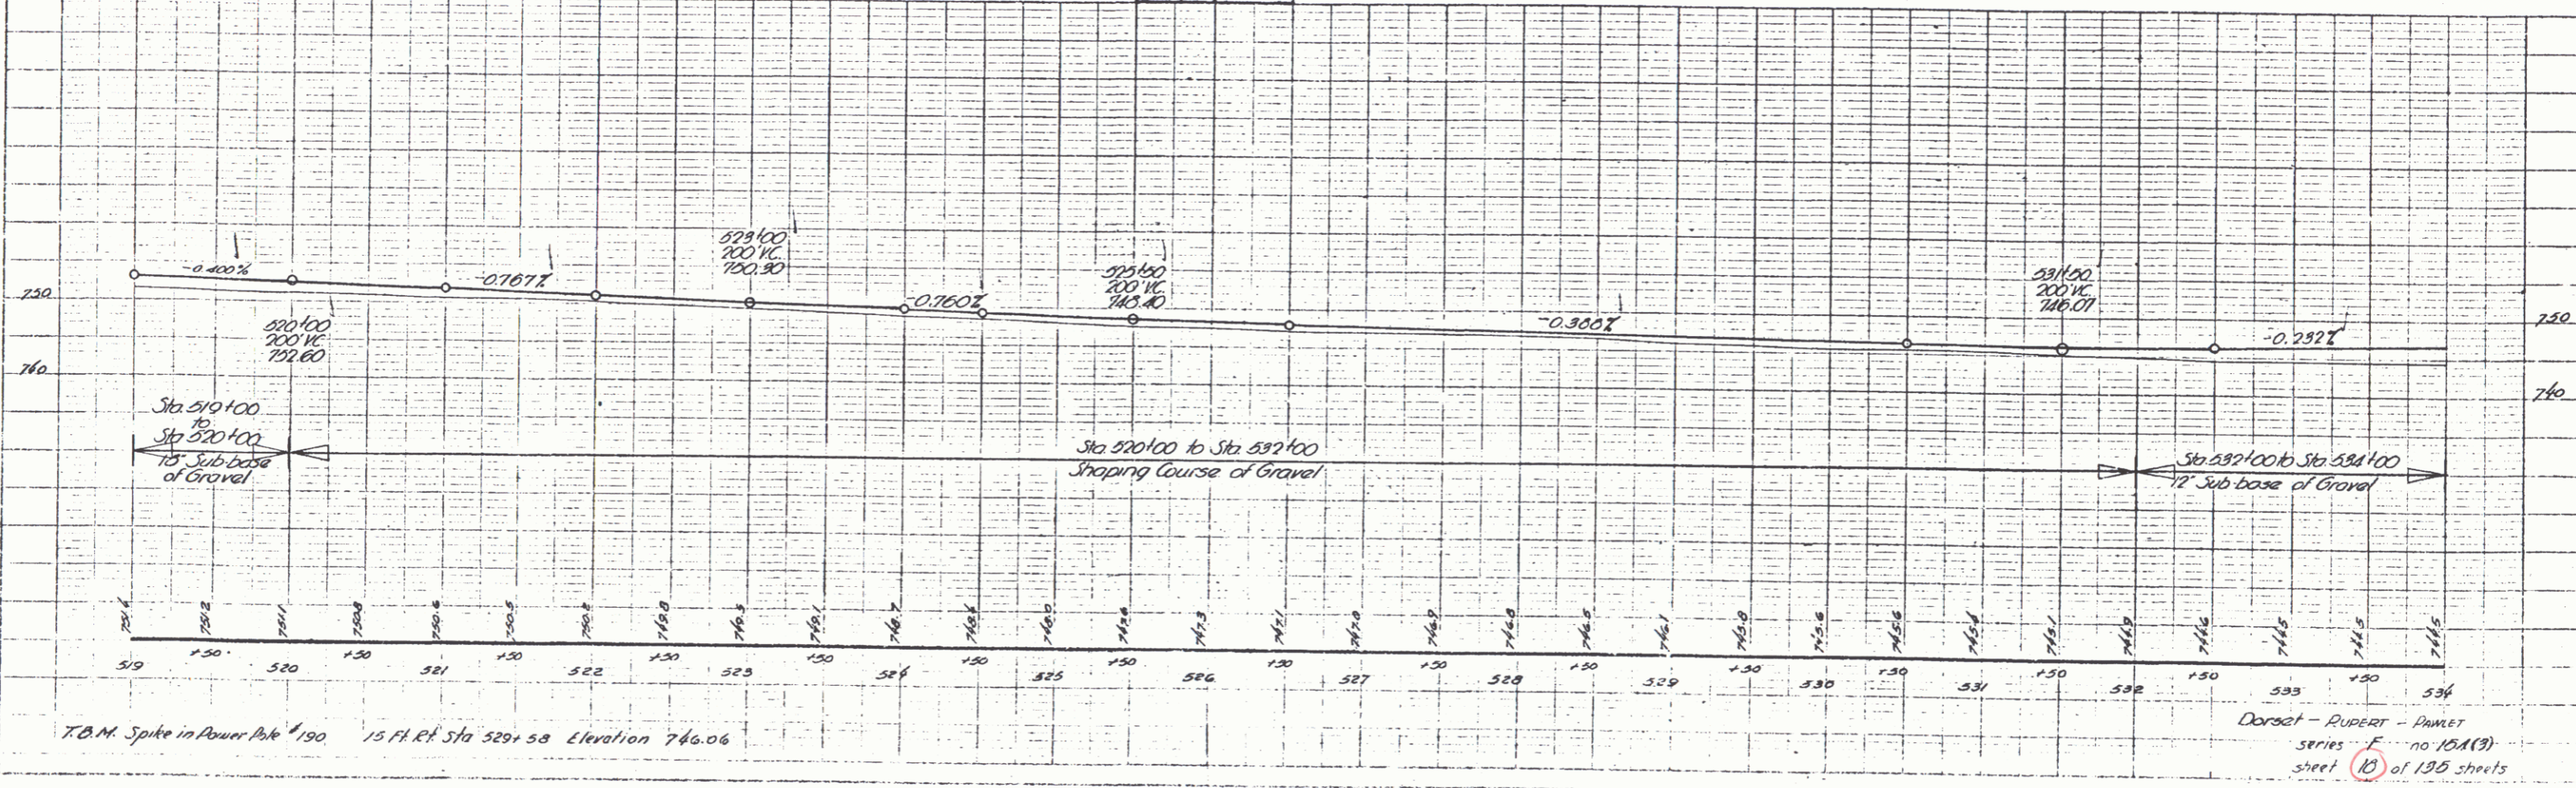


CONSTRUCT DRIVE  
519+50 LI

10A(9) 1947 10 195

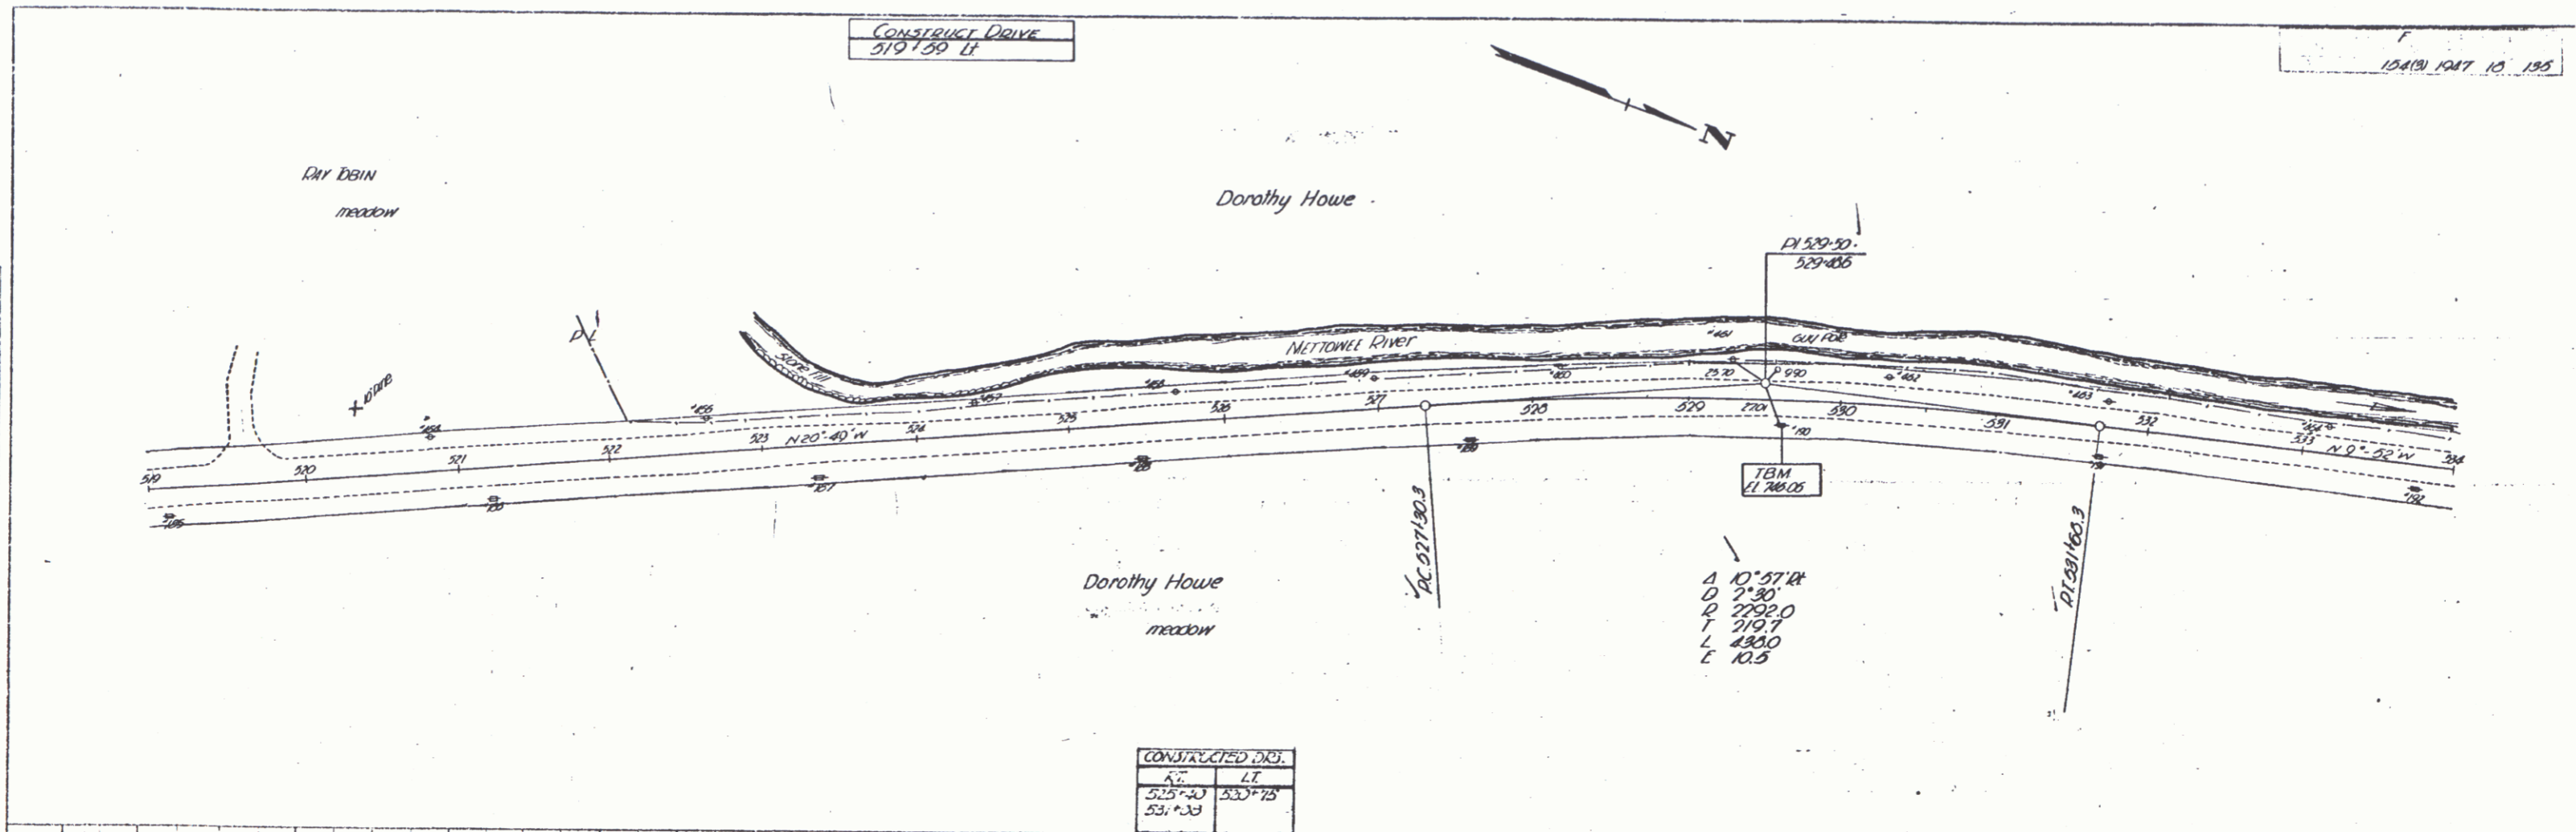

PLAN  
DATE: 1947  
BY: R. F. PAMET  
NO. 10A(9)

Profile  
Scale: 1" = 10'  
Date: 1947  
By: R. F. PAMET

Dorset - RUPERT - PAMET  
series F no 10A(9)  
sheet 10 of 195 sheets