


CONSTRUCT DRIVES	
LEFT	RIGHT
543+87	546+00
544+77	547+18
545+75	548+09
CONSTRUCTED DRIVE	
54+96	547+06
543+75	
544+70	

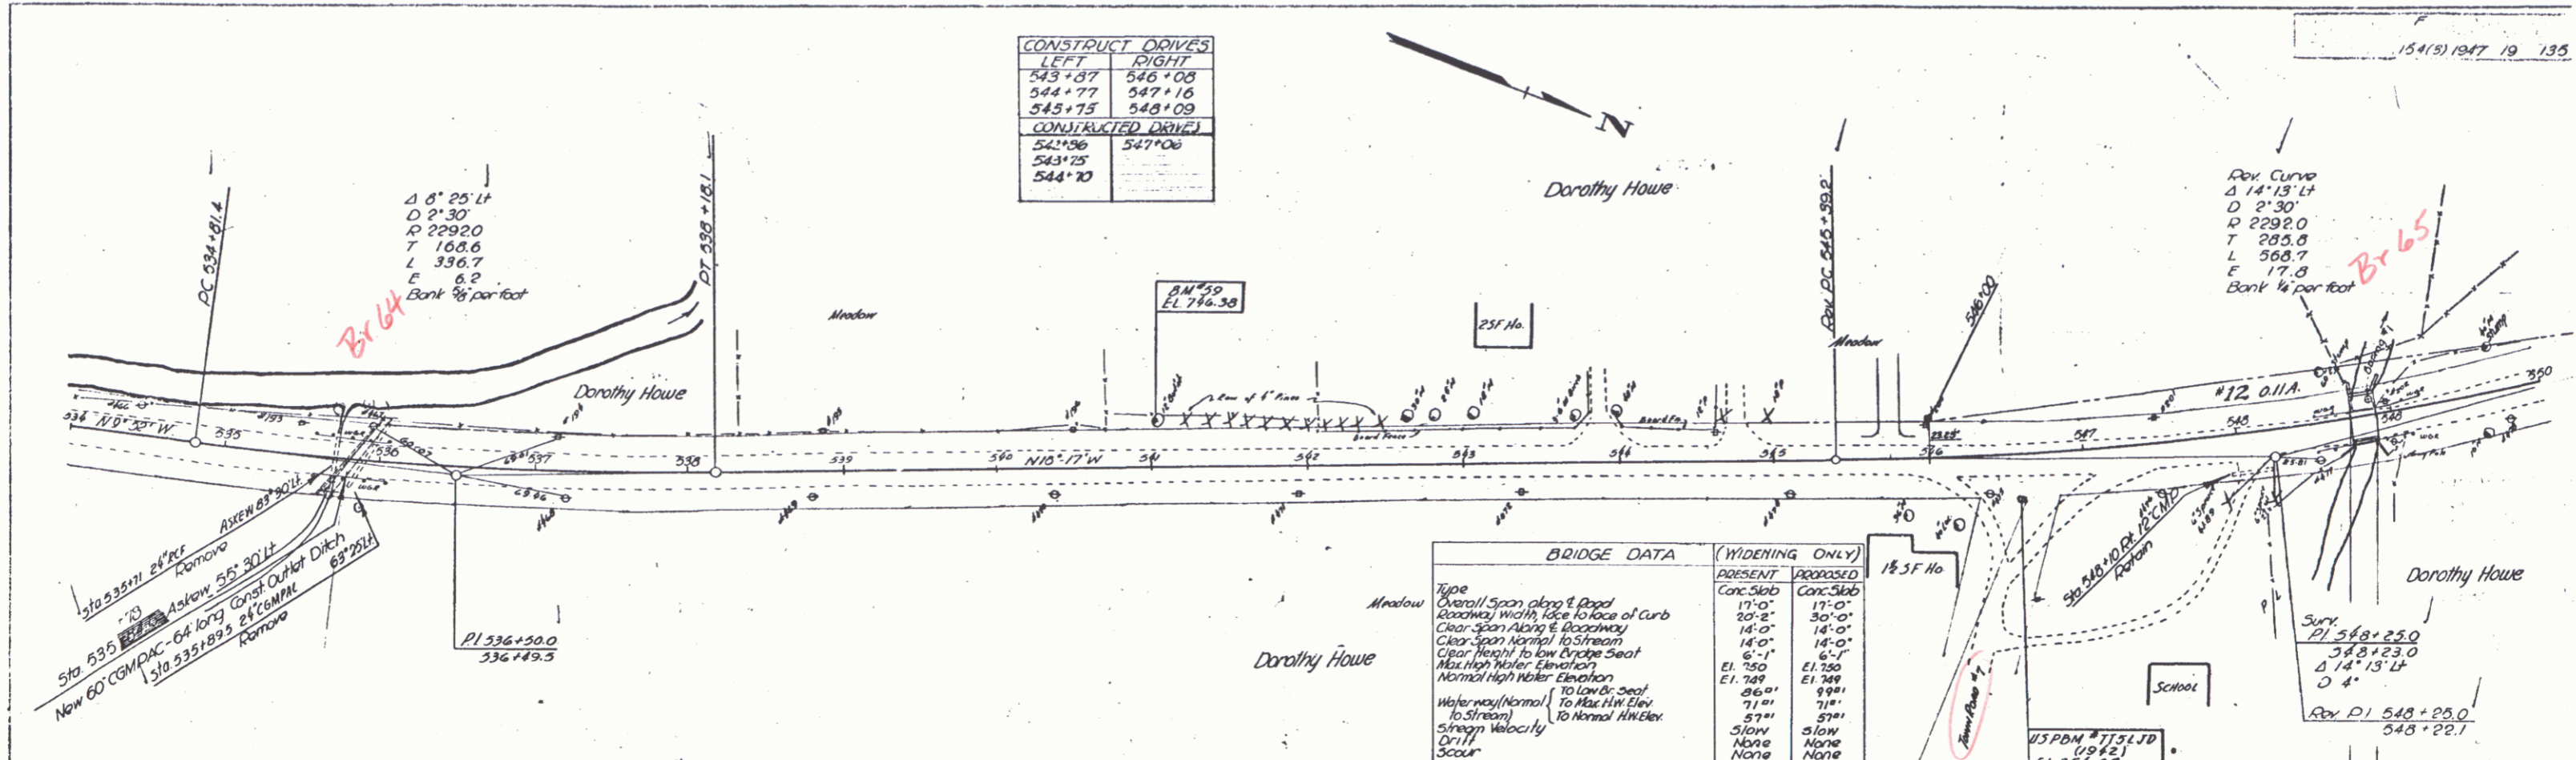

Author: Ruper  
 Engineer: Ruper  
 Date: 9-21-48  
 Sheet: 19 of 135

Author: Ruper  
 Engineer: Ruper  
 Date: 9-21-48  
 Sheet: 19 of 135

PARCEL	INSTRUMENT	DATE	GRANTOR	GRANTEE	RECORDED	REMARKS
12 A	W. D. O. E.	9-21-48	DOROTHY HOWE	ST. OF VT.	28 567-568 9-30-48	