



154(9) 1947 21 195

CONSTRUCT DOWNS	
LT	LE
564+00	564+35
565+77	
TOWNSHIP DT 565+33	

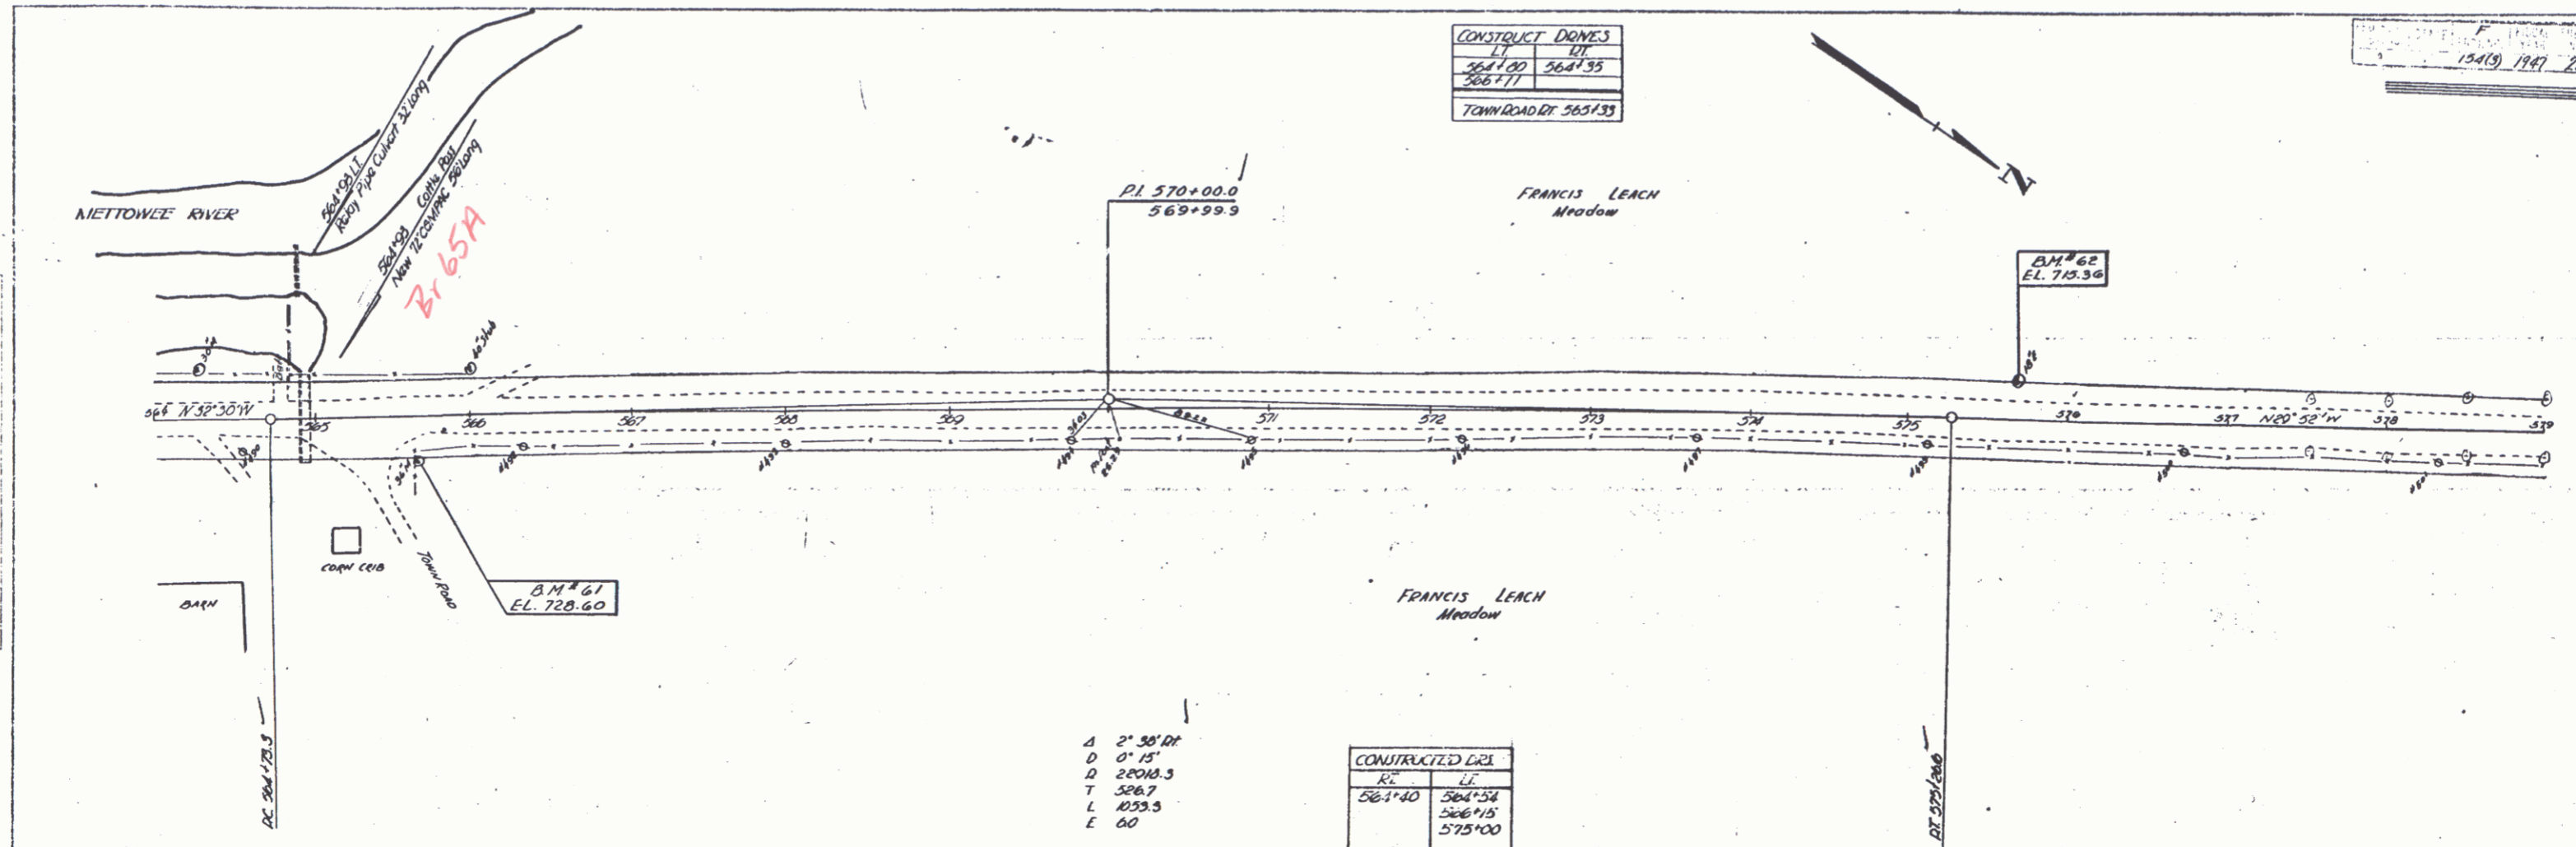

A 2' 50" RT  
 D 0' 15"  
 D 22044.3  
 T 526.7  
 L 1033.3  
 E 60

CONSTRUCTED CRI	
RC	LE
564+40	564+34
	566+15
	575+00

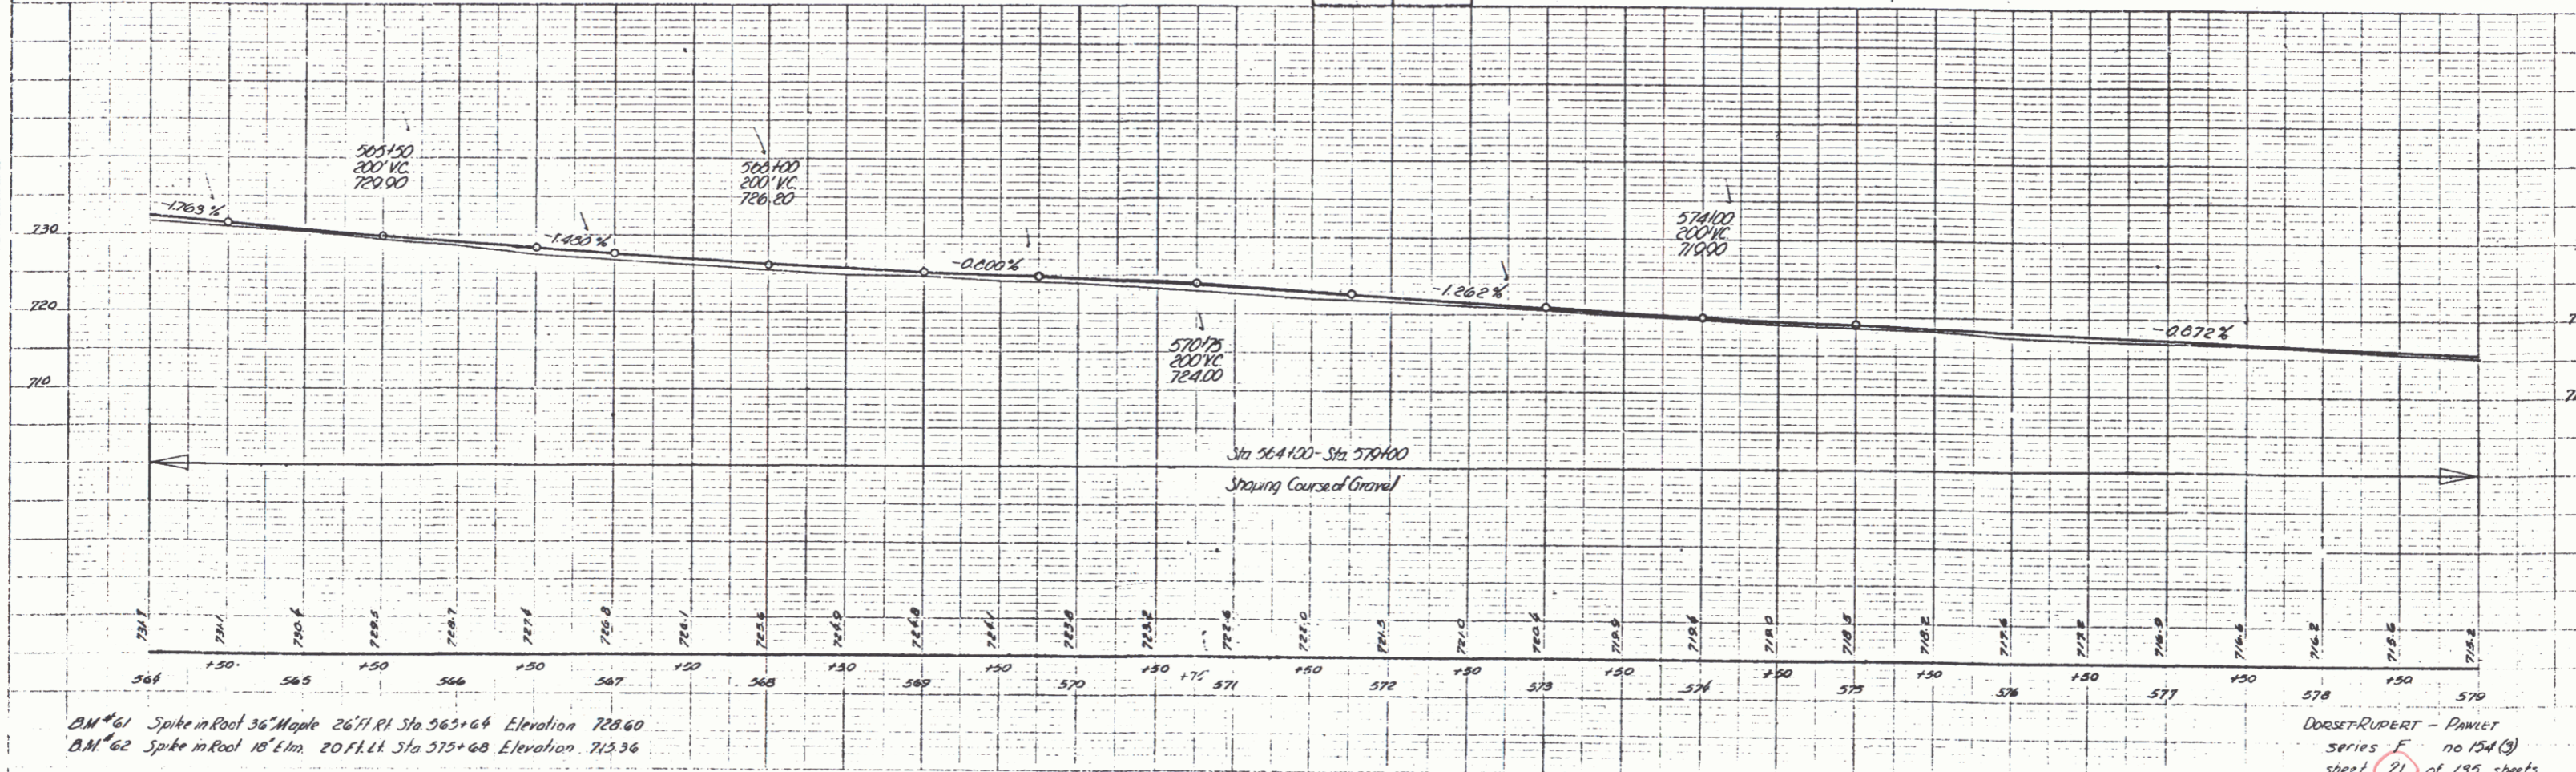

BM #61 Spike in Root 36 Maple 2671 RL Sta 565+64 Elevation 729.60  
 BM #62 Spike in Root 18 Elm 2071 RL Sta 575+68 Elevation 713.36

DORSET RUPERT - PLANET  
 SERIES F no 154 (9)  
 sheet 21 of 155 sheets