



1549, 1947, 25, 135

CONSTRUCT DRIVES	
LT	RT
629+45	626+50
629+90	627+50
631+00	631+00
631+30	

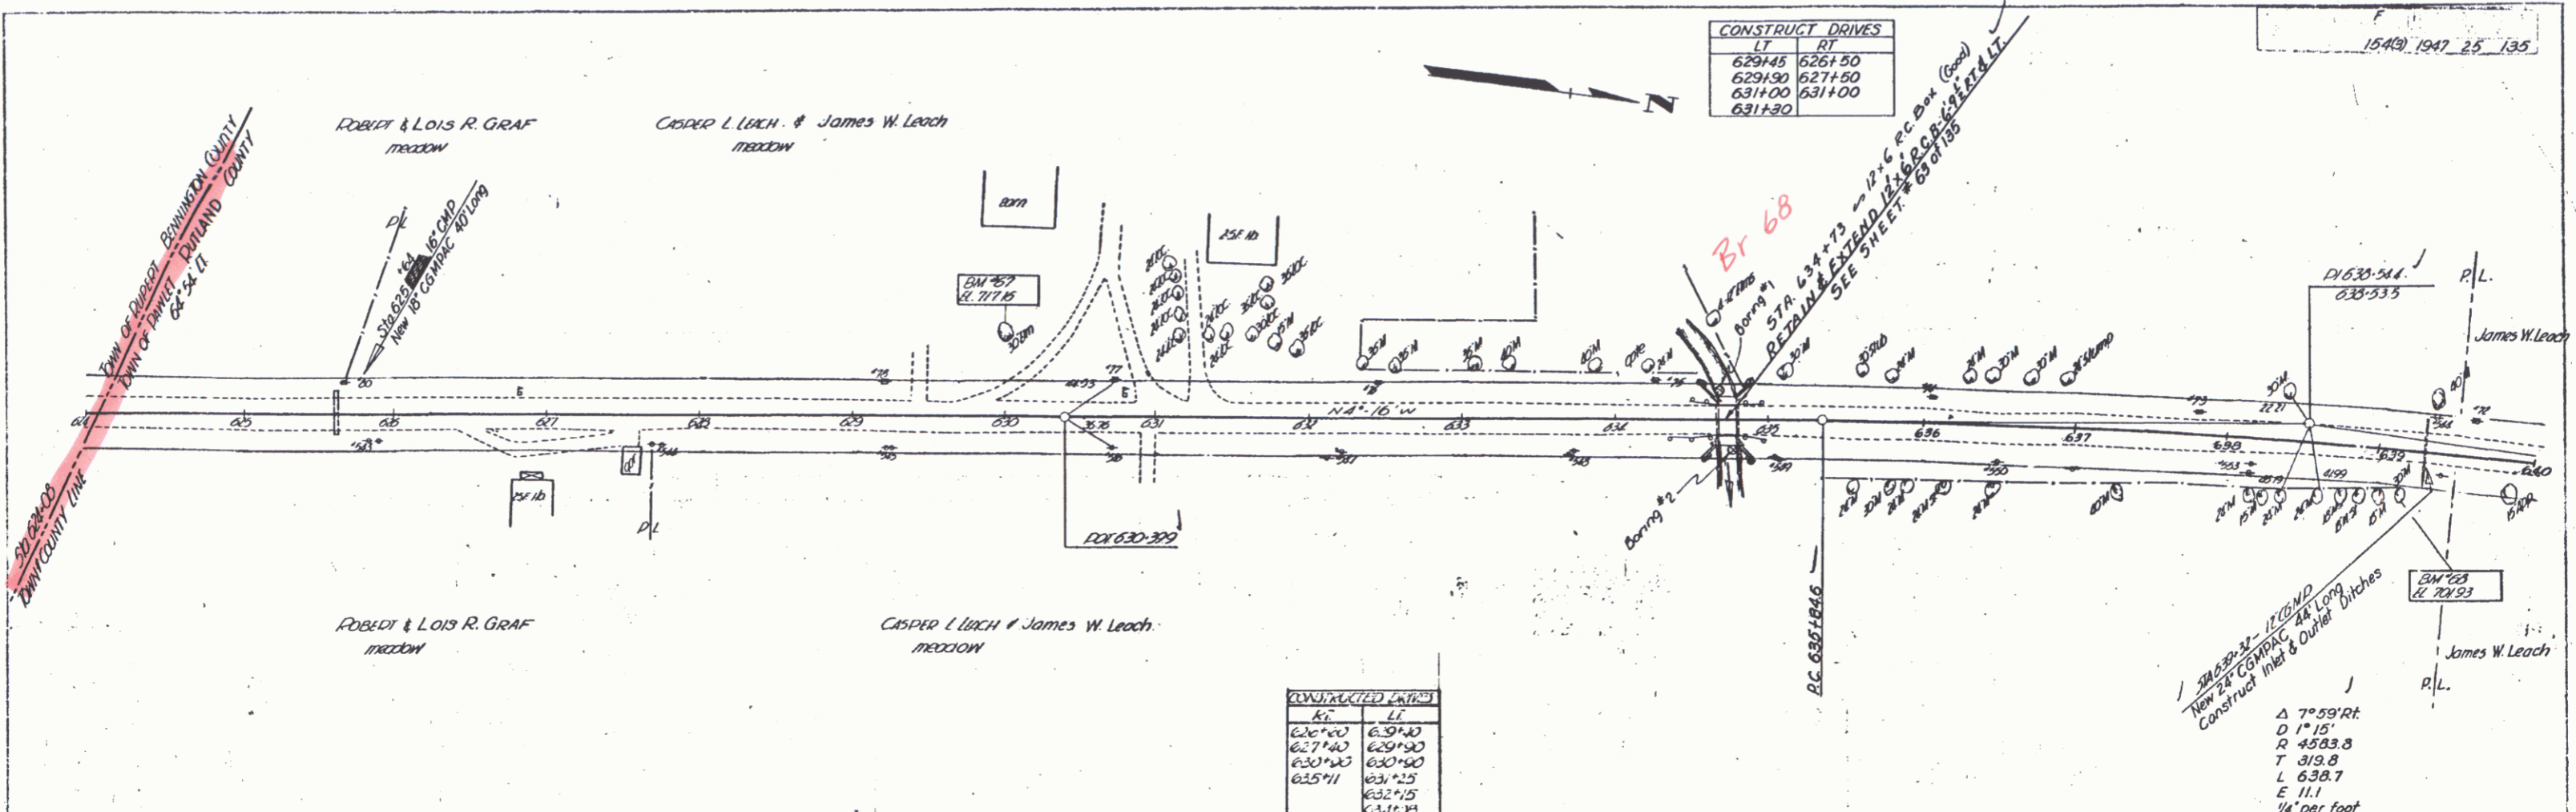

CONSTRUCTED CURVES	
LT	RT
626+00	629+40
627+40	629+90
630+40	630+90
631+25	632+15
632+15	632+15

$\Delta$  7° 59' RT  
 $D$  1" 15'  
 $R$  4933.8  
 $T$  319.8  
 $L$  638.7  
 $E$  11.1  
 1/4" per foot

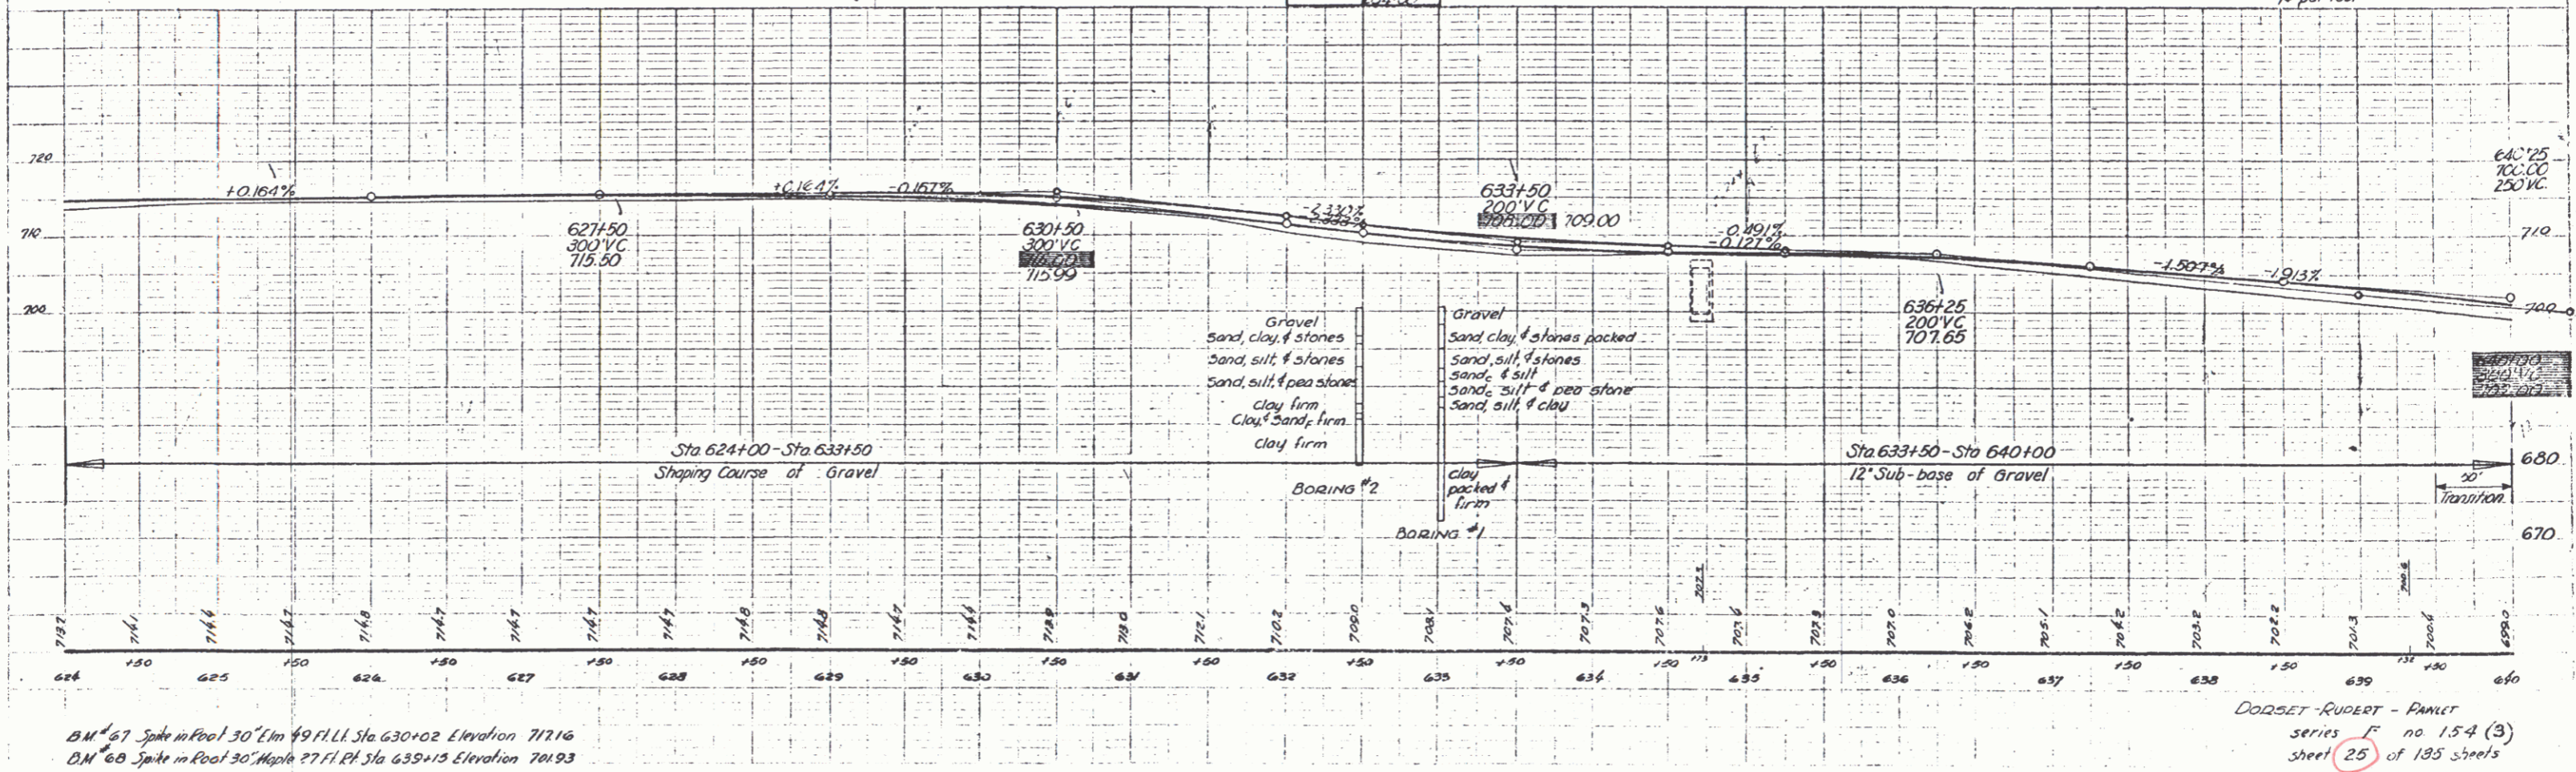

BM #67 Spike in Post 30' Elm 49 FILL Sta 630+02 Elevation 717.16  
 D.M. #68 Spike in Post 30' Maple 77'1" Sta 635+13 Elevation 704.93

DODSET-RUDERT - PLANET  
 series F no 154 (3)  
 sheet 25 of 185 sheets