
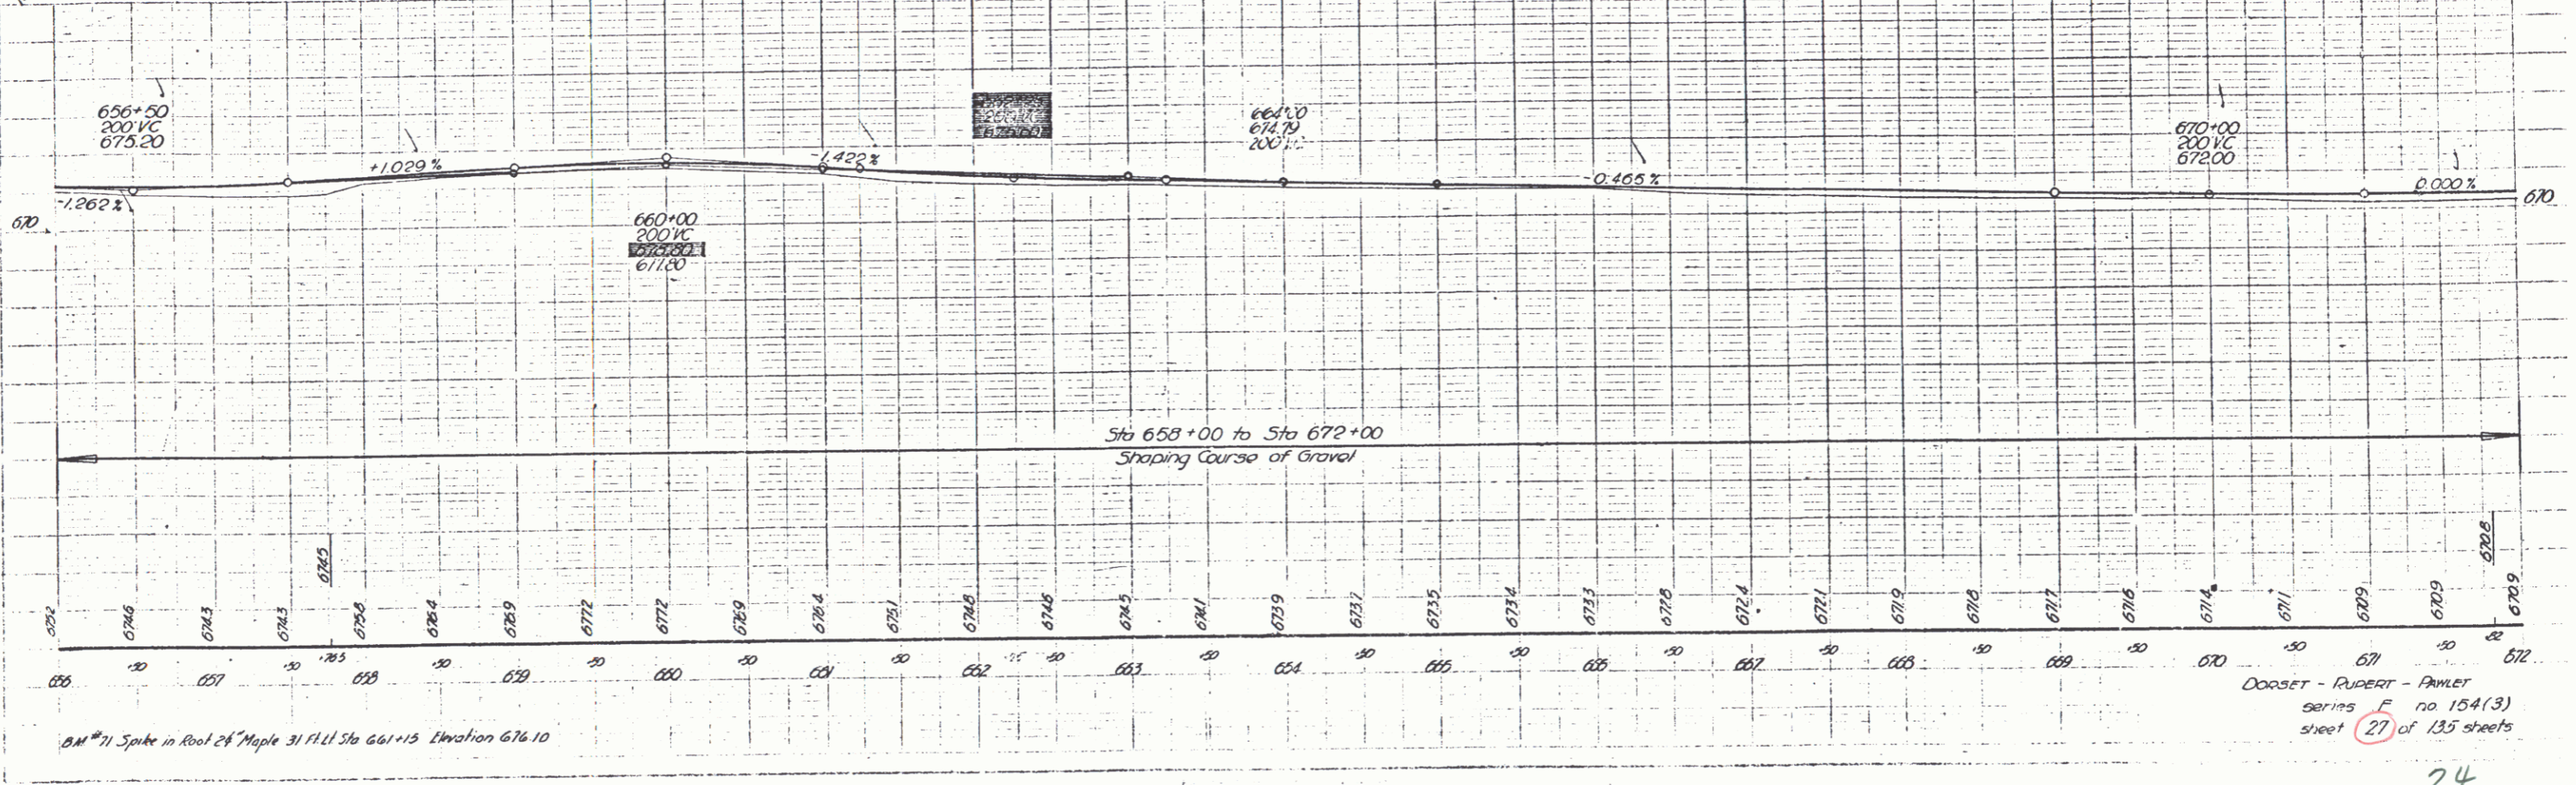


CONSTRUCT DRIVES	
LEFT	RIGHT
661+93	662+40
663+00	665+70

CONSTRUCTED DRIVE	
RT	LT
662+25	661+95
	662+90

Δ 30° 56' 04"
 D 4' 30"
 R 1273.6
 T 376.3
 L 731.9
 E 54.4
 Bank 1/2 per foot

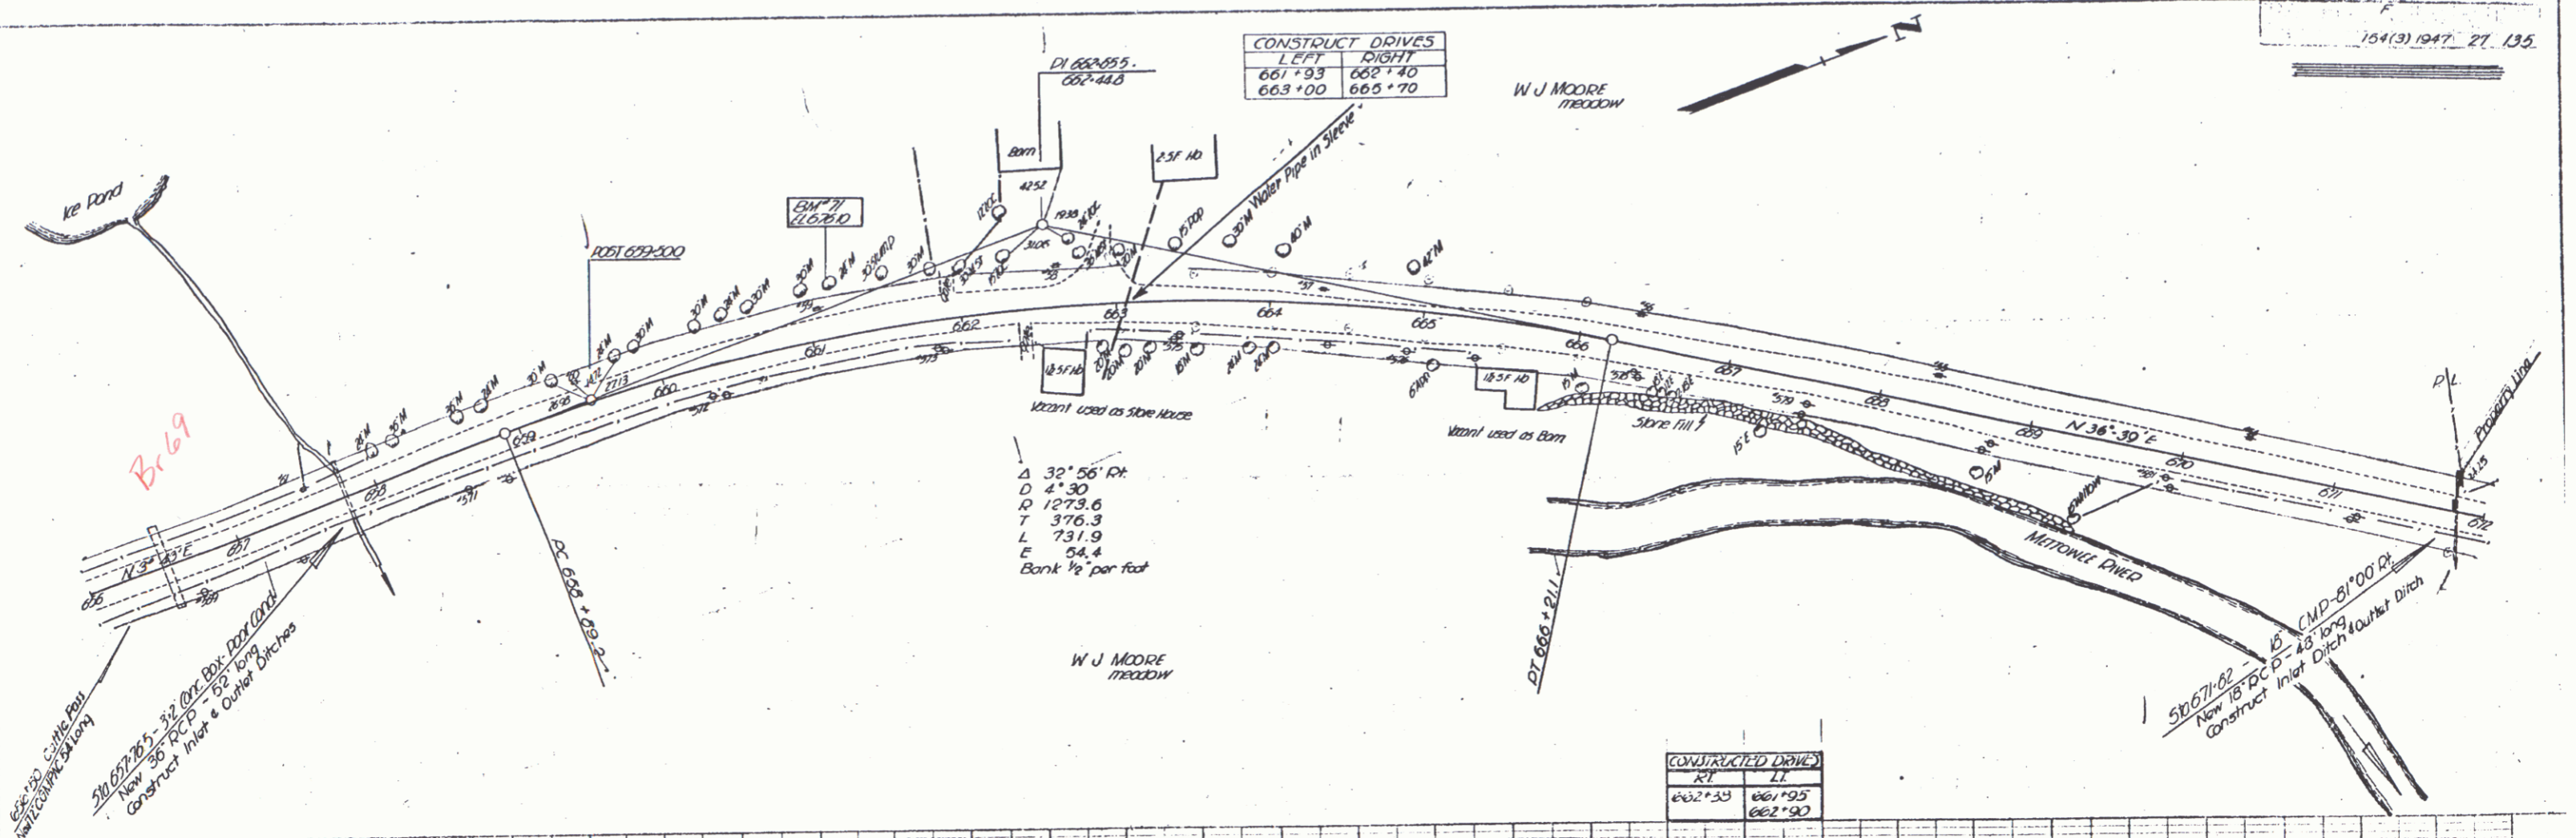

Plan
 Profile
 1-44
 5-44
 5-47
 5-47

Plan
 Profile
 1-44
 5-44
 5-47
 5-47

BM #71 Spike in Root of Maple 31 (111) Sta 661+15 Elevation 676.10

DOORSET - RUPERT - FAWCETT
 Series F no 154(3)
 sheet 27 of 135 sheets