


CONSTRUCT DRIVES	
LEFT	RIGHT
726+30	719+50 to 729+00
728+00	723+00
730+10	730+75
730+75	730+88
730+88	730+65
729+65	

CONSTRUCTED JCI	
RI	LI
723+00	727+20
720+20	725+35

PARCEL	INSTRUMENT	DATE	GRANTOR	GRANTEE	BOOK	PAGE	DATE	REMARKS
49-A (Sheet 39) 29C	W. D. O. E.	9-21-48	RALPH E. & MARY E. KINNEY	ST. OF VT.	29	233	5-30-58	
20-A (Sheet 39)	W. D. O. E.	9-21-48	RUSSELL A. CLARK	ST. OF VT.				

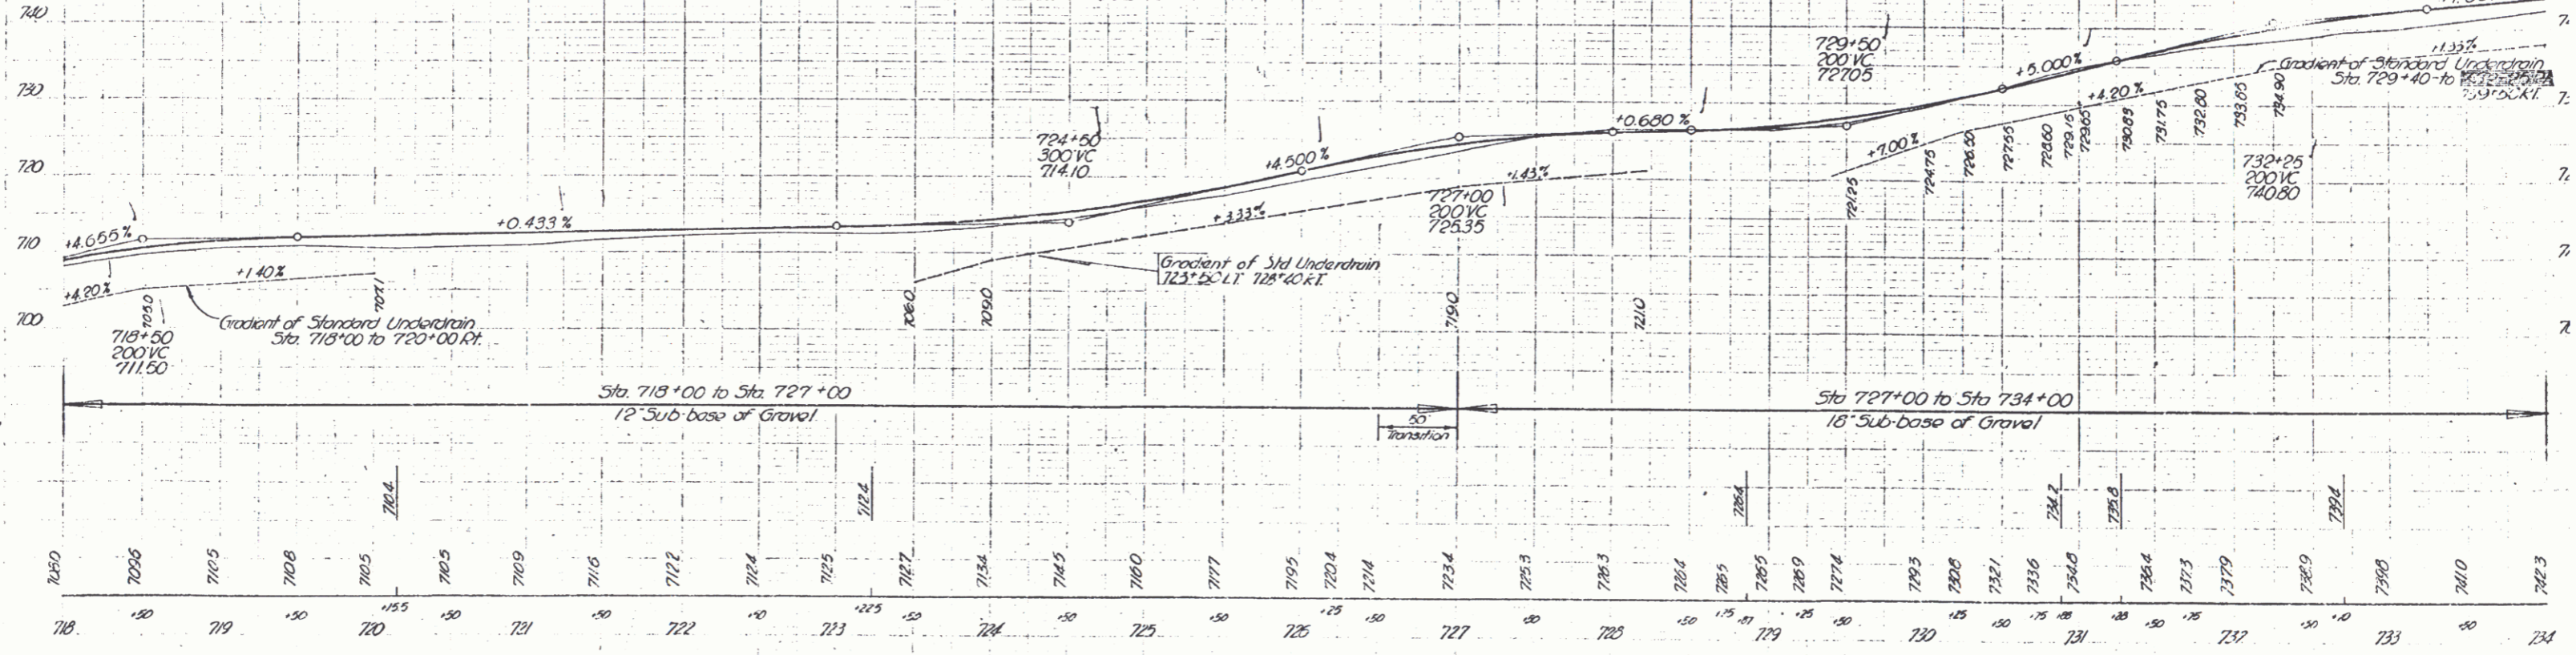

BM #79 Spike in Root of Maple 25' RI Sta 722+19 LL 714.37
 BM #80 Spike in Root of Oak 20' RI Sta 721+04 LL 717.99

DEPOSIT - RUDELI - DAWLET
 20125 F. NO 124(2)
 SHEET 31 of 135 sheets