


PARCEL	INSTRUMENT	DATE	GRANTOR	GRANTEE	RECORDED	REMARKS
A	W.D.O.E	12-15-61	JESSIE M SMITH	ST OF NY	26 106	1-15-62

NOTE: Contractor will be required to use not in excess of 1000 cu. yd. of excavation in making an embankment approximately 0.6 miles north of project on Route 30


REV. CURVE  
 Δ 15° LT  
 D 7°  
 R 819.0  
 T 107.8  
 L 214.3

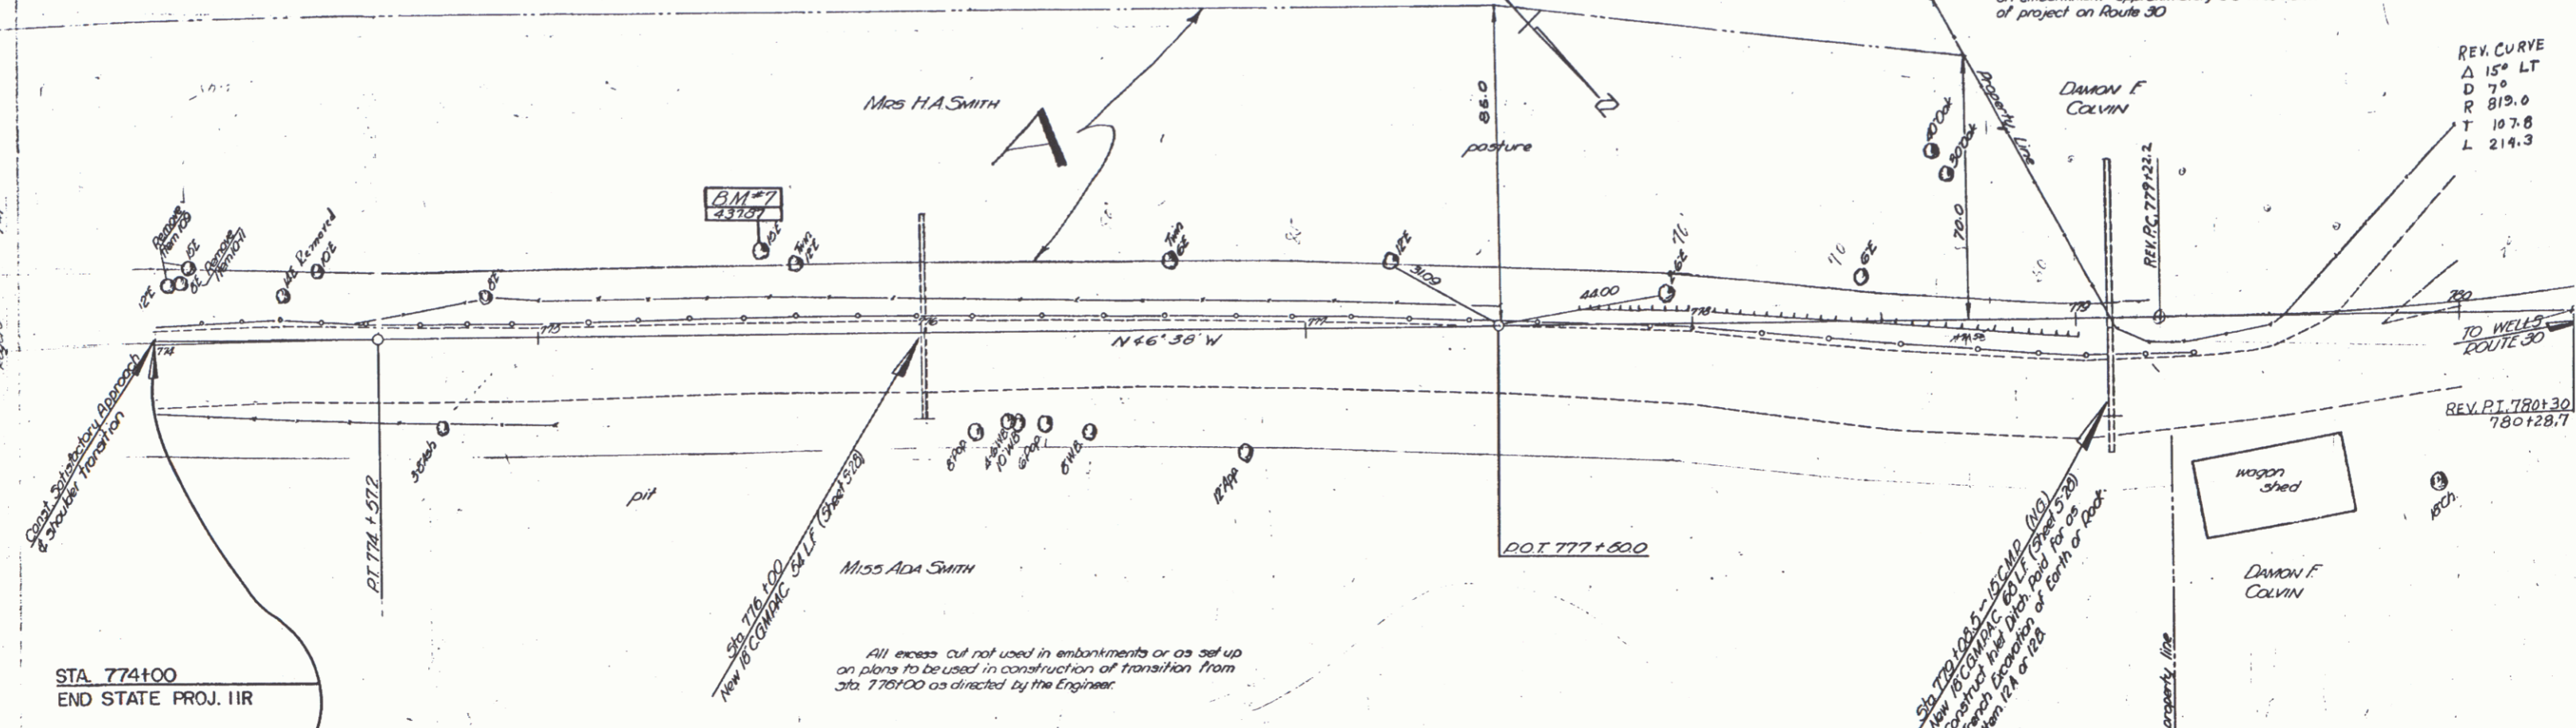

All areas cut not used in embankments or as set up on plans to be used in construction of transition from Sta. 776+00 as directed by the Engineer.

Sta. 779+00 to 780+00  
 New 15' COMBAC. 25' LT (Spec. 5-78)  
 Connect to the Dotted line for the  
 proposed Excavation of Earth or Rock.  
 from 774 to 782

SCALE: HOR: 1"=20'  
 VER: 1"=5'

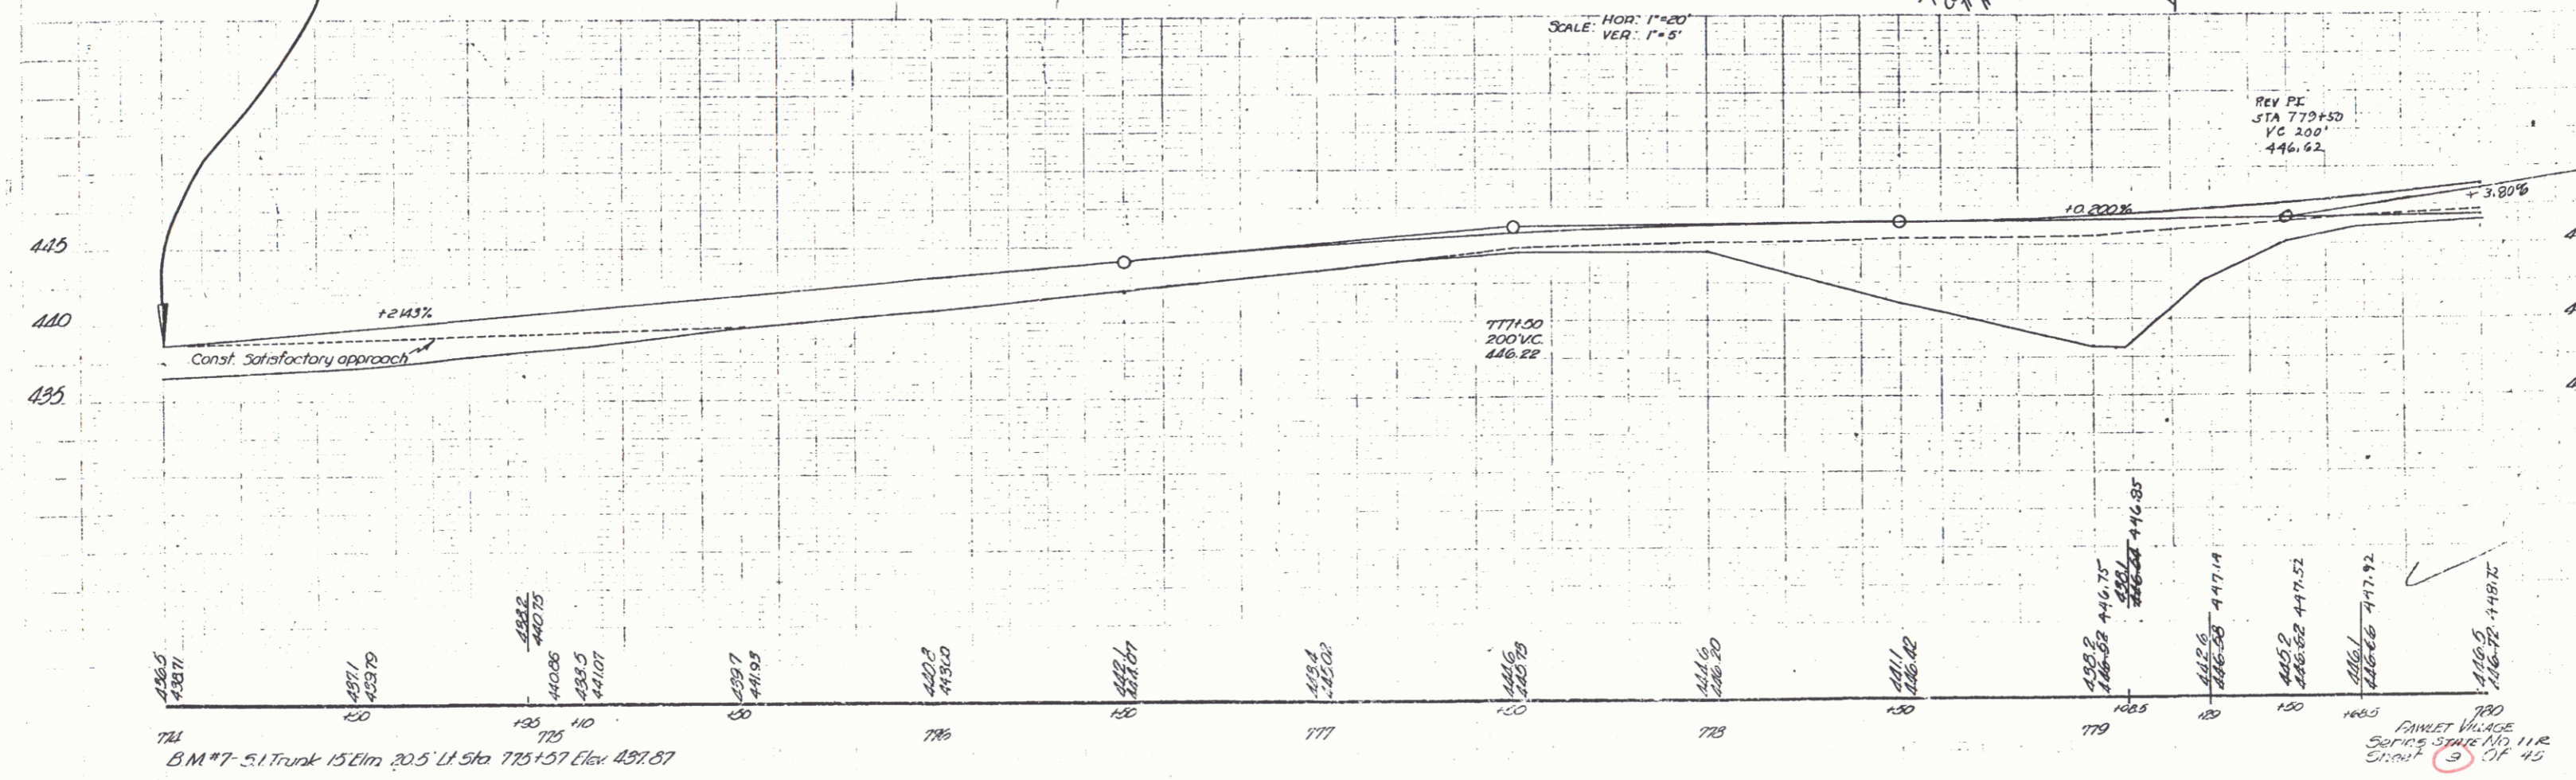

BM #7-5.1 Trunk 15' Lim. 30.5' Lt. Sta. 775+57 Elev. 437.87

FINLET VILLAGE  
 Series STATE NO. 11R  
 Sheet 3 OF 45