
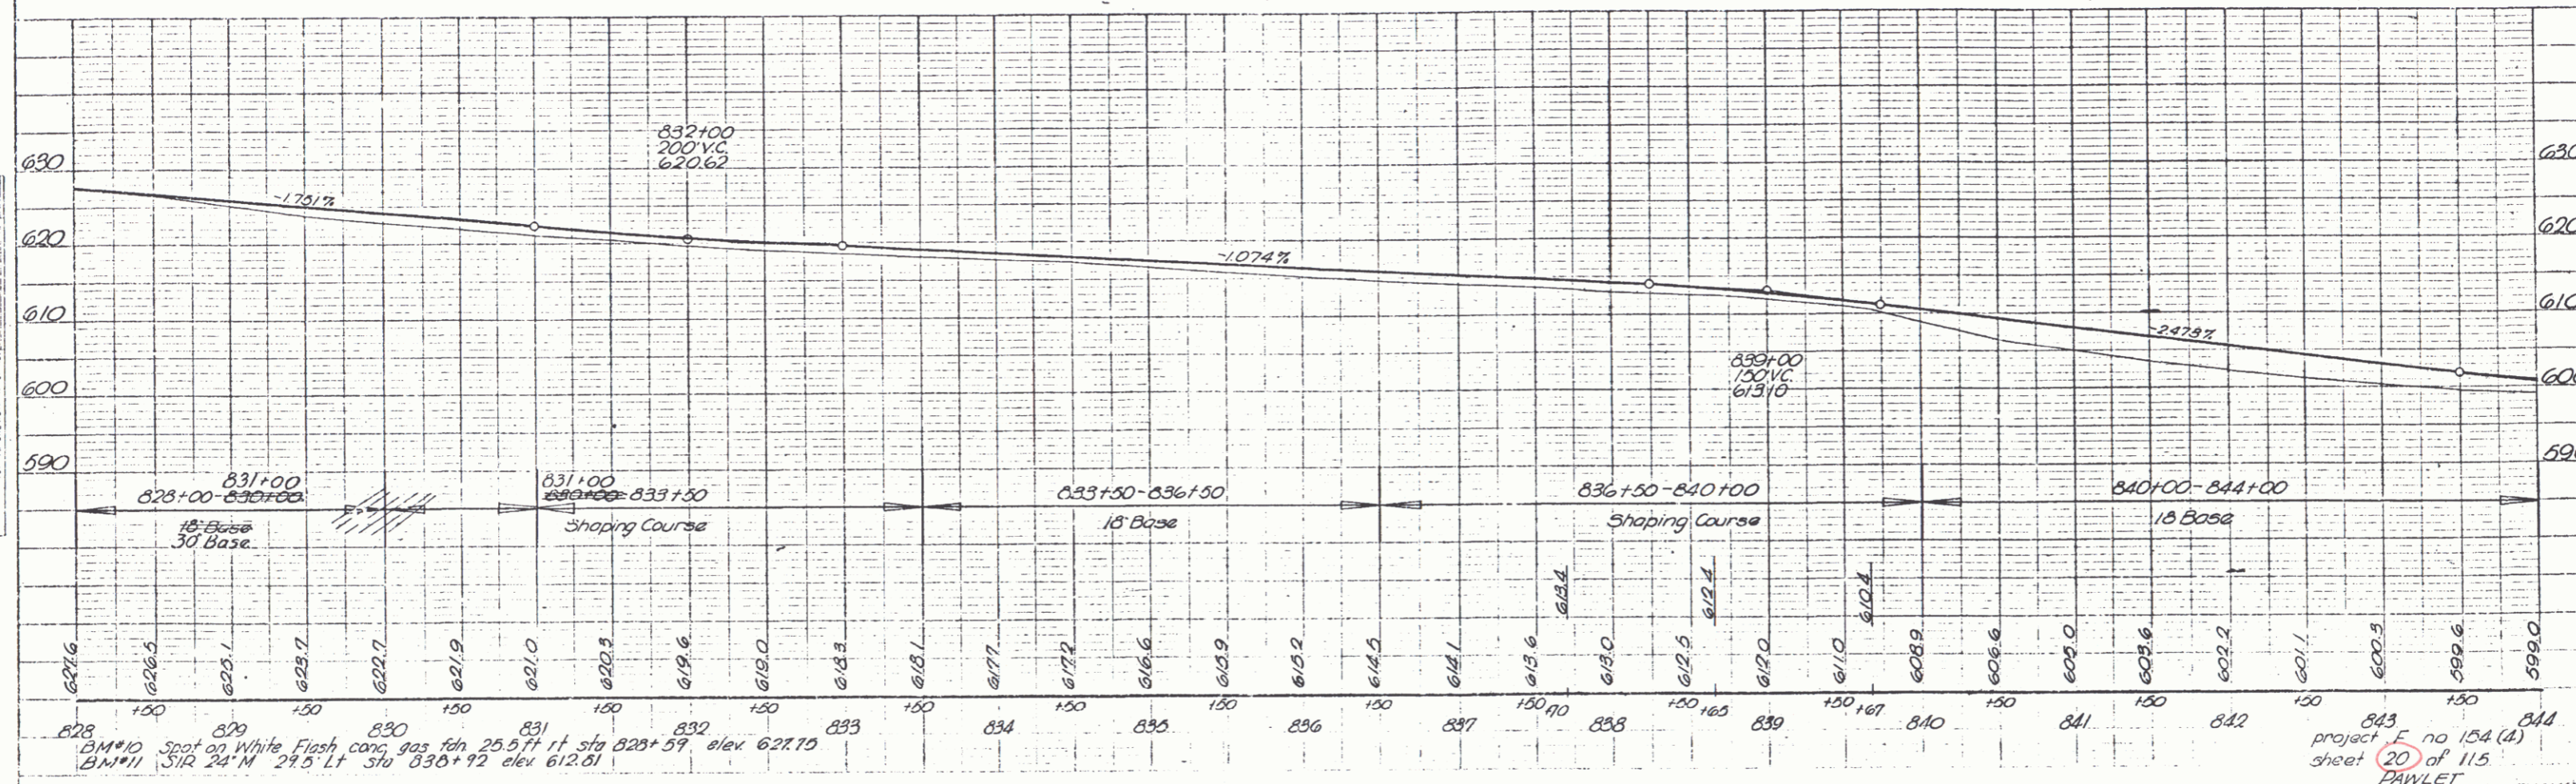


PLAN
 1" = 50'
 11/30

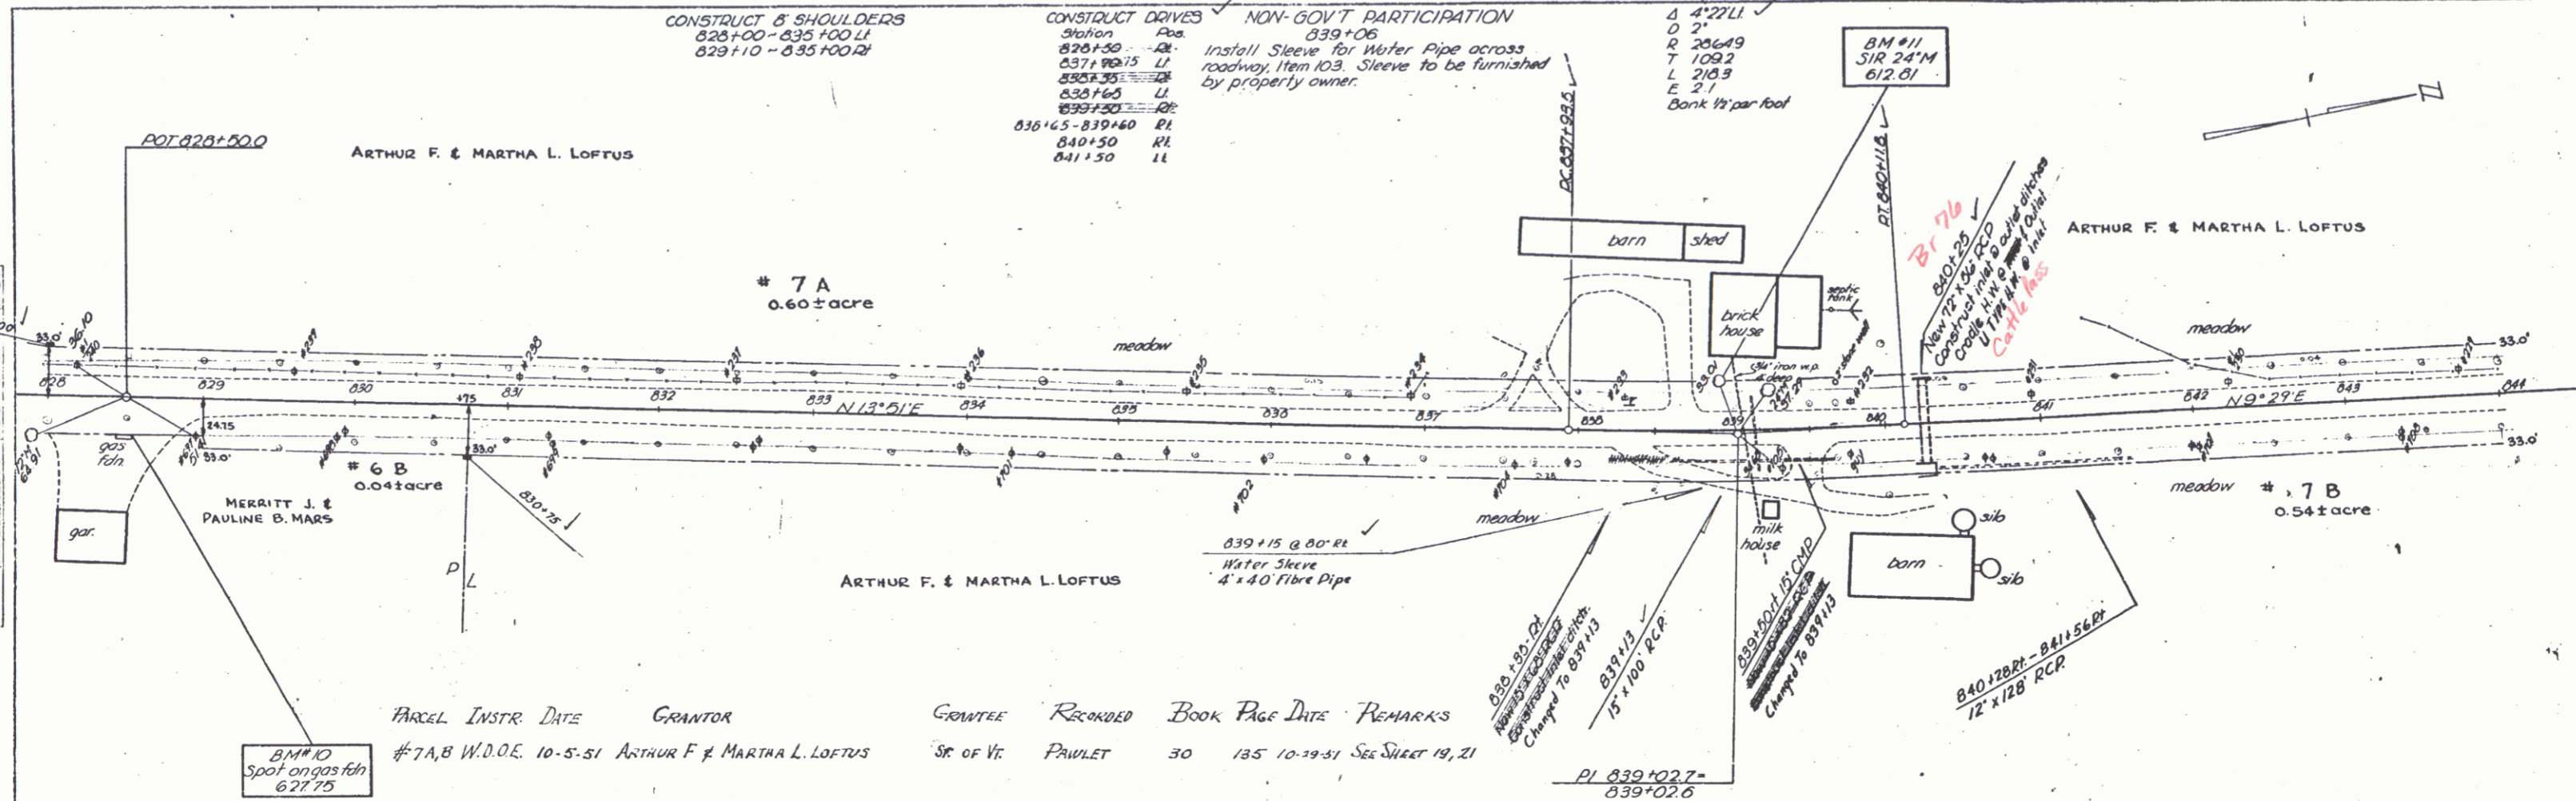

BM #10 spot on gas fnh 627.75
 BM #11 SIR 24" M 612.61
 843 project F no 154 (d) sheet 20 of 115 PAWLET