
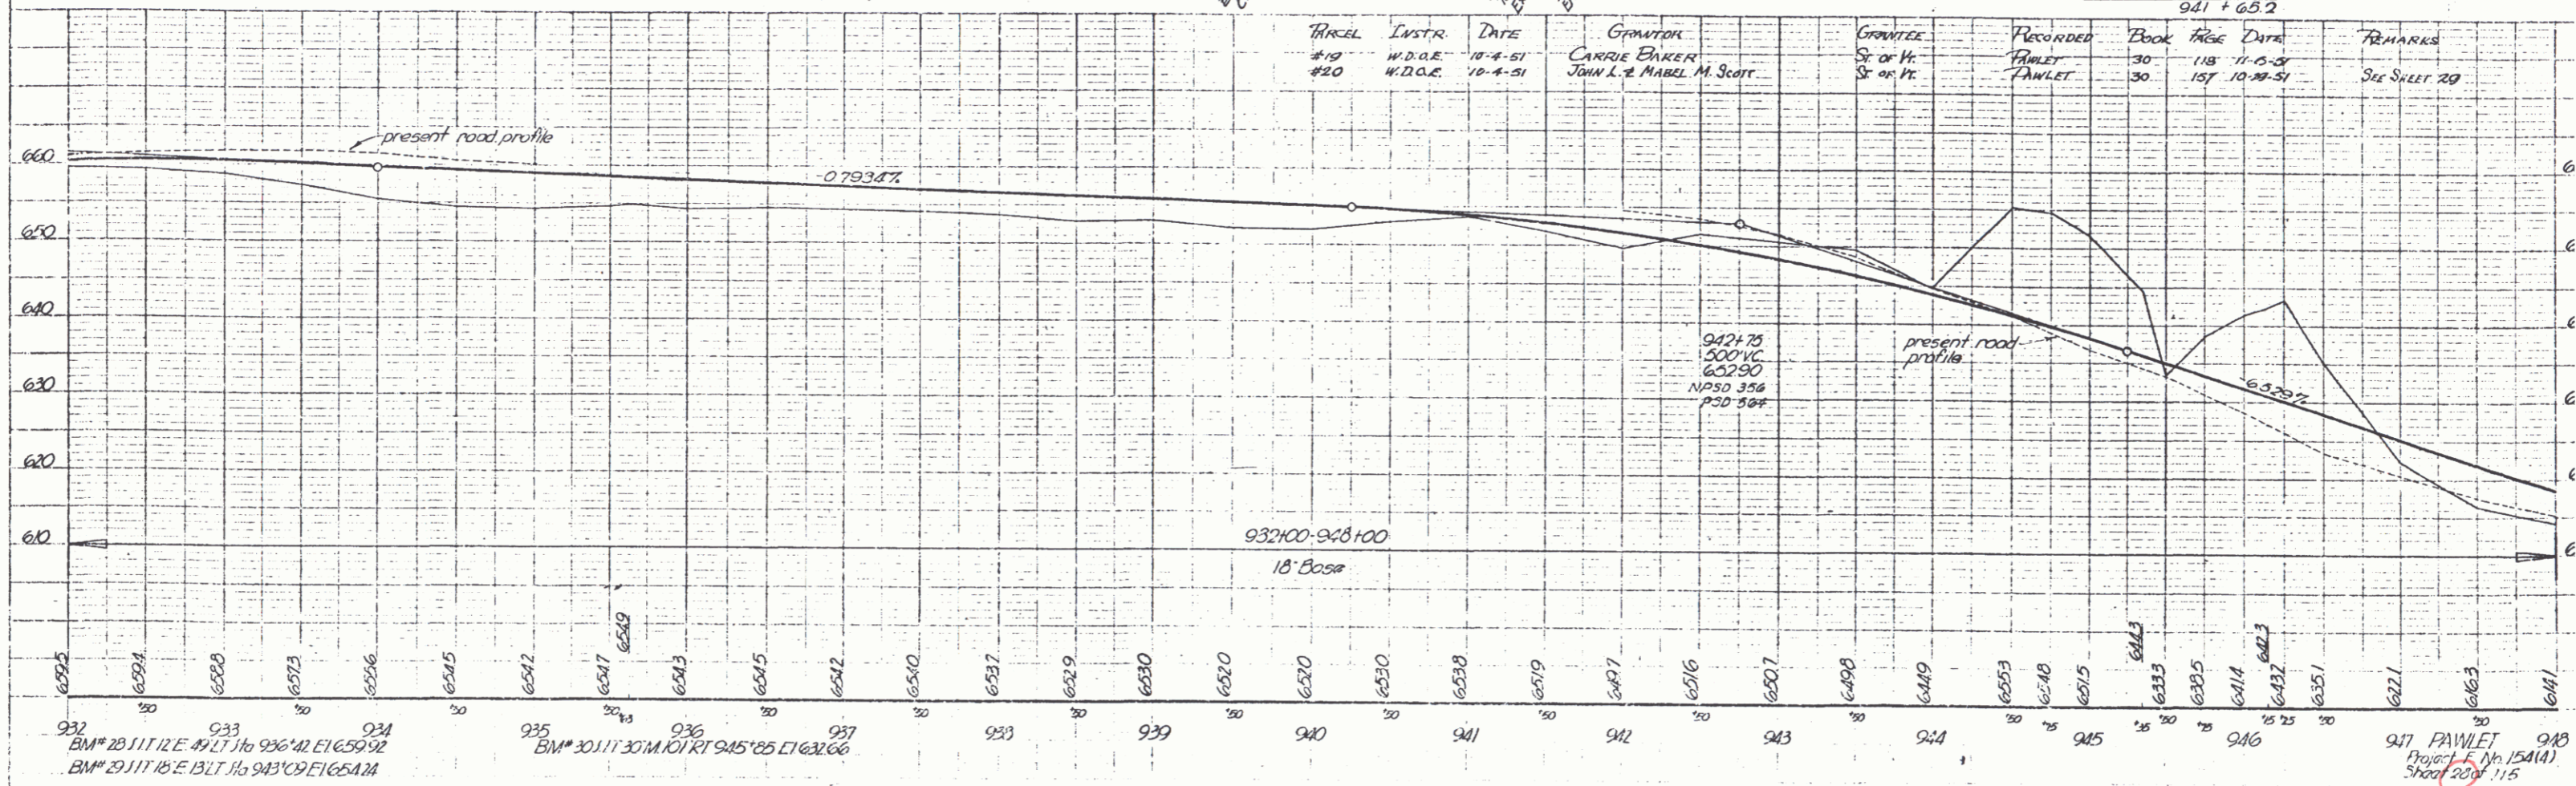


PLAN
 DATE: 11/20/54
 DRAWN BY: J. H. PAWLET
 CHECKED BY: J. H. PAWLET
 PROJECT: 115

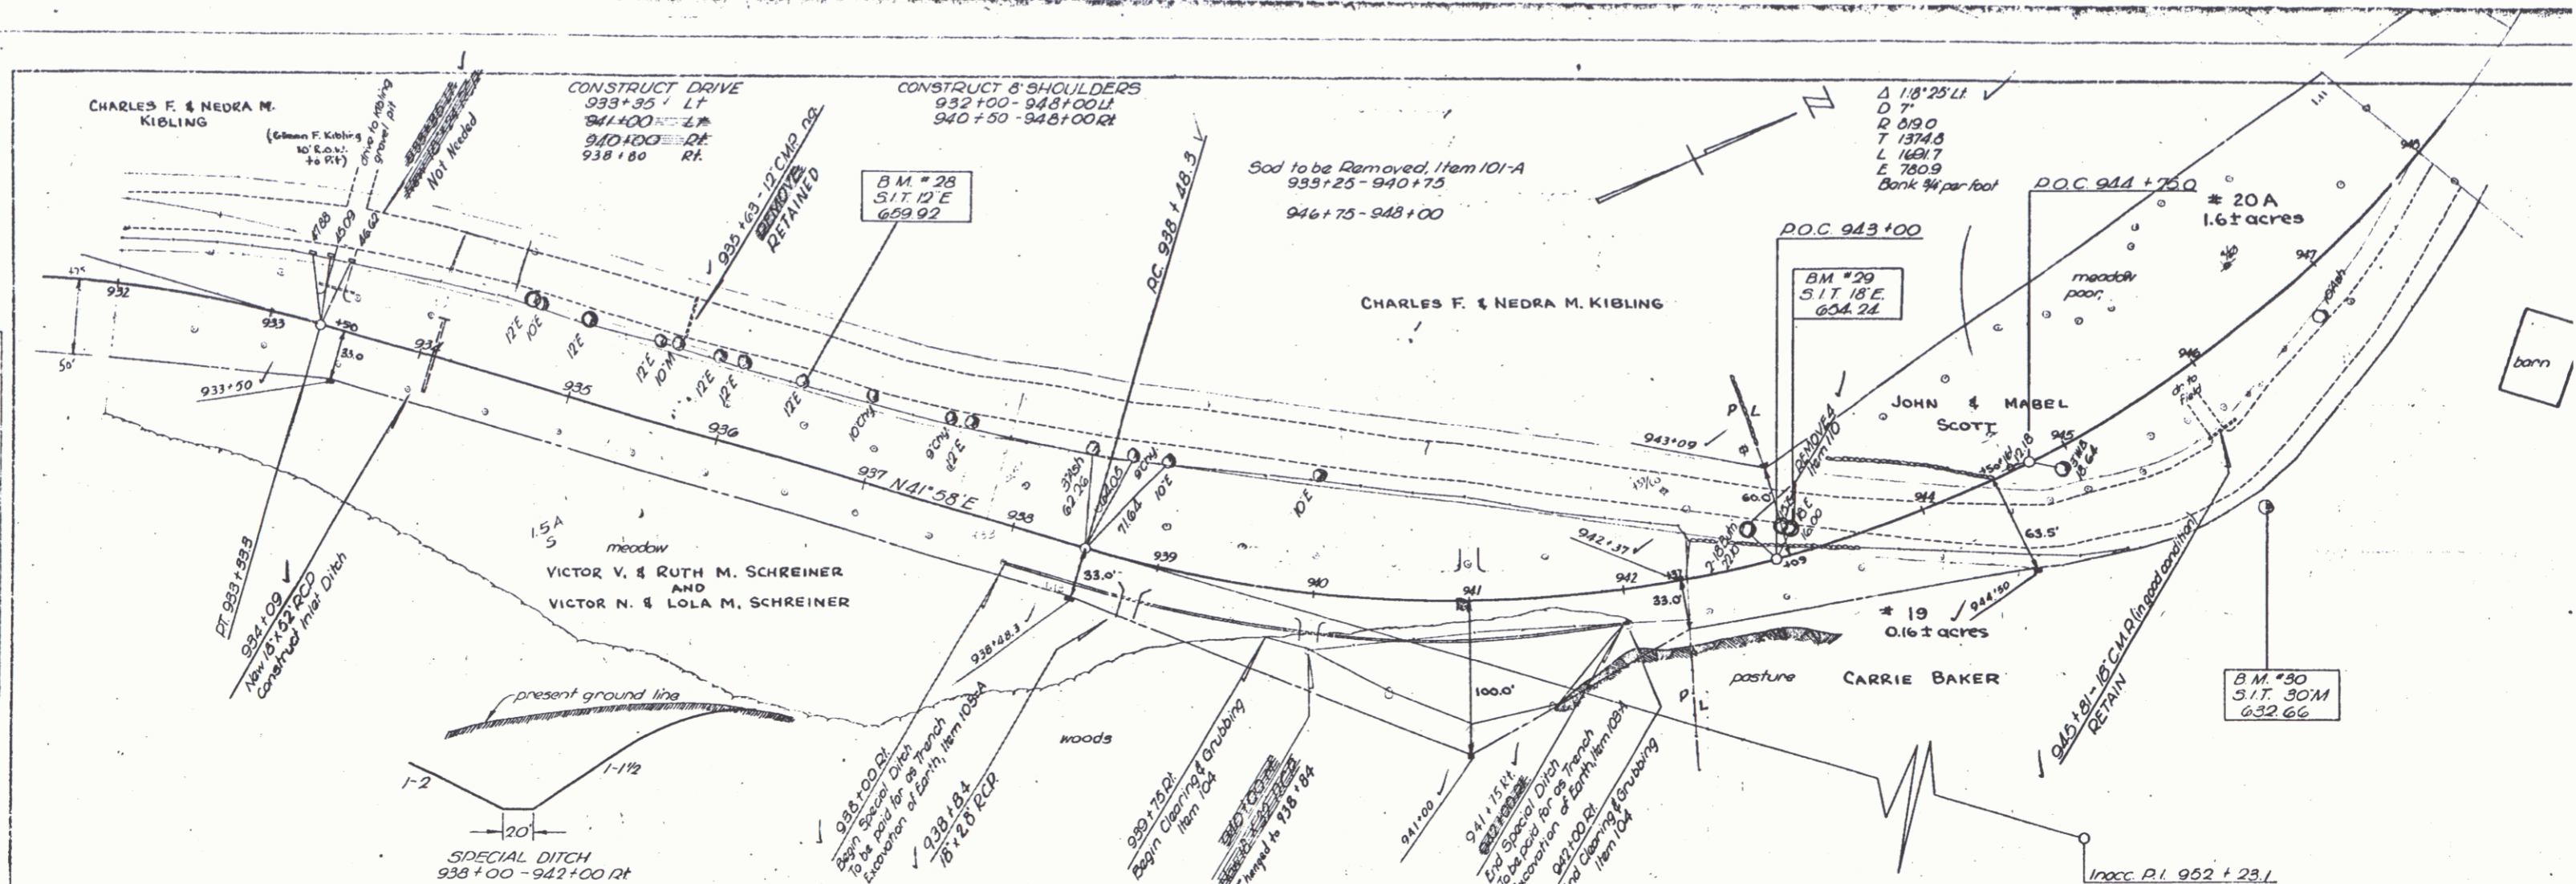

TRAIL	INSTR.	DATE	GRANTOR	GRANTEE	RECORDED	BOOK	PAGE	DATE	REMARKS
#10	W.D.C.E.	10-4-51	CARRIE BAKER	St. of H.	PAWLET	30	118	11-6-51	
#20	W.D.C.E.	10-4-51	JOHN L. & MABEL M. SCOTT	St. of H.	PAWLET	30	157	10-20-51	See Sheet 29

932 BM# 28 117.1 E 45.1 L 16 926.42 E 1659.92
 BM# 29 117.1 E 13.1 L 16 943.09 E 1654.14
 933
 934
 935 BM# 30 111.30 M 101 RT 945.25 E 1632.66
 936
 937
 938
 939
 940
 941
 942
 943
 944
 945
 946
 947 PAWLET
 Project No. 115 (115)
 Sheet 23 of 115