
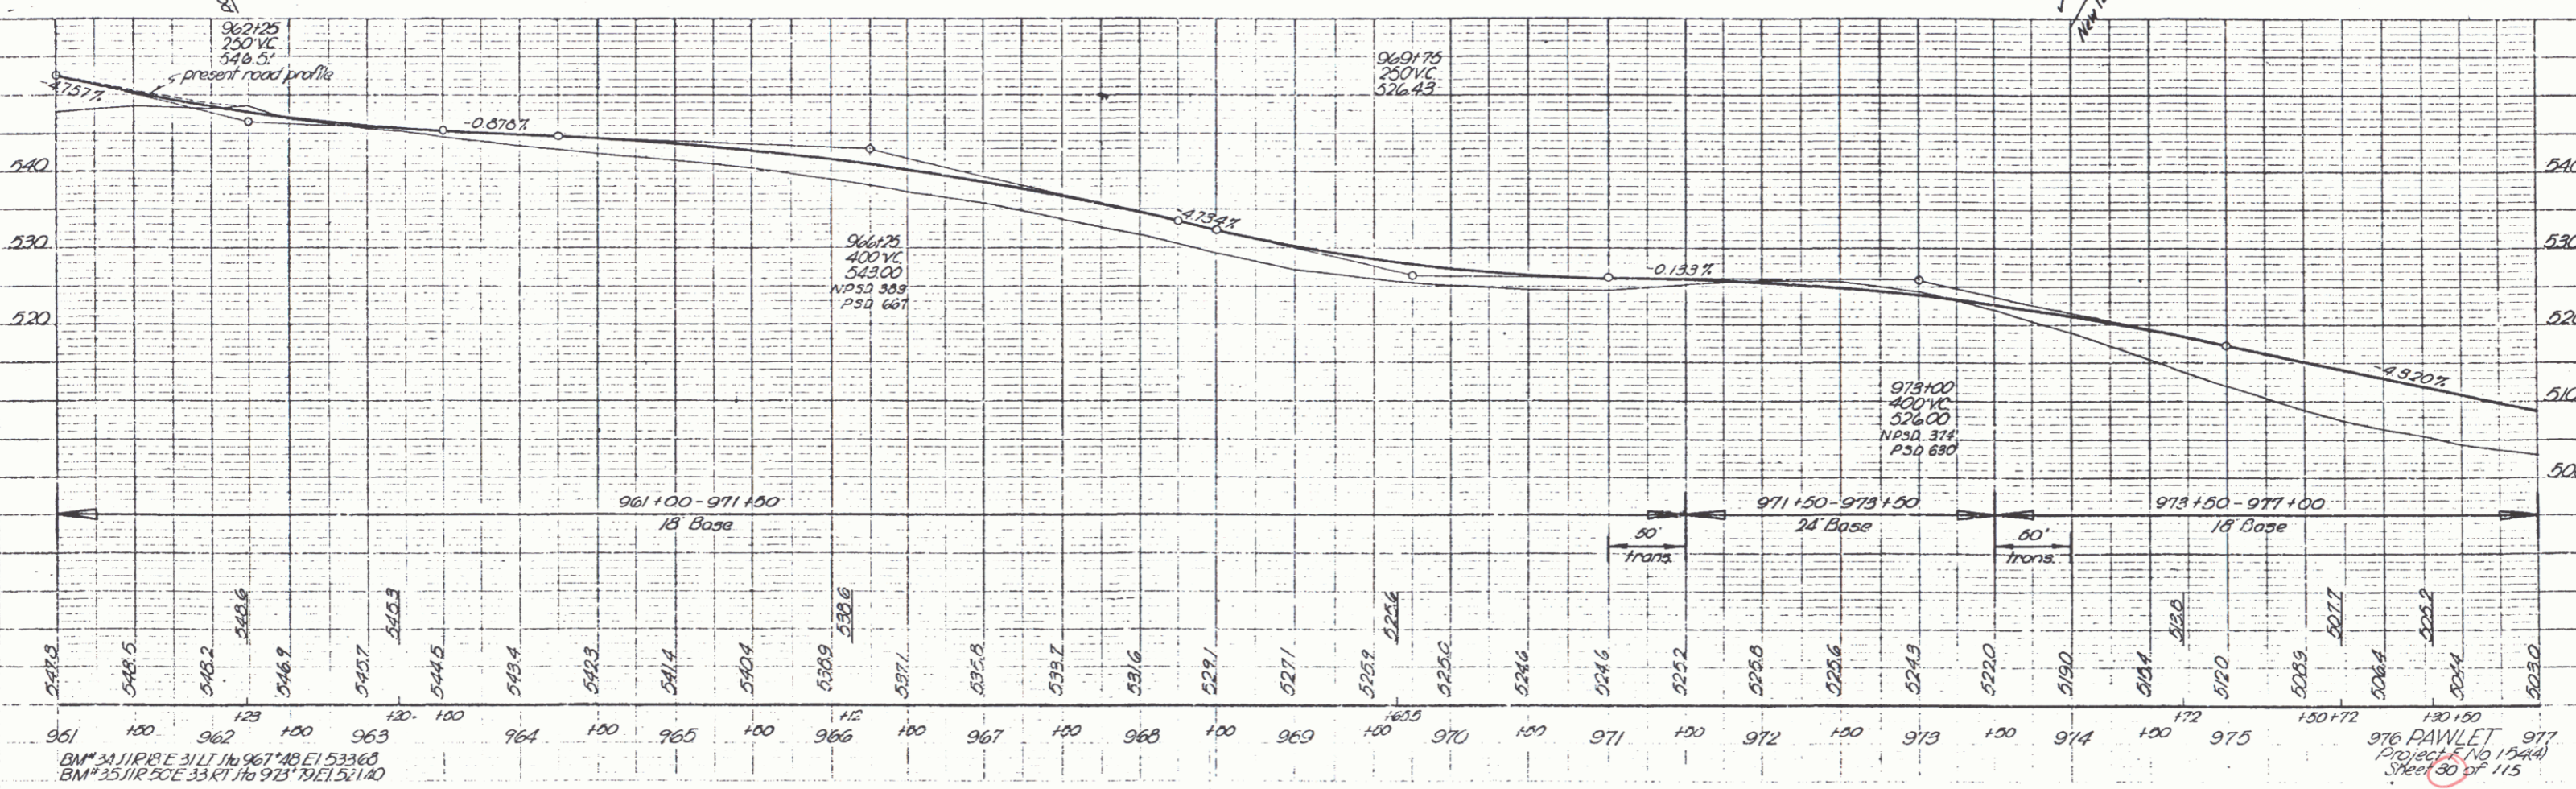


PLAN #23
 DIST. W.D.O.E.
 DATE 10-4-51
 GRANTEE L. BERTHA SMITH
 ST of Vt.
 RECORDED PAWLET
 BOOK 30
 PAGE 151
 DATE 10-29-51
 REMARKS

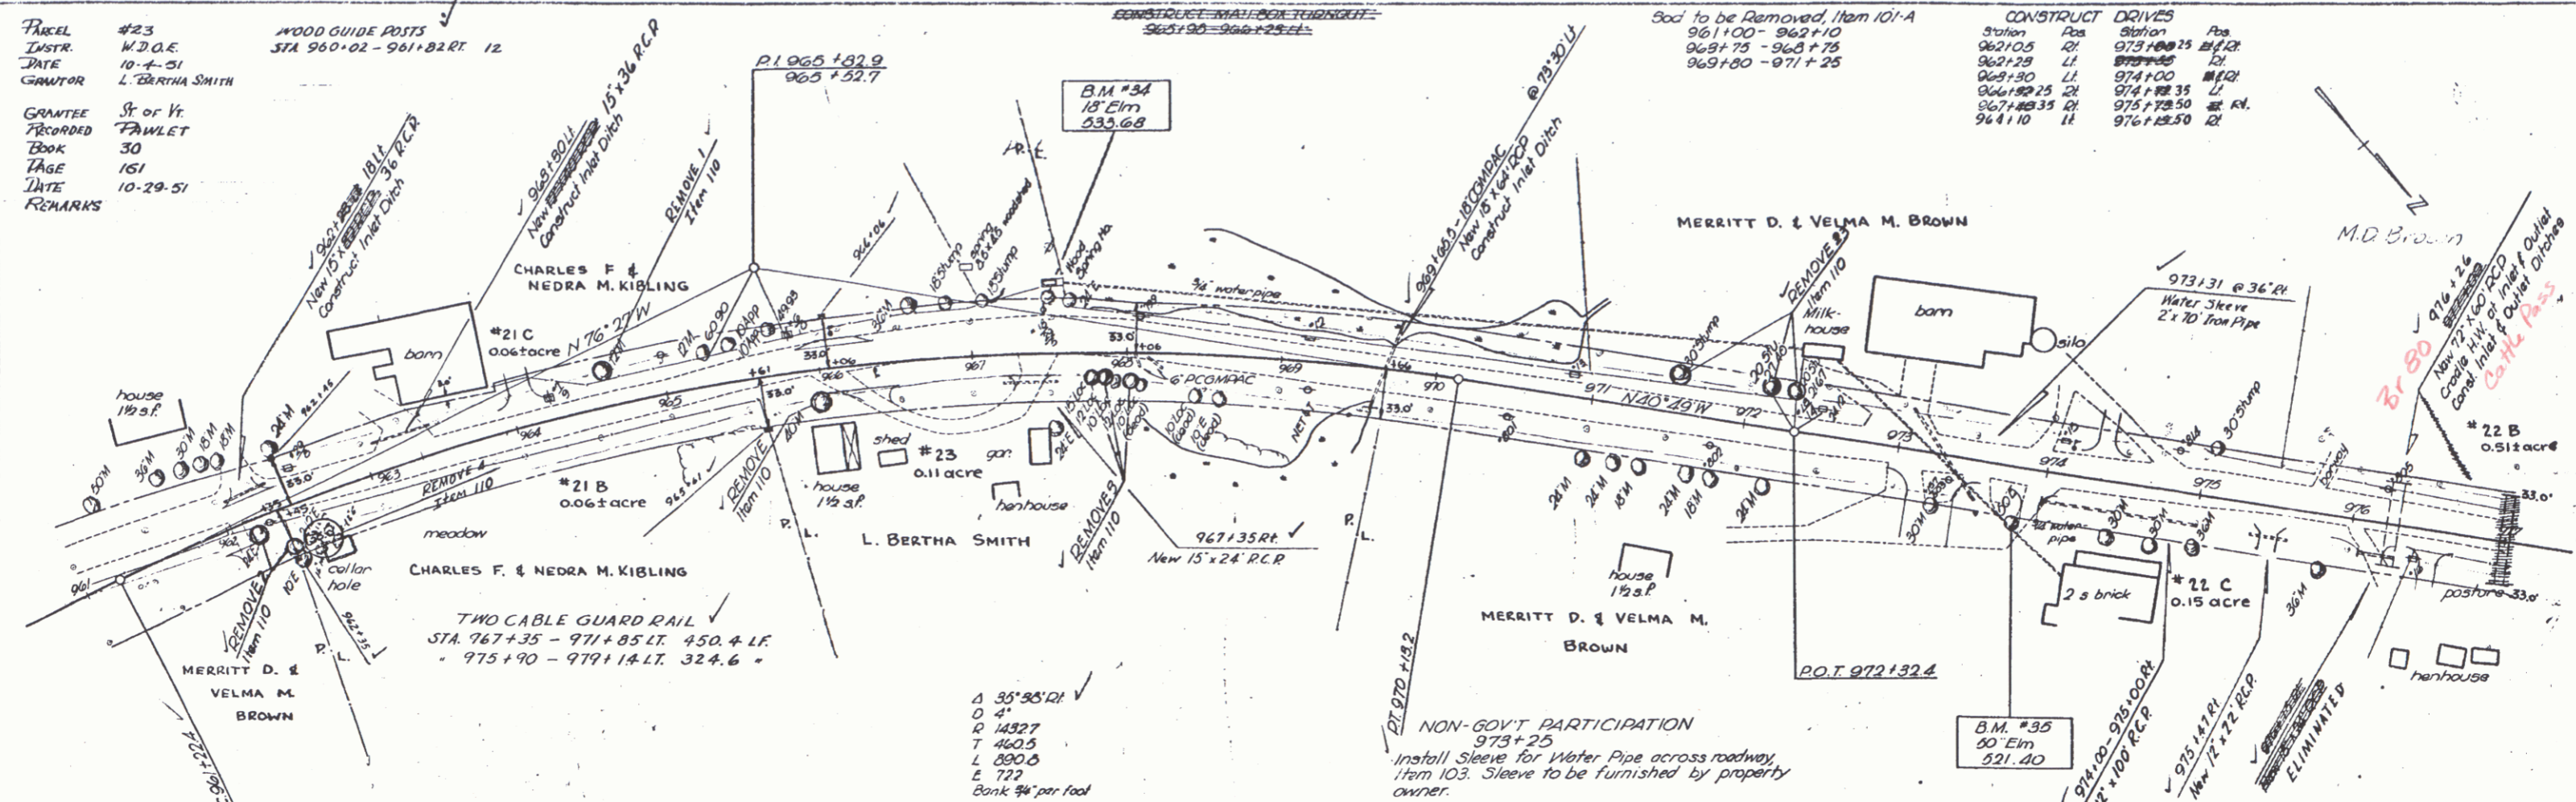

PLAN #23
 DATE 10-4-51
 GRANTEE L. BERTHA SMITH

PROFILE #23
 DATE 10-4-51