
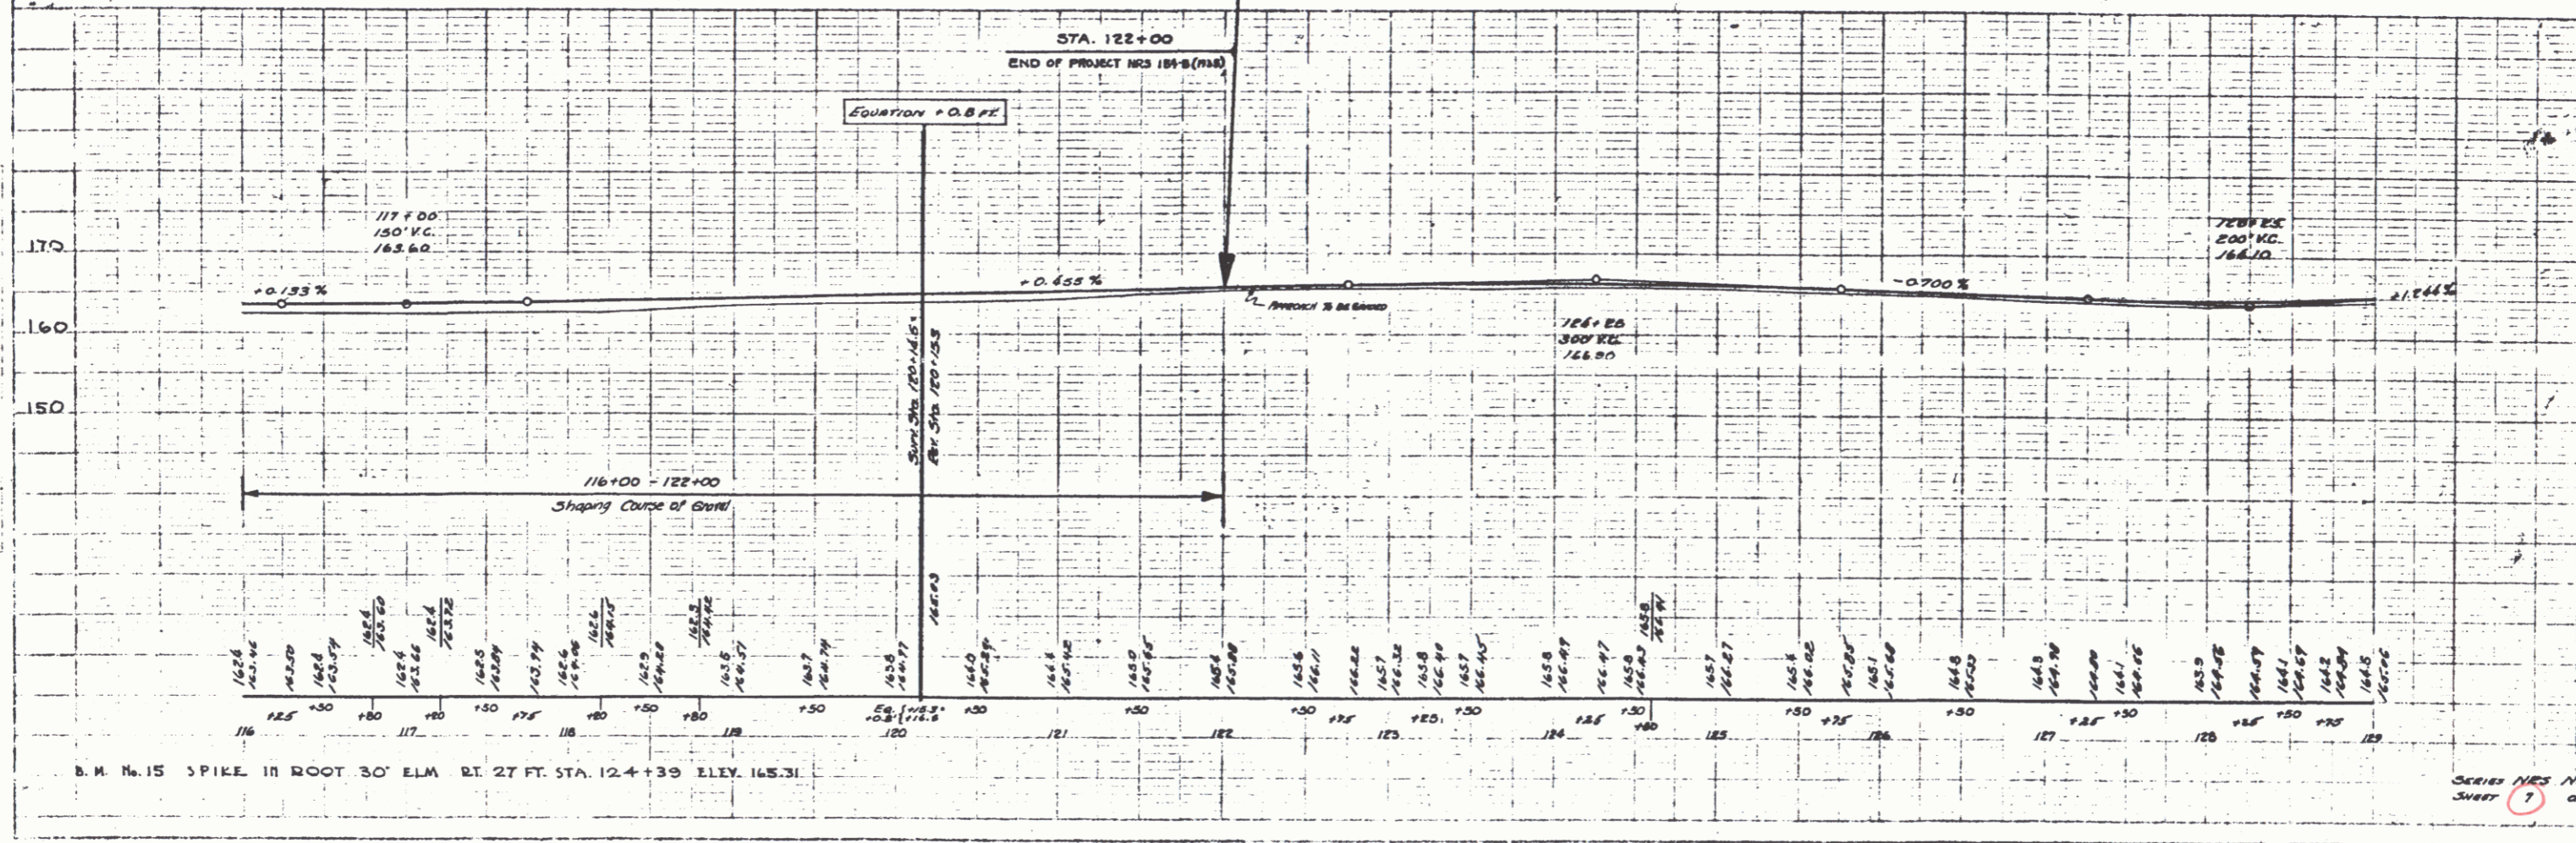


L.A. BEYBOLD 12/34  
 D. MACCHI 1/35  
 TRACED

L.A. BEYBOLD 12/34  
 D. MACCHI 1/35

NES  
 104-B  
 (1088) 1935 7

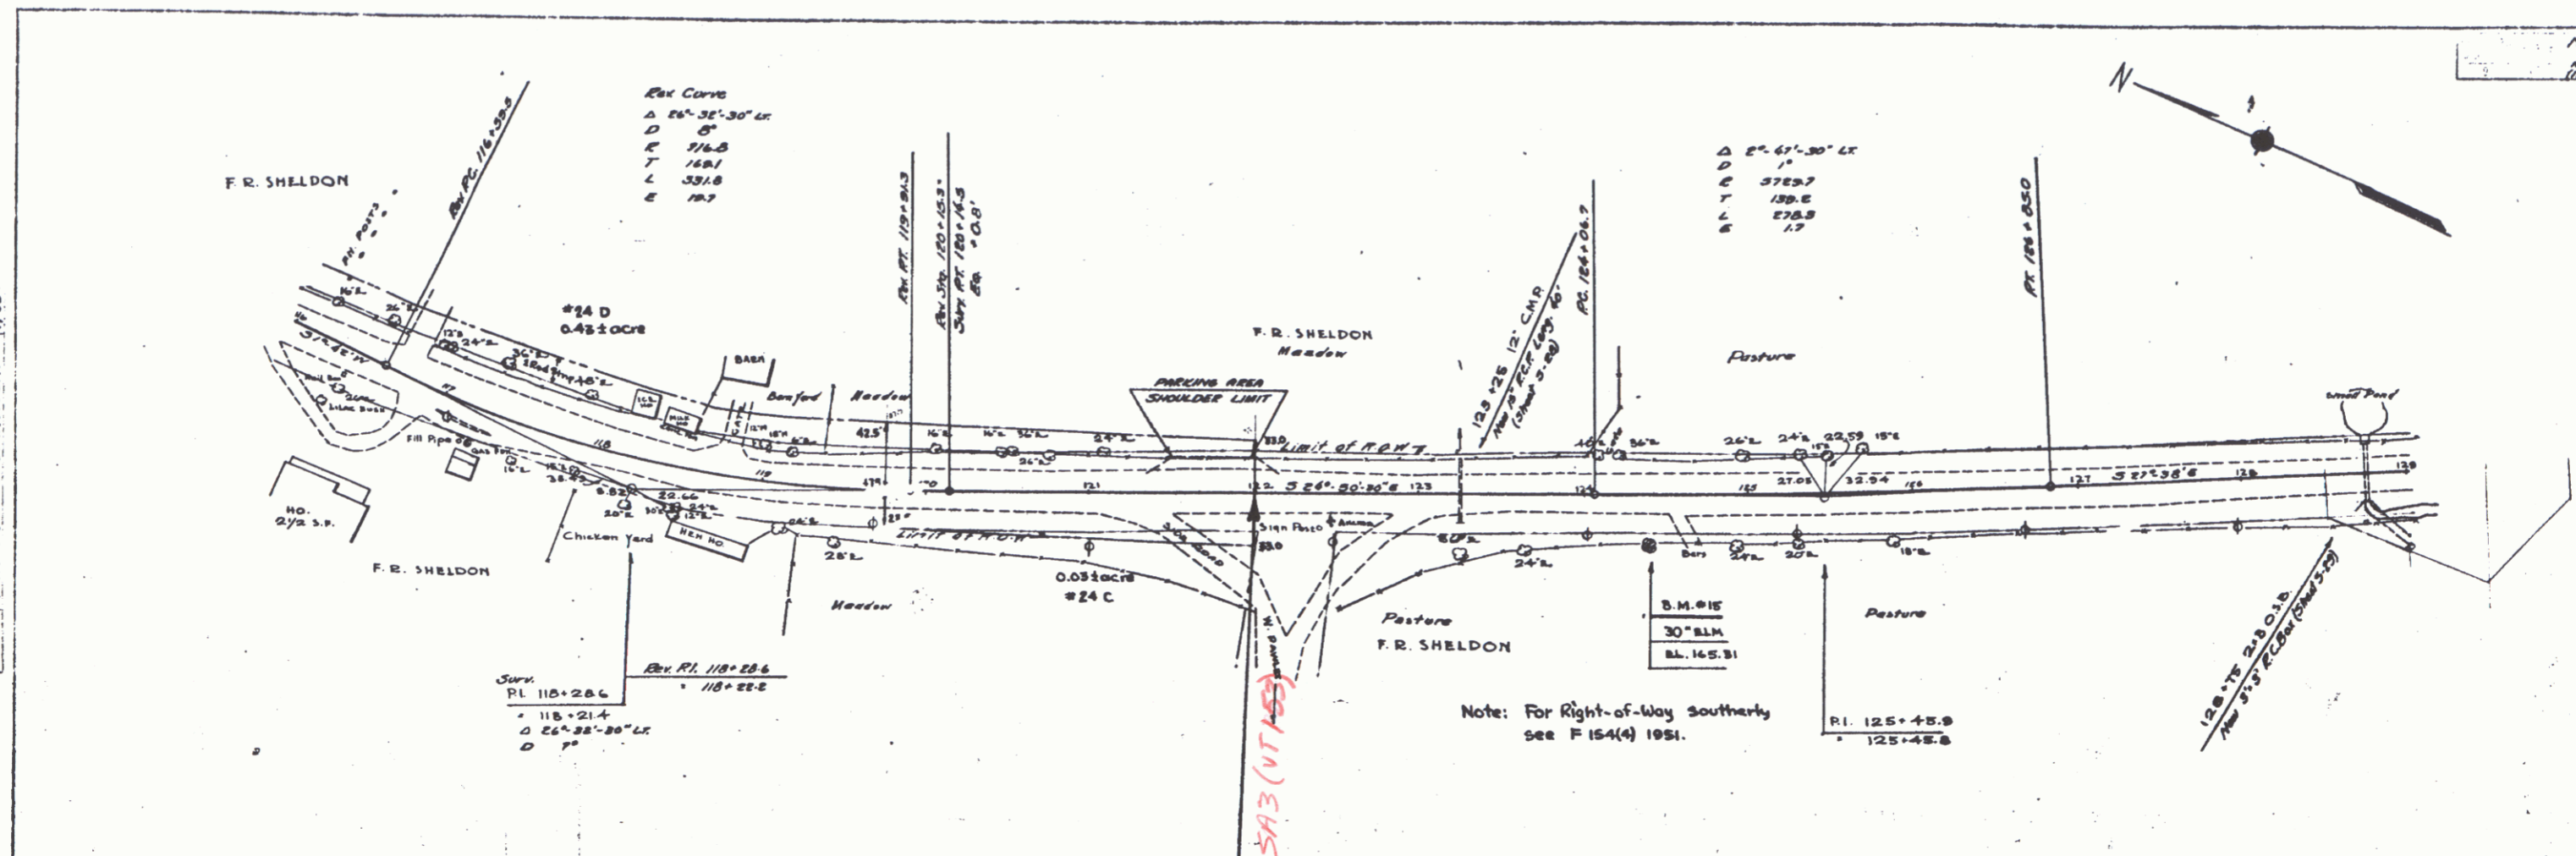

Series NES No. 104-B (1088)  
 Sheet 7 of 12