
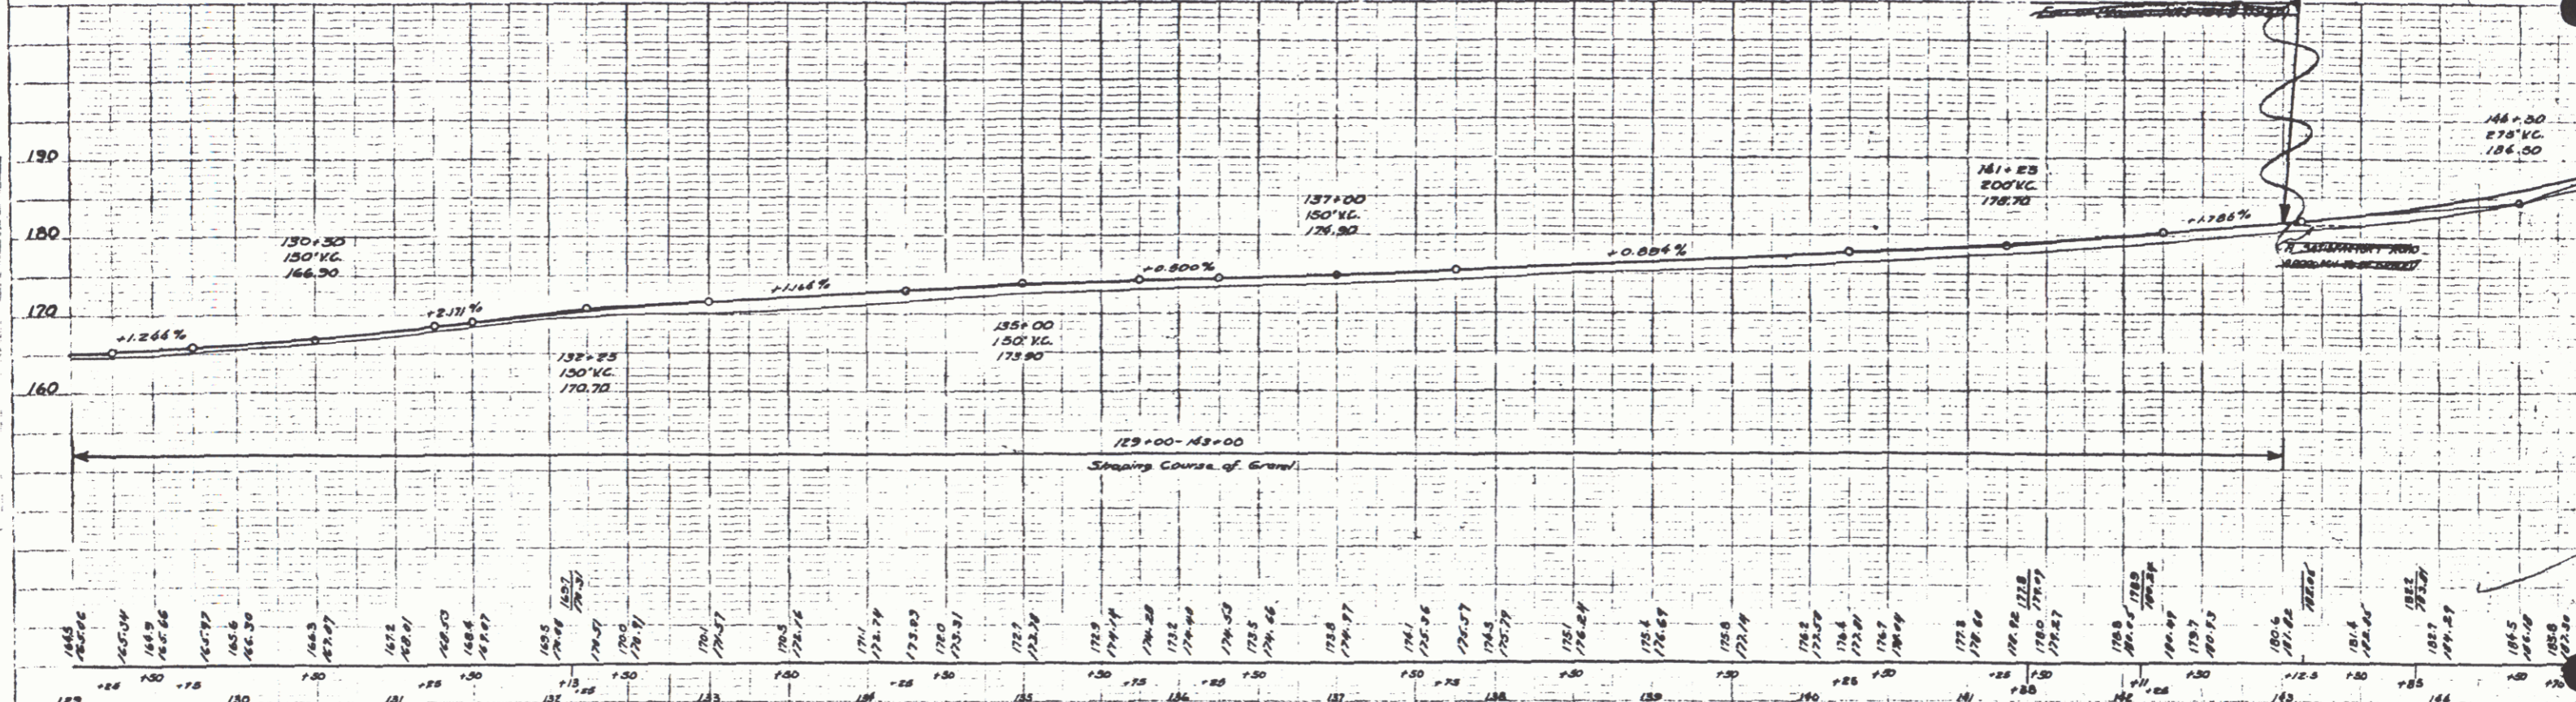


LA REYNOLDS 1274
 D. MACCHI 1274
 TEACED

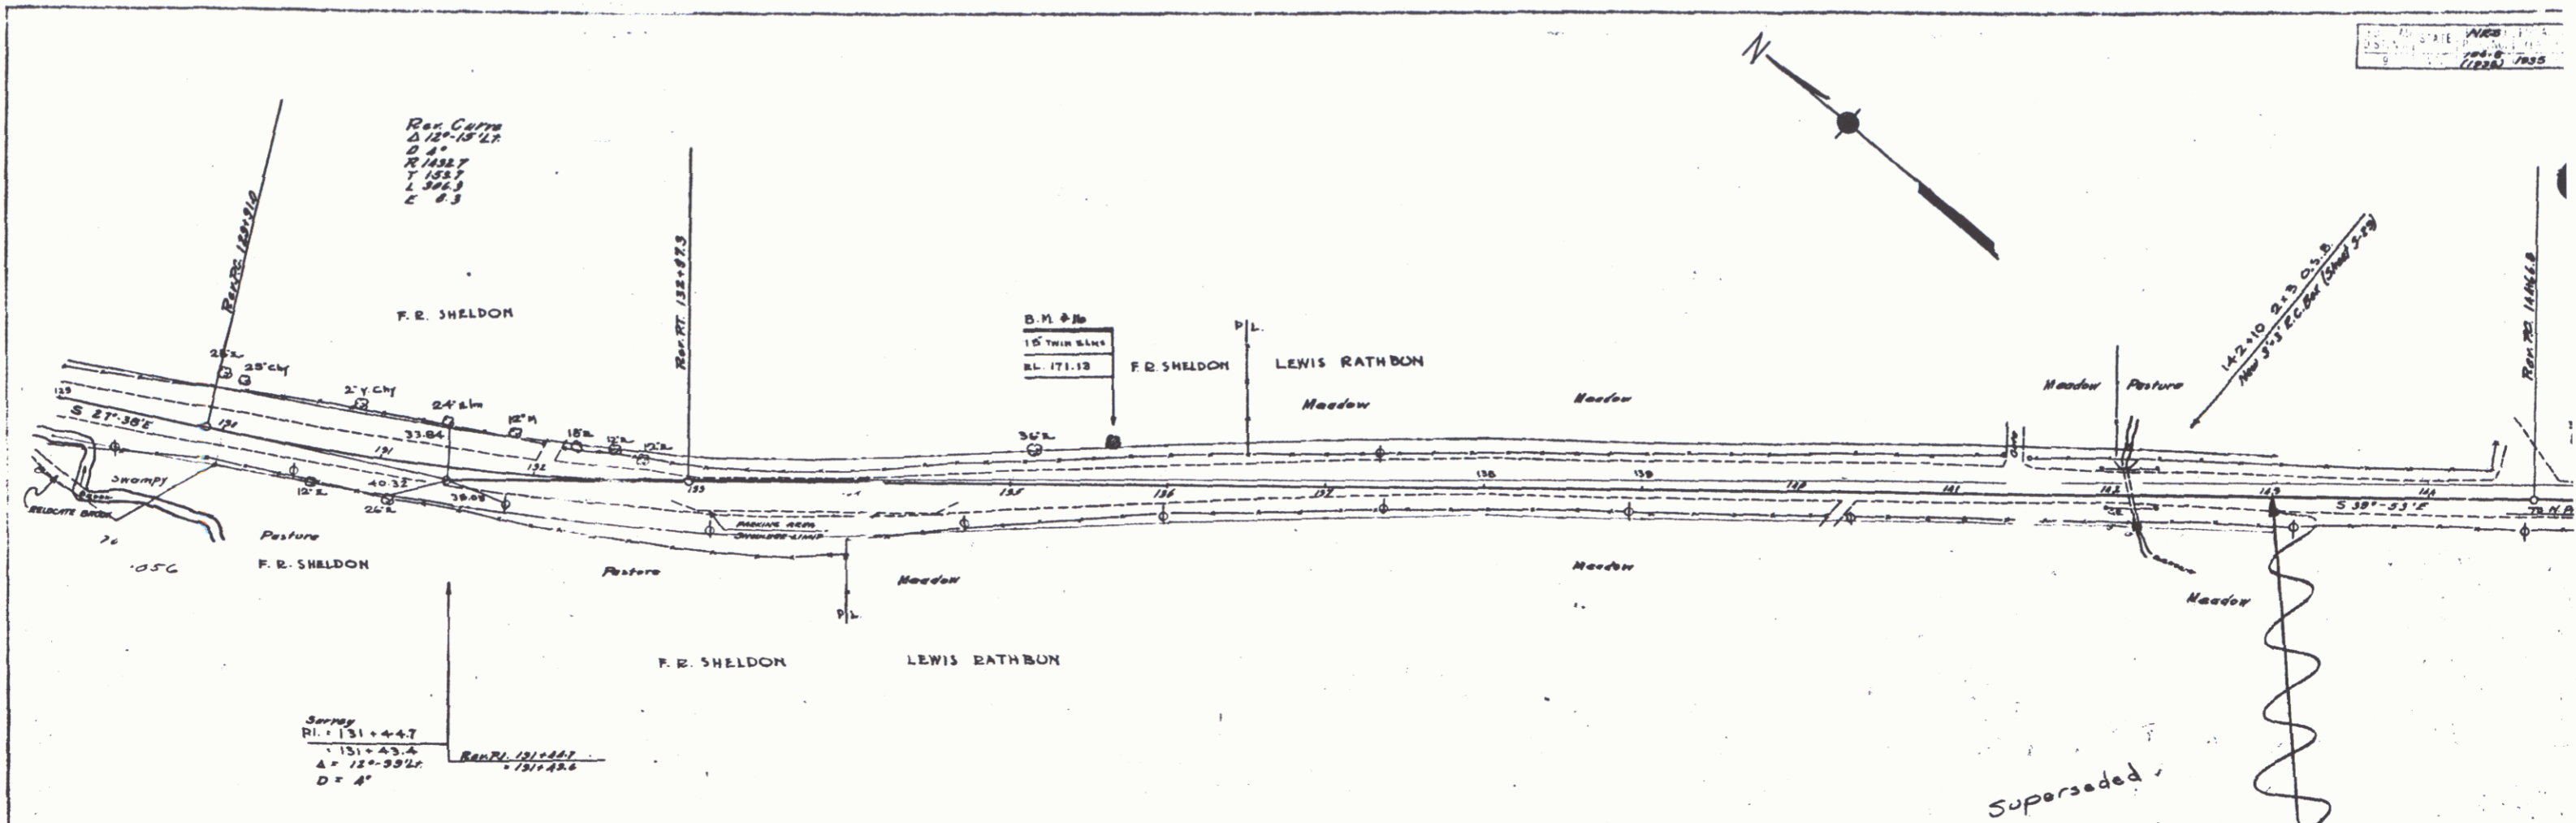

B. M. #16 SPIKE IN ROOT 15' ELM .29 FT. LT. STA. 136+66 ELEV. 171.13

Series 1273 No. 131-B(1923) SHEET 8 of 17