



PLAN  
 DRAWN BY: POTVIN  
 CHECKED BY: [blank]  
 DATE: [blank]

PROFILE  
 DRAWN BY: POTVIN  
 CHECKED BY: [blank]  
 DATE: [blank]

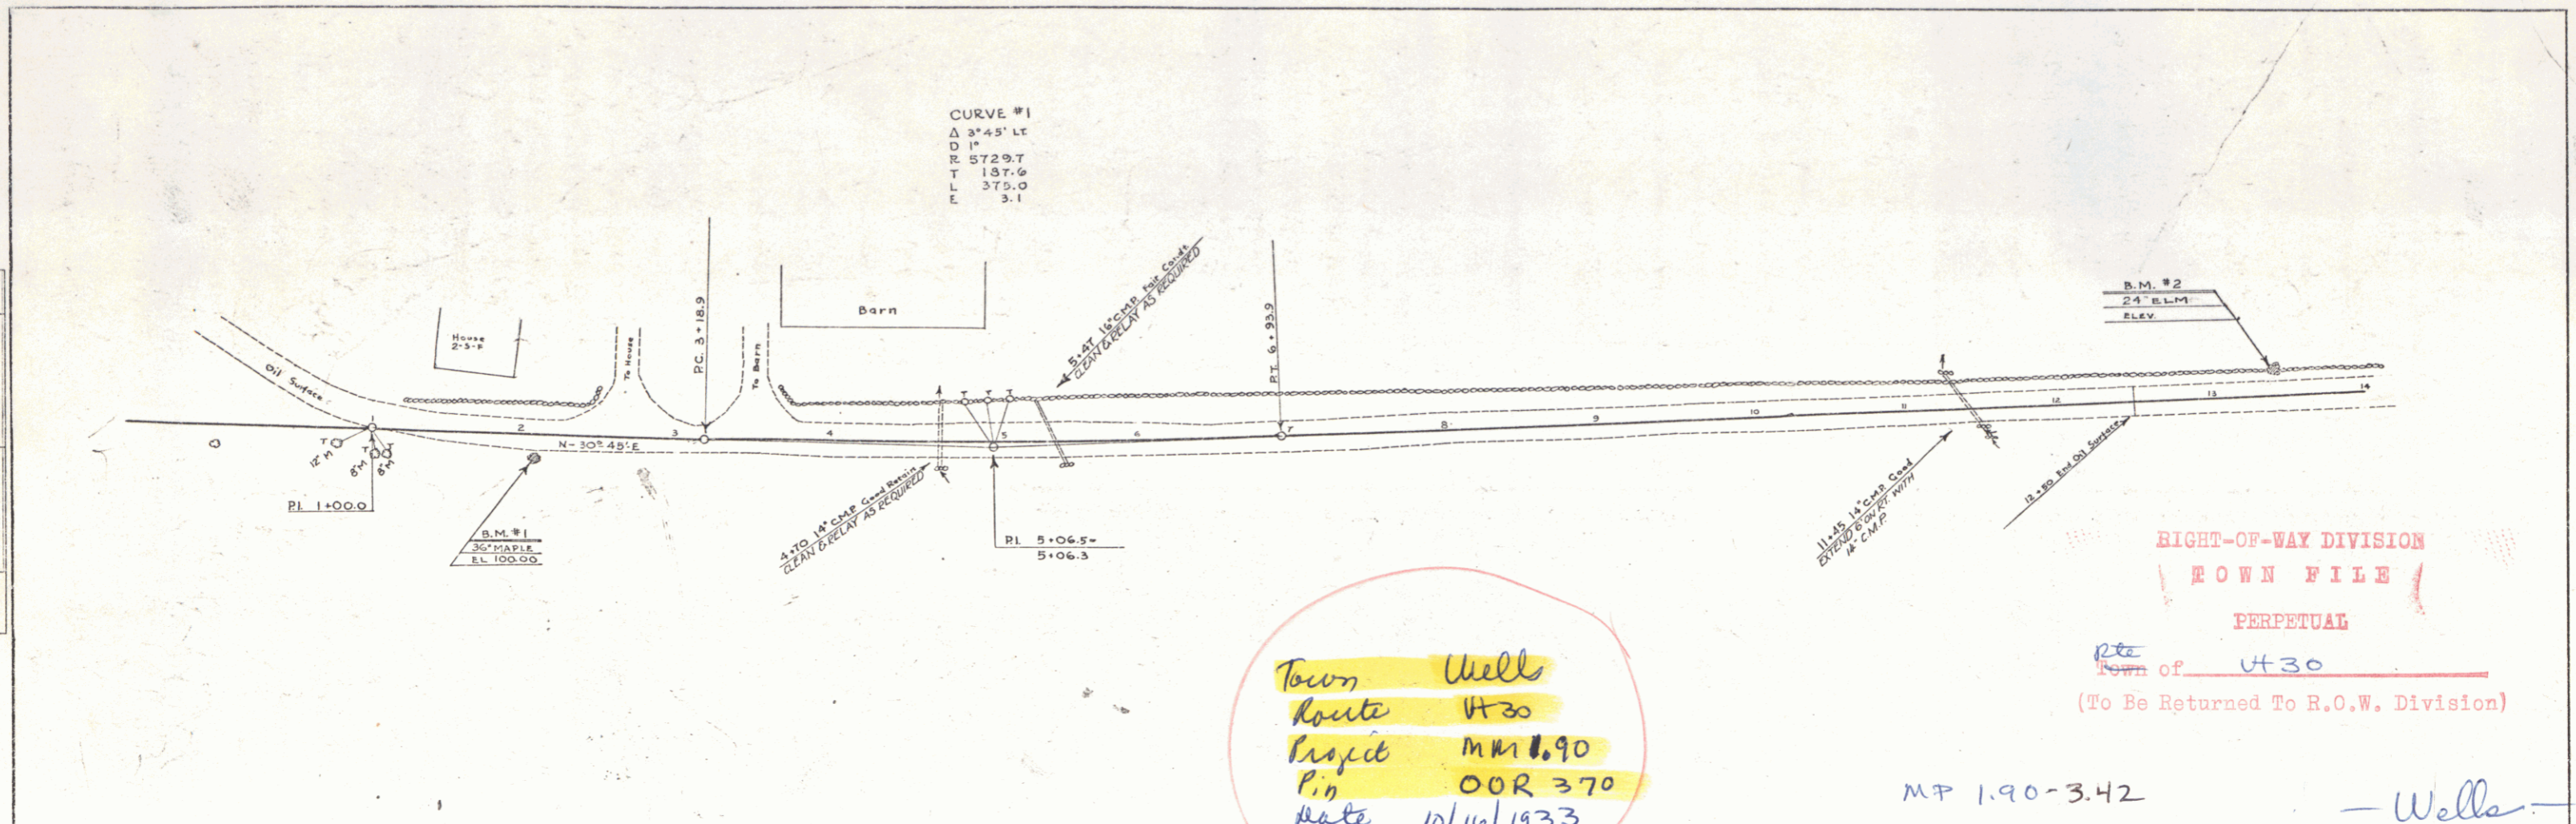

Town Wells  
 Route Ut30  
 Project MM 1.90  
 P.O. 00R 370  
 Date 10/16/1933

MP 1.90-3.42  
 - Wells -

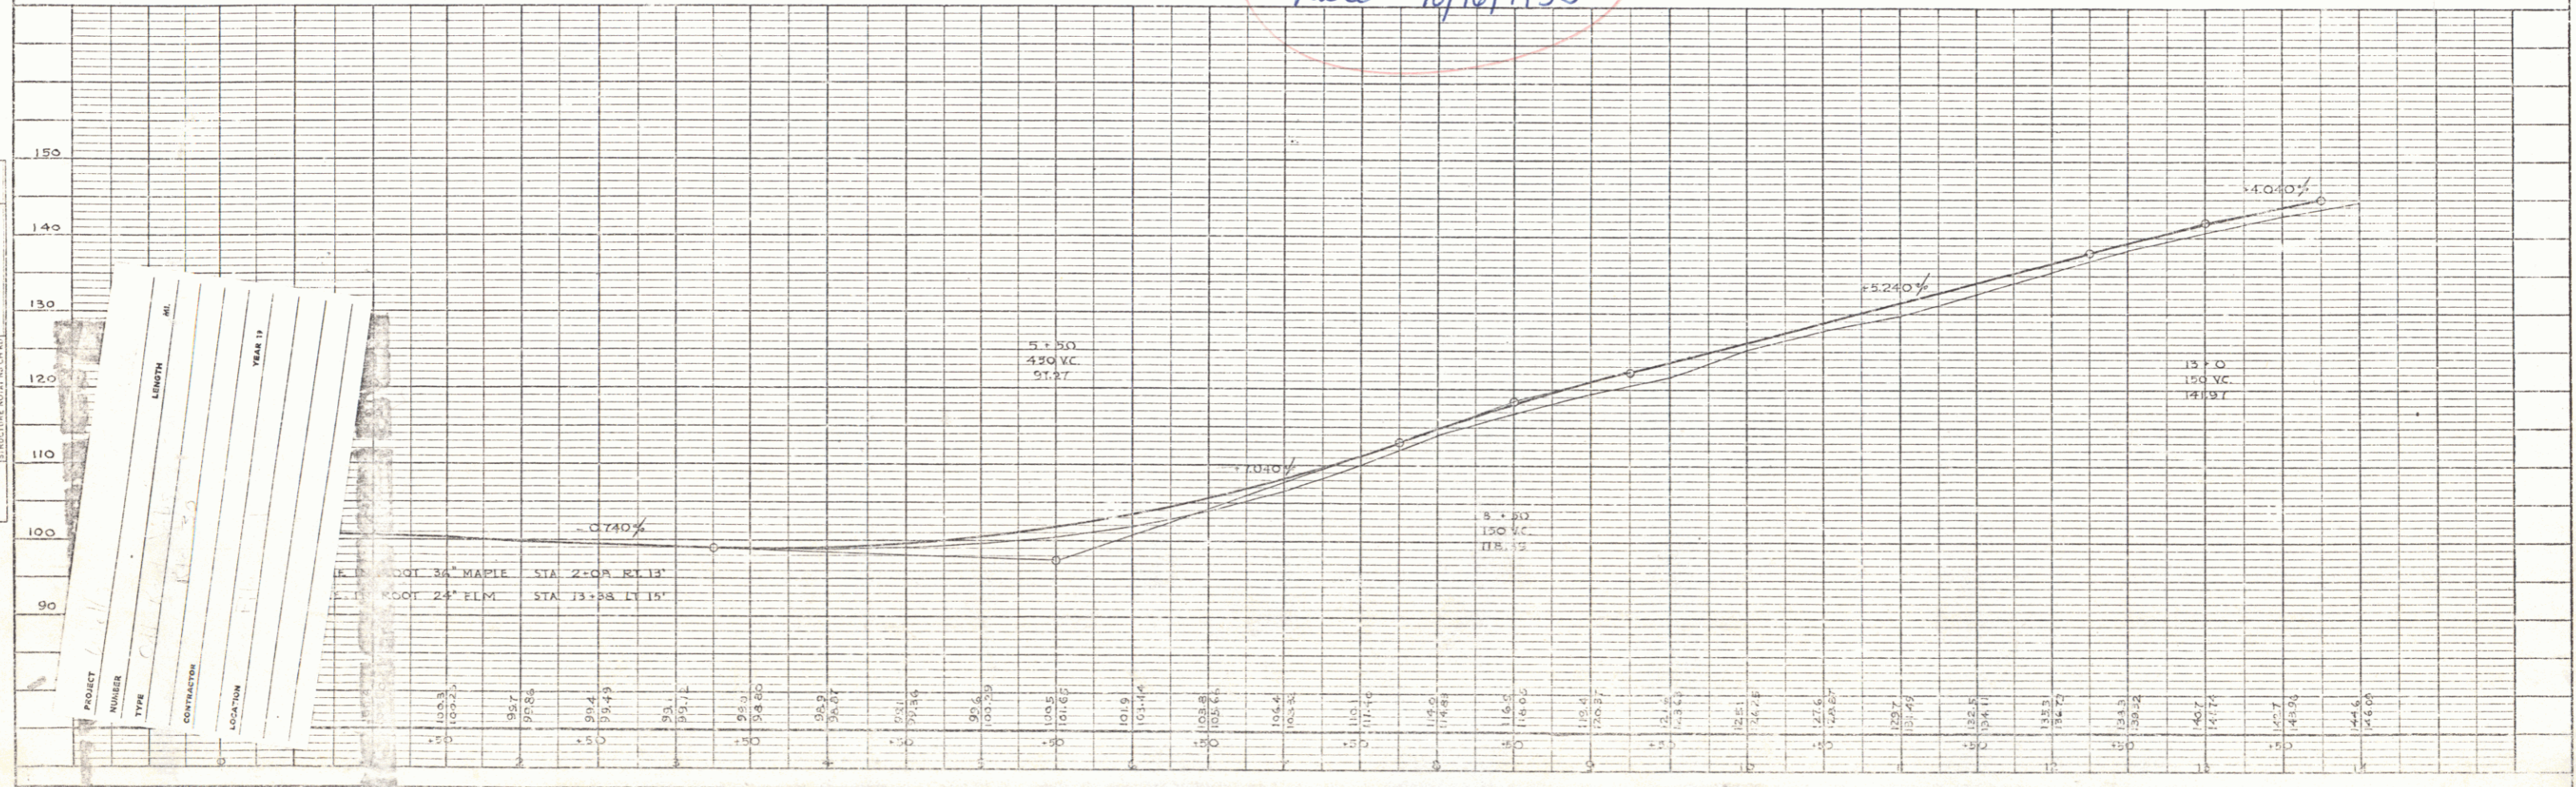

PROJECT: [blank]  
 NUMBER: [blank]  
 TYPE: [blank]  
 CONTRACTOR: [blank]  
 LOCATION: [blank]  
 YEAR: [blank]

Wells