

PLAN  
 DRAWN BY  
 CHECKED BY  
 DATE

PROFILE  
 DRAWN BY  
 CHECKED BY  
 DATE

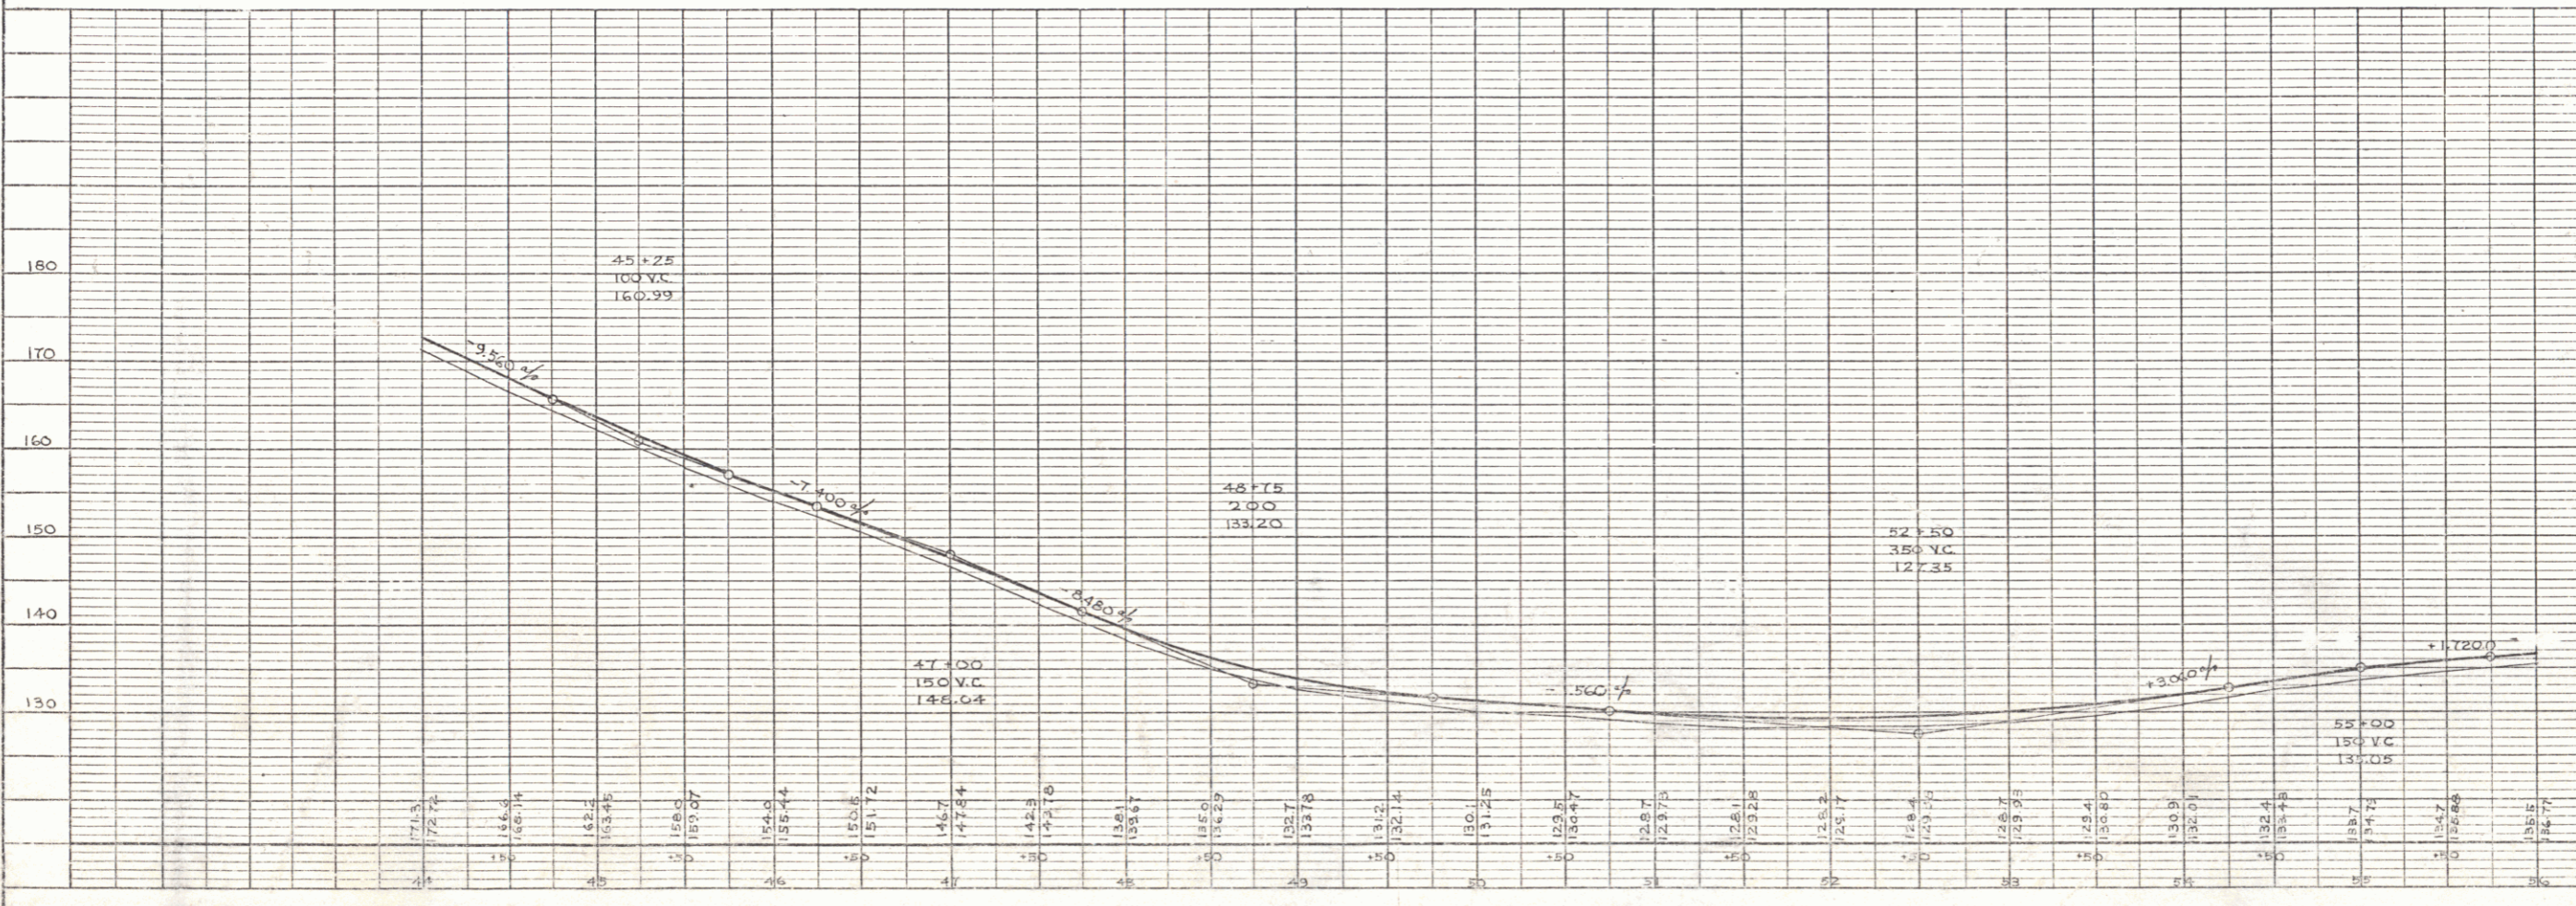
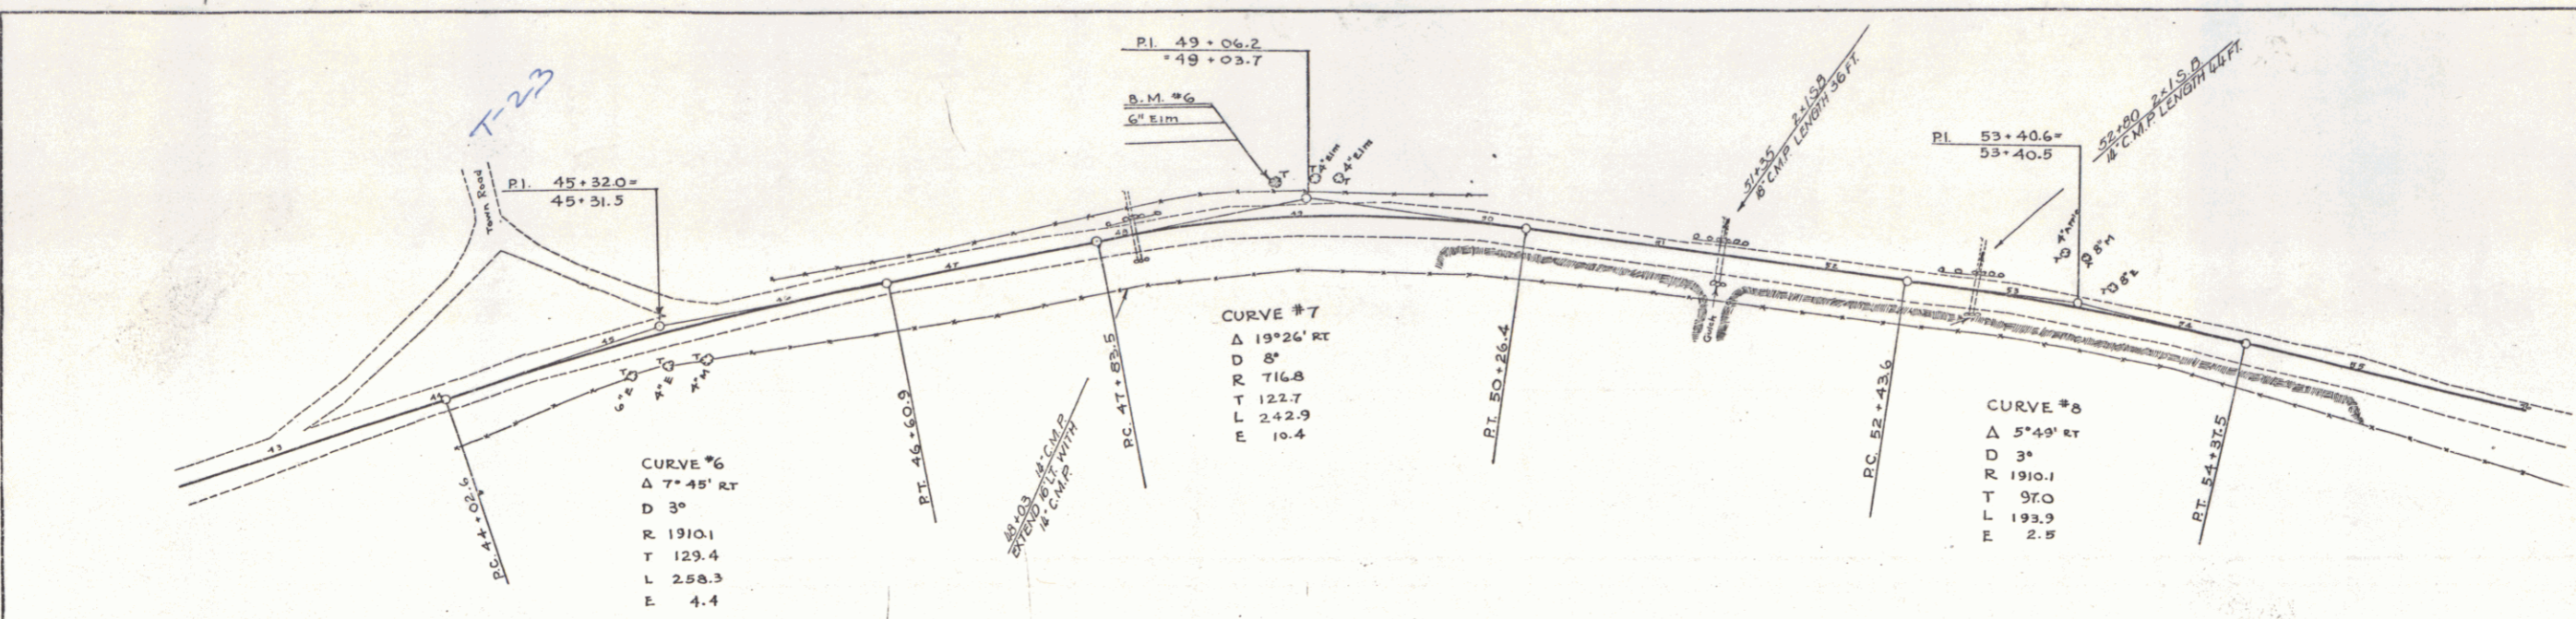


PLATE 1 - PLAN - PROFILE OF ROAD STANDARD  
 KEFFEL & EGGER CO. NEW YORK