

PLAN
 DRAWING NO. _____
 DATE _____
 BY _____
 CHECKED BY _____
 IN CHARGE _____
 NOTE BOOK NO. _____
 INC. OF WAY CHECKED BY _____

PROFILE
 DRAWING NO. _____
 DATE _____
 BY _____
 CHECKED BY _____
 IN CHARGE _____
 NOTE BOOK NO. _____
 INC. OF WAY CHECKED BY _____

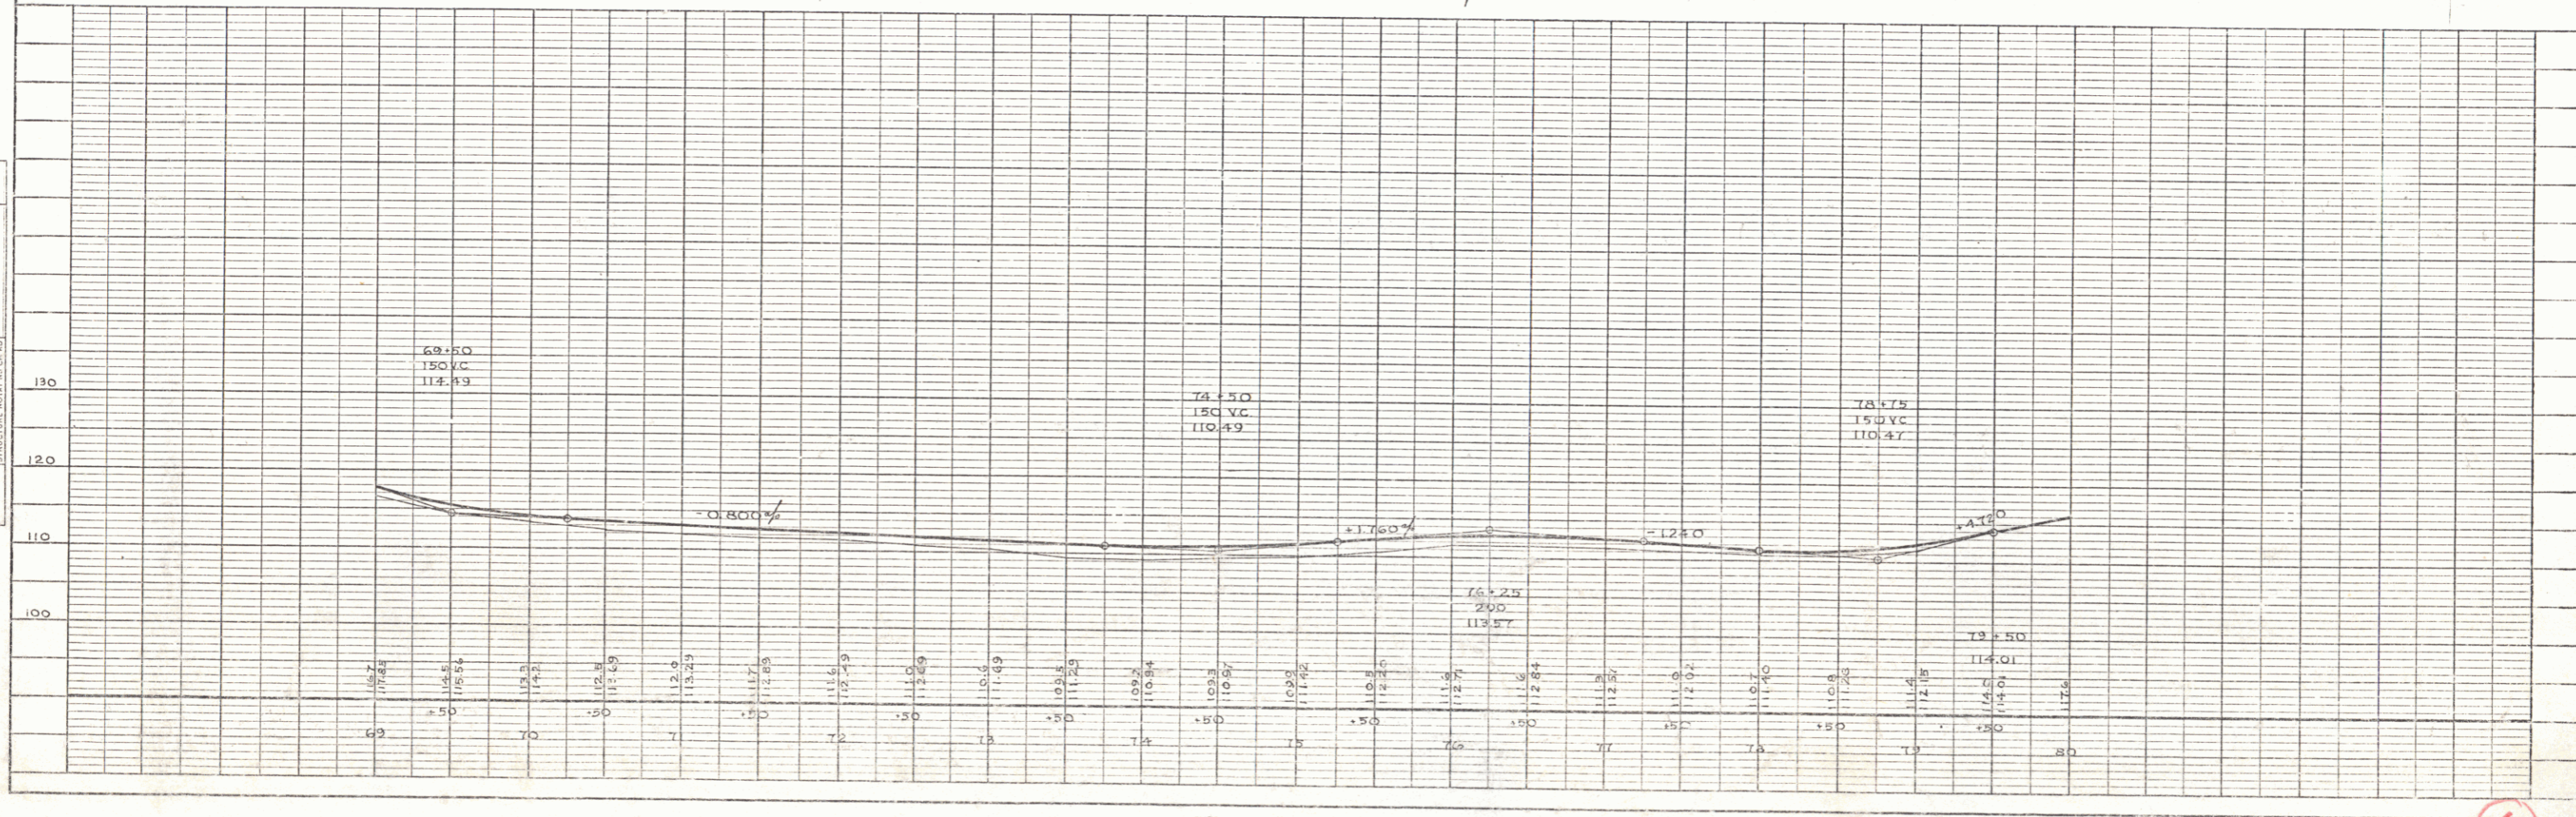
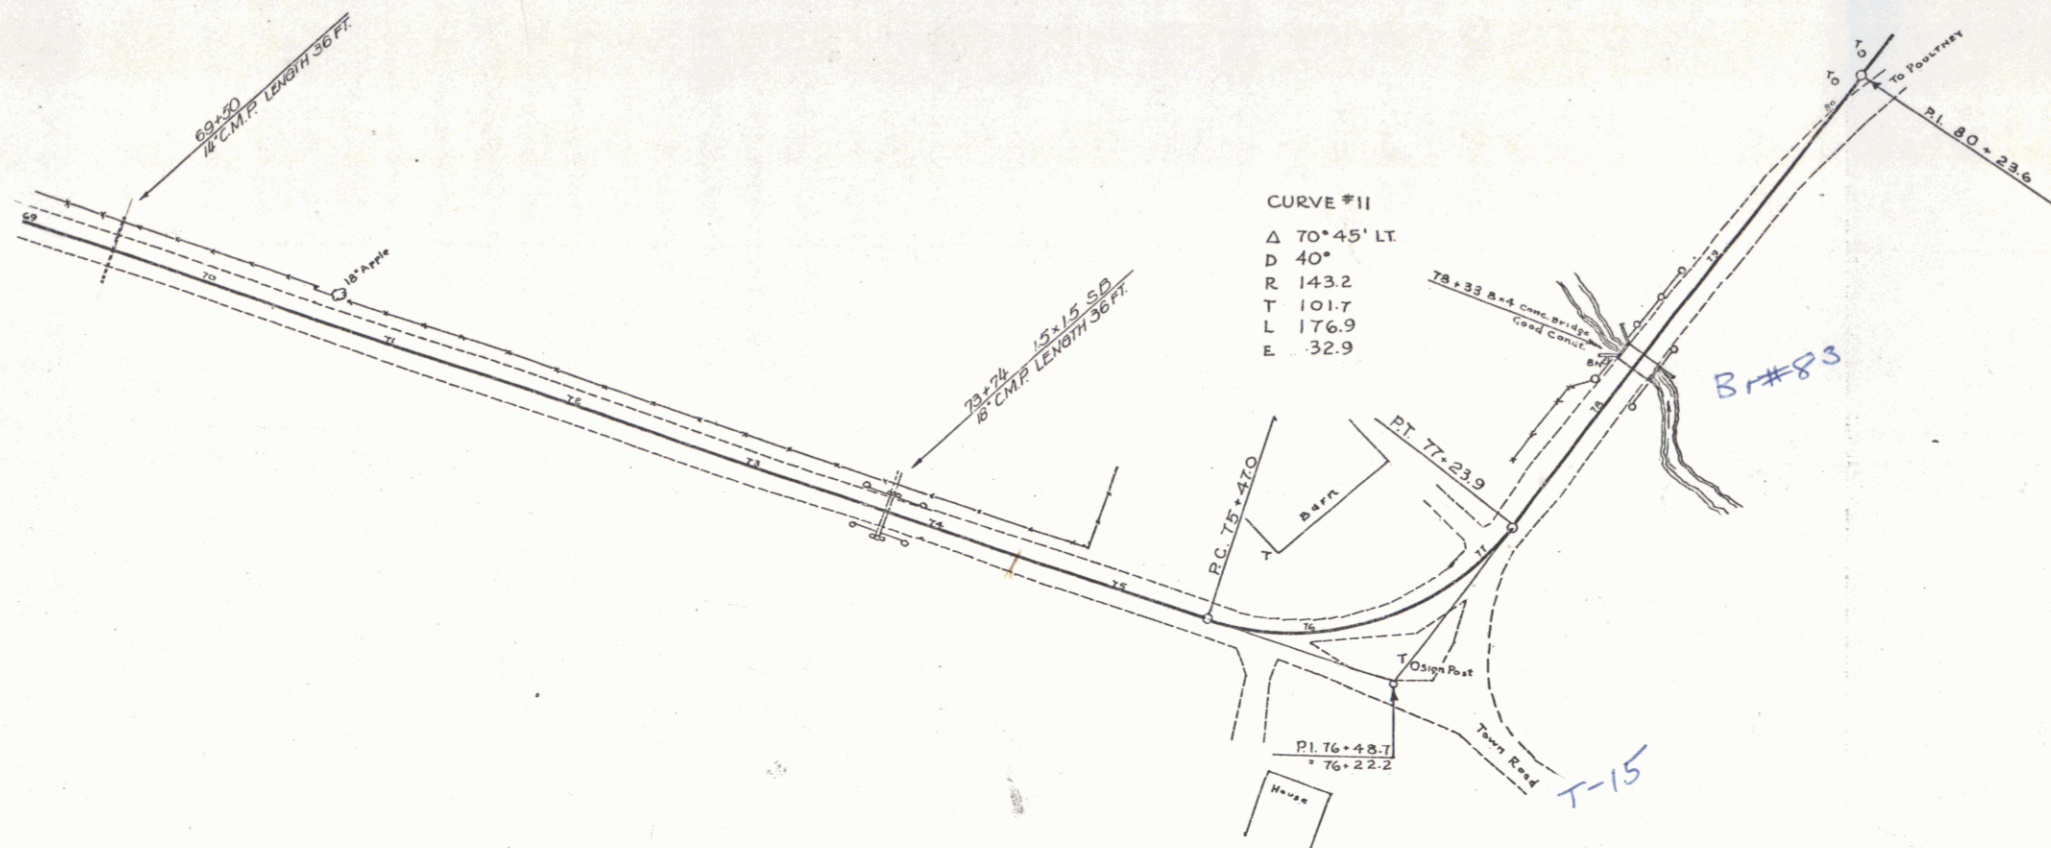


PLATE 1 - PLAN - PROFILE
 DRAWING NO. _____
 DATE _____
 BY _____
 CHECKED BY _____
 IN CHARGE _____