

INDEX OF SHEETS

SHEET NO. 1	TITLE PAGE
2	TYPICAL CROSS SECTION OF IMPROVEMENT DOUBLE THICK COAT OF REFINED TAR W/ PEA STONE SEAL, ITEM 312-A
3	ROADWAY STANDARD SHEET RS 56-1, BANKING TABLES
4	QUANTITY SHEET (ITEMS AND DRAINAGE)
5-6	EARTHWORK SHEETS
7-9	PLAN AND PROFILE SHEETS
9-A	WIRING DIAGRAM (NOT INCLUDED IN PLANS. CAN BE FURNISHED BY THE D & H. R.)
9-B	DETAIL OF FLASHING LIGHT ASSEMBLY
10	ROADWAY STANDARD SHEET RS 56-3, PLANK GUARD RAIL, GUIDE POSTS, & MARKERS
11	ROADWAY STANDARD SHEET RS 56-4, DRAINAGE
12	ROADWAY STANDARD SHEET RS 56-6, TYPICAL SLOPE GRADING
13	ROADWAY STANDARD SHEET RS 56-11, THREE CABLE GUARD RAIL
14	ROADWAY STANDARD SHEET RS 56-12, BARRICADES, SIGNS & LIGHTS
15	ROADWAY STANDARD SHEET RS 56-14, PRECAST R.C.P. DROP INLETS
16	STANDARD STRUCTURE SHEET S-C-21 (CULVERT DETAILS)
17	DETAILS OF 10' X 10' R.C. BOX EXTENSION AT STA 59+58
18	DETAILS OF WINGS AT STA. 59+58
19	REINFORCING STEEL SCHEDULE
20-21	CHANNEL SECTIONS
22-43	CROSS SECTIONS

STATE OF VERMONT
DEPARTMENT OF HIGHWAYS


PROPOSED IMPROVEMENT

TOWN OF POULTNEY

COUNTY OF RUTLAND
VERMONT ROUTE 30
MANCHESTER-RUTLAND ROAD


BEGINNING AT A POINT APPROXIMATELY 2.1 MILES SOUTH OF THE CASTLETON-POULTNEY TOWN LINE AND EXTENDING NORTHERLY 3,125.0 FEET.

LENGTH OF PROJECT 3,125.0 FEET • 0.592 MILE

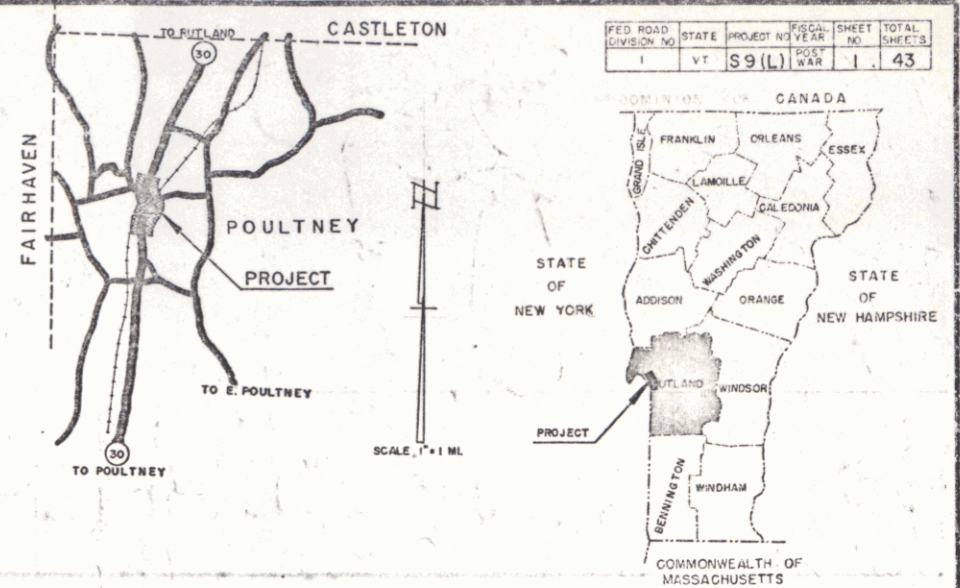

PROJECT NAME & NUMBER	TYPE	PAVEMENT AREA
POULTNEY 59(L)	DOUBLE THICK COAT OF REFINED TAR W/ PEA STONE SEAL	6944 S.Y.
RECORD PLANS		
MATERIALS		
SUB-BASE OF GRAVEL - GREER'S PIT, POULTNEY, VT.	REINFC. STEEL - VT. STRUC. STEEL CO., BURLINGTON, VT.	
PEA STONE SEAL - CLARK & HAYNES, POULTNEY, VT.	R.C. PIPE - FEDERAL CO. & SAND CO., GLENS FALLS, NY.	
REFINED TAR - KOPPEL'S PROD. CO., EVERETT, MASS.	ACC. G.M. PIPE - W.F. METAL CULV. CO., BOSTON, MASS.	
CEMENT - IRONLAD CEMENT CO., GLENS FALLS, NY.	THREE CABLE G.R. - U.S. STEEL PRODUCTS - AMERICAN STEEL	
CONG. AGGREGATE - BARKERS, RUTLAND, VT.	WIRE CO., NEW HAVEN, CONN.	
CONTRACTOR - W.H. DRATH, 130 W. STATE ST., BURLINGTON, VT.	CONTRACT DATED - JUNE 14, 1956	
RESIDENT ENGR. - A. SYLVESTER - C. CROSSSETT	CONTRACT STARTED - JUNE 19, 1956	
INSPECTORS -	CONTRACT COMPLETED - JULY 11, 1957	
RECORD PLANS - W.H. DRATH	CONTRACT ACCEPTED - JULY 11, 1957	

NOTE: ANY FURTHER INFORMATION CONCERNING FINAL QUANTITIES, AMOUNTS OR OTHER DETAILS RELATIVE TO THIS PROJECT MAY BE FOUND IN EITHER THE FIELD BOOKS OR THE ESTIMATE FILE.

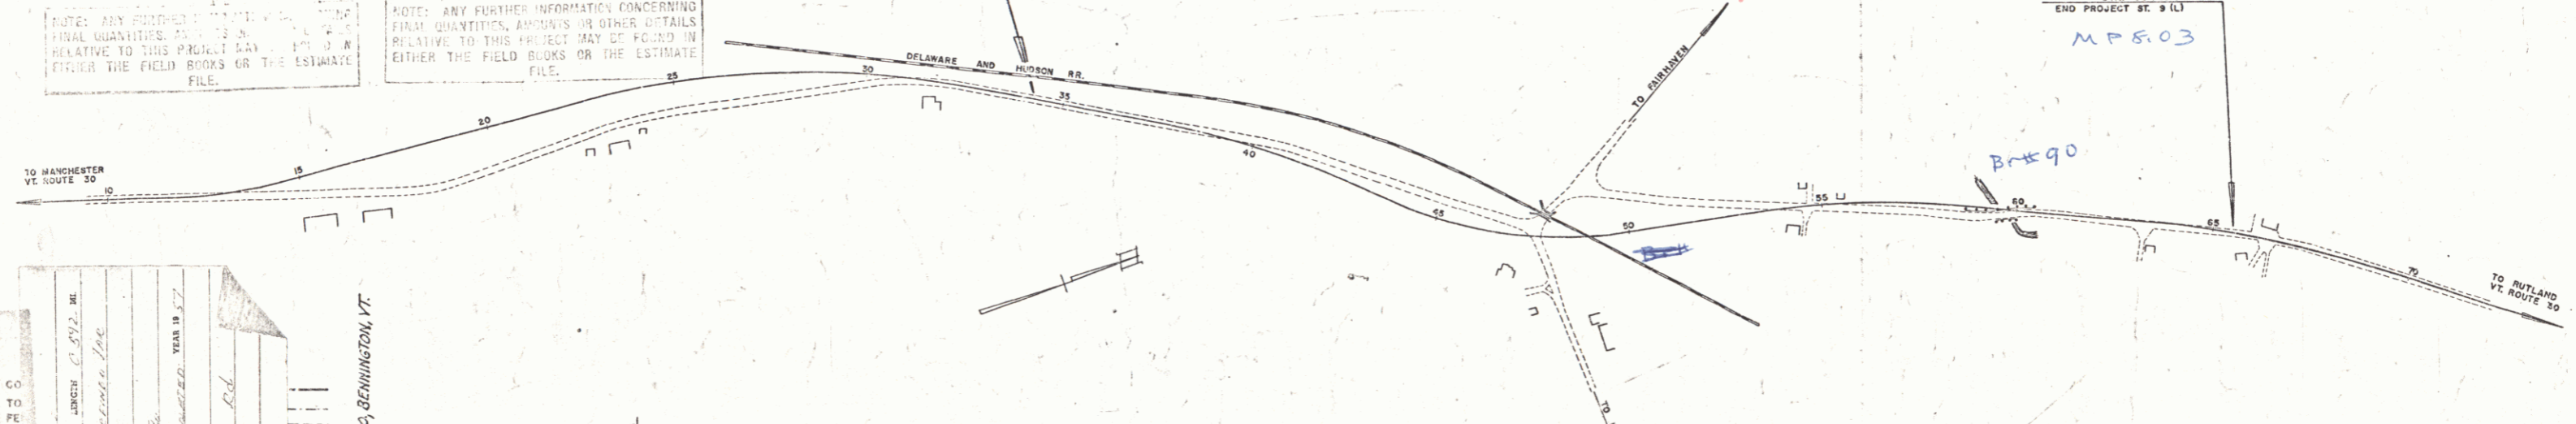

RIGHT-OF-WAY DIVISION
TOWN FILE
PERPETUAL
TOWNSHIP OF H-30
(To Be Returned To R.O.W. Division)

CO TO	LEWIS C. DRAY, JR.
PE	DRAY, JR. CIVIL & MECHANICAL INC.
ST	100 N. STATE ST., POULTNEY, VT.
UN	
GR	
RE	
GE	
TO	
BU	
SP	
DR	
TS	
AS	
IN	
TE	
TR	
HE	

CONTR. - W.H. DRATH	CONSTR. COMPLETED - JULY 11, 1957
RECORD PLANS - W.H. DRATH	
CONSTR. COMPLETED - JULY 11, 1957	

SCALE	1" = 200'
TYPICAL	1" = 2'
PLAN	1" = 50'
PROFILE HORIZONTAL	1" = 60'
VERTICAL	1" = 10'
CROSS-SECTIONS	1" = 4'

THESE PLANS ARE SUBJECT TO SUCH REVISIONS AS MAY BE REQUIRED BY THE BUREAU OF PUBLIC ROADS OR THE COMMISSIONER OF HIGHWAYS.

CONSTRUCTION IS TO BE CARRIED ON IN ACCORDANCE WITH THE PLANS AND THE STANDARD SPECIFICATIONS FOR HIGHWAY AND BRIDGE CONSTRUCTION OF JANUARY 1956, SUBMITTED TO THE BUREAU OF PUBLIC ROADS FOR APPROVAL ON APRIL 9, 1956, INCLUDING ALL SUBSEQUENT APPROVED REVISIONS AND SUCH REVISED SPECIFICATIONS AND SPECIAL PROVISIONS AS ARE SUBMITTED WITH THE PLANS.

DEPARTMENT OF COMMERCE
BUREAU OF PUBLIC ROADS

Pin # 00R375

PROJECT - ST. NO. 9(L)

SHEET 1 OF 43 SHEETS

APPROVED	APPROVED	APPROVED	APPROVED	APPROVED
DATE	DATE	DATE	DATE	DATE