



PLAN  
 DATE 11/24/56  
 DRAWN BY JOC  
 CHECKED BY JOC  
 PROJECT NO. 36  
 SHEET NO. 7

SCALE  
 HORIZONTAL 1" = 40'  
 VERTICAL 1" = 10'  
 NOTE BOOK  
 REFERENCE TO SHEET NO. 7

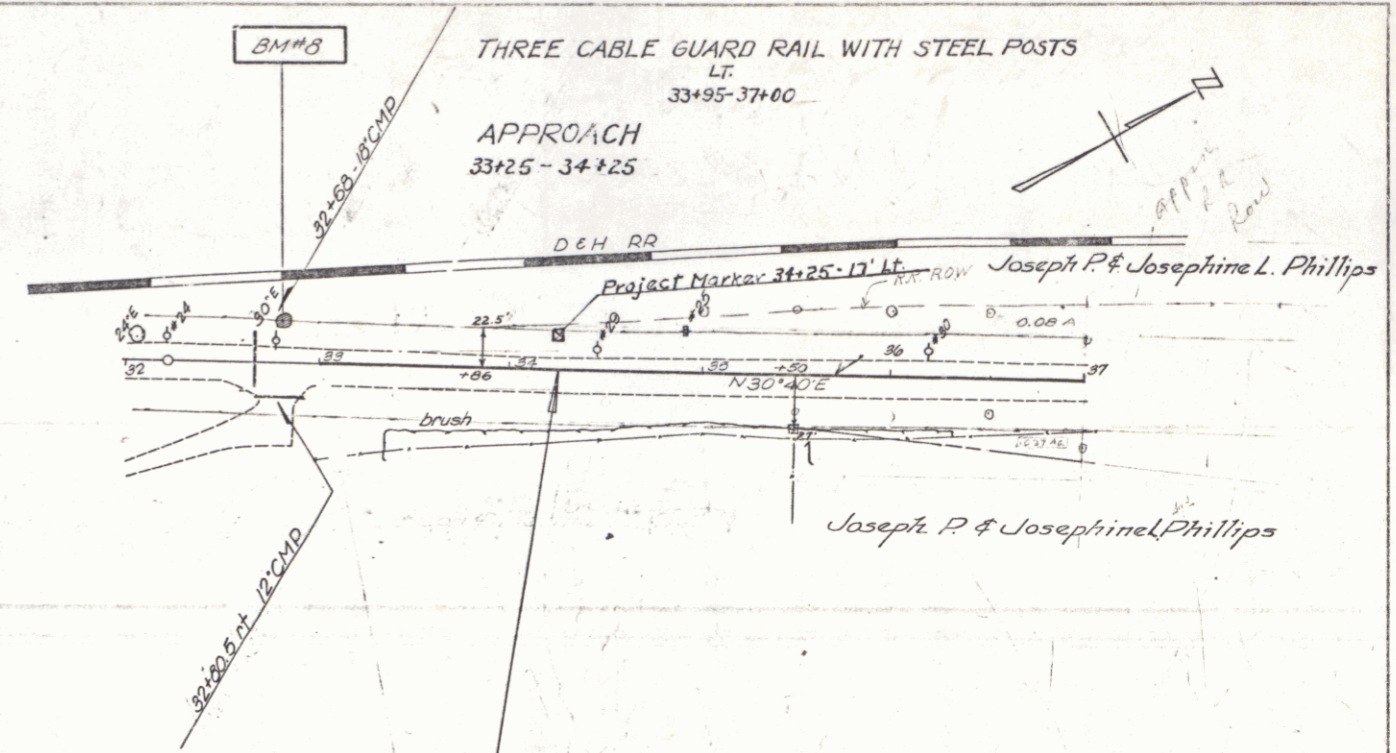

PARCEL	INSTRUMENT	DATE	GRANTOR	GRANTEE	RECORDED	BOOK	PAGE	DATE	REMARKS
A.B.C.D.E	Contd.	4-25-56	Joseph P. & Josephine Phillips	St. of Va.	Poultney	51	238-241	5-16-56	See also sheet 8 & 9

STA 34+25.0  
 BEGIN PROJECT  
 5'-9" (L)

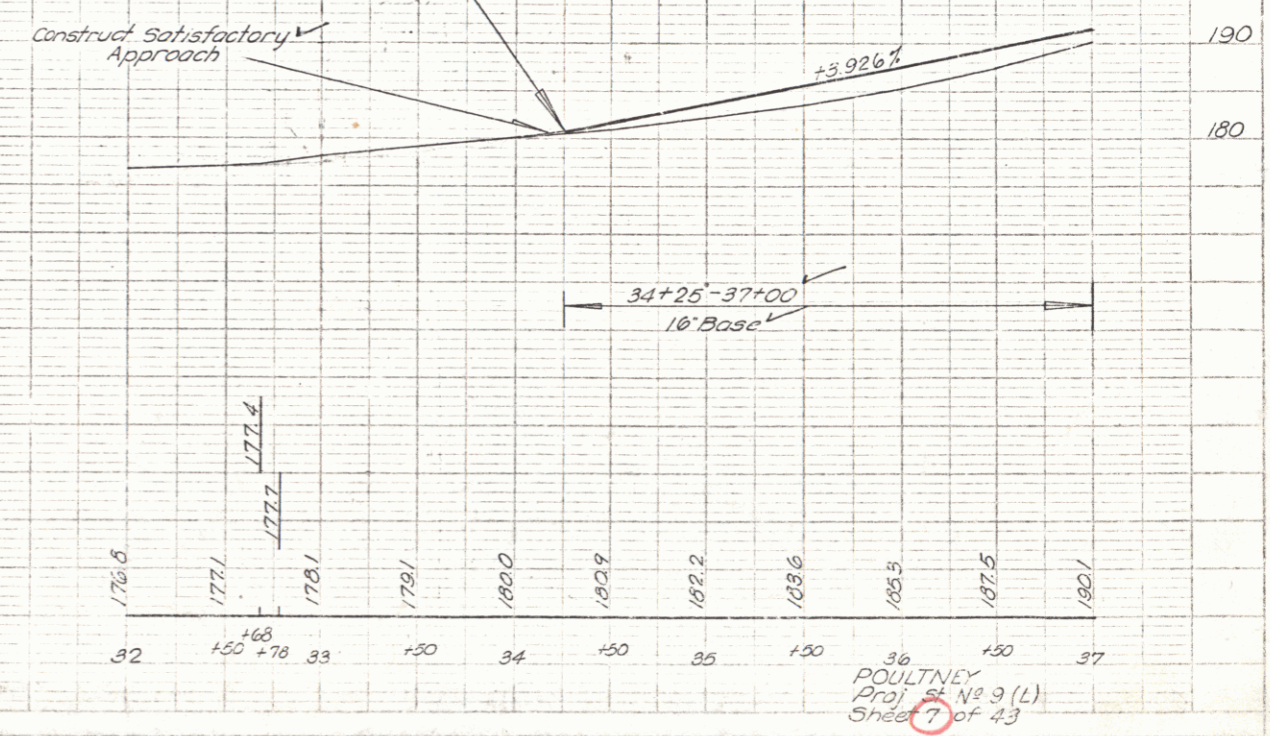

BM # 8 SIT 30° Elm 21' Lt 32+01 elev 177.46

36  
 POULTNEY  
 Proj. No. 3 (L)  
 Sheet 7 of 43