


PARCEL	INSTRUMENT	DATE	GRANTOR	GRANTEE	RECORDED	BOOK	PAGE	DATE	REMARKS
2 A, B	W.D.O.E.	5-25-56	Chauncey W. & Elizabeth E. Payne	St. of Vt.	Poultney	51	254	6-4-56	
3 A, B, C	W.D.O.E.	6-9-56	Helen G. Sherman	St. of Vt.	Poultney	51	288-289	7-12-56	

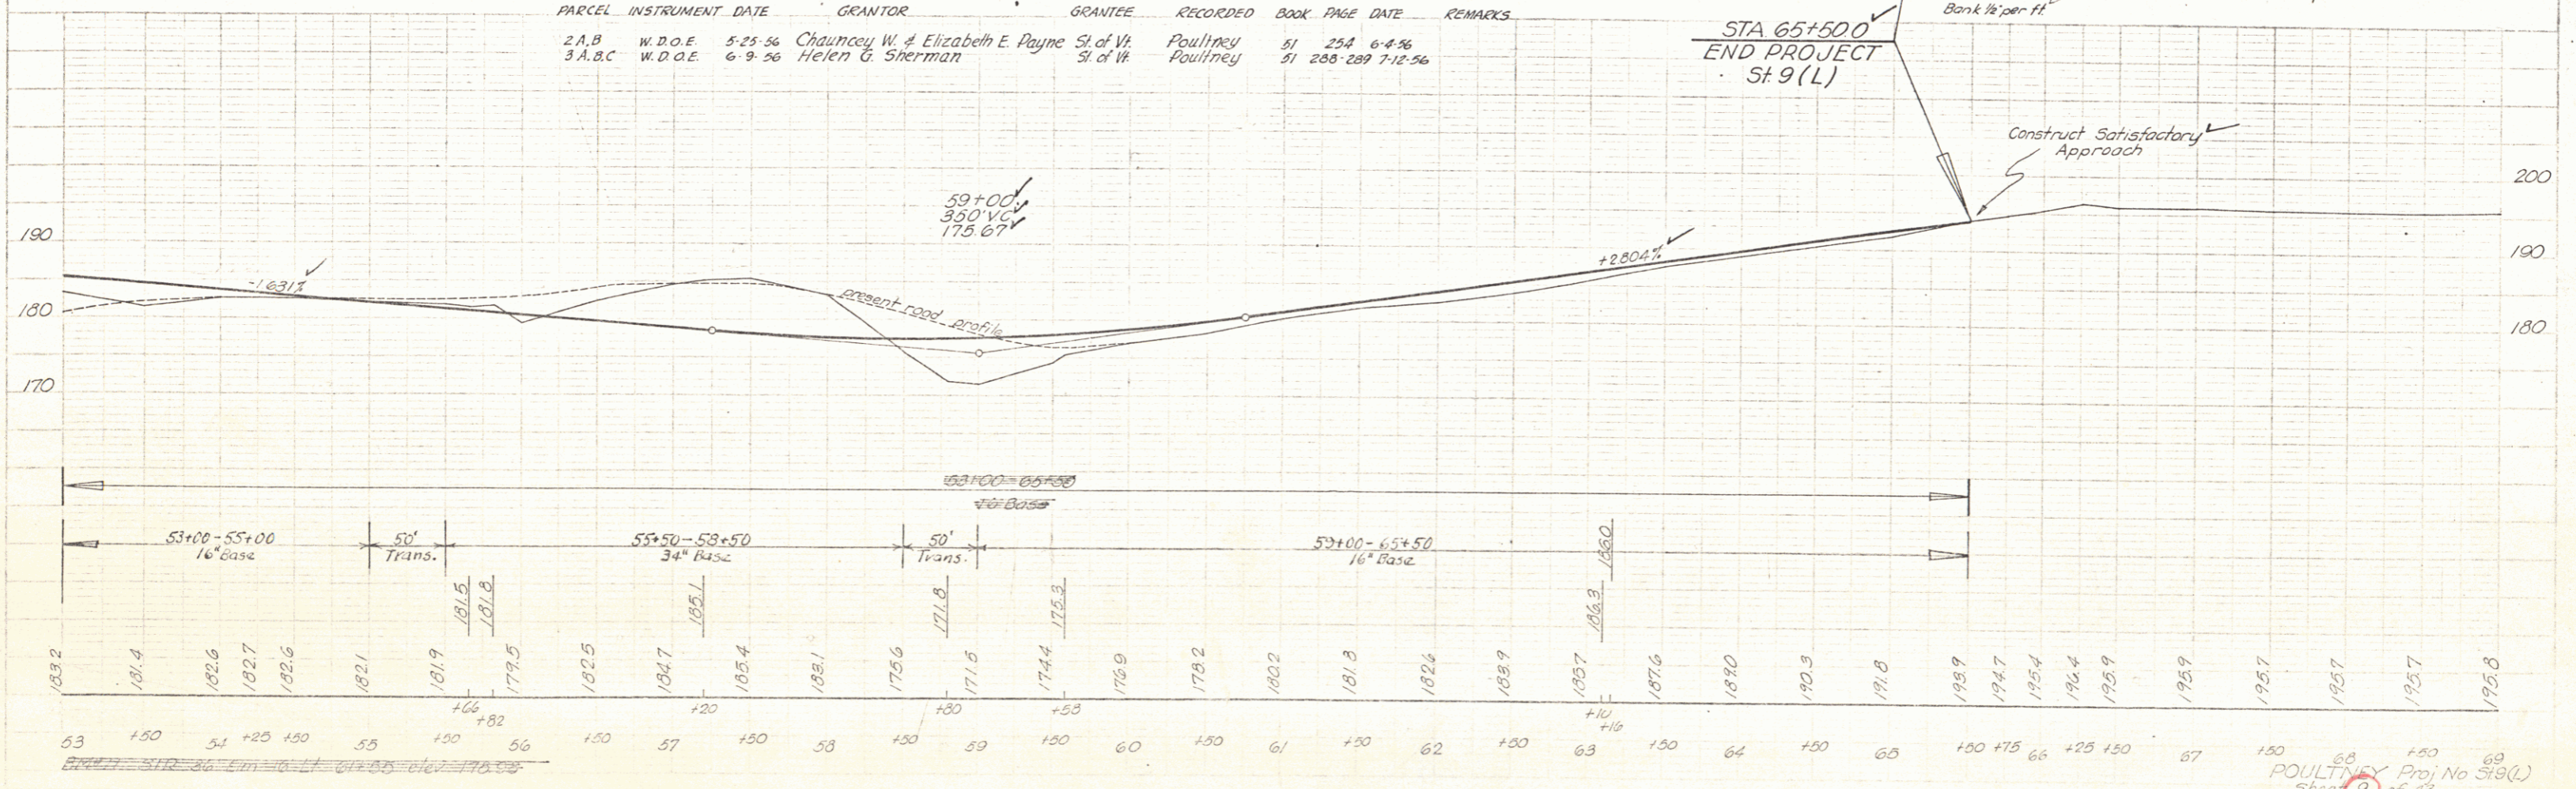

POULTNEY Proj No 319(L)
 Sheet 9 of 43
 JUN 12 1980
 4