



PLAN
 DATE
 SHEET NO.
 OF SHEETS
 PROJECT NO.
 DRAWN BY
 CHECKED BY

PROFILE
 DATE
 SHEET NO.
 OF SHEETS
 PROJECT NO.
 DRAWN BY
 CHECKED BY

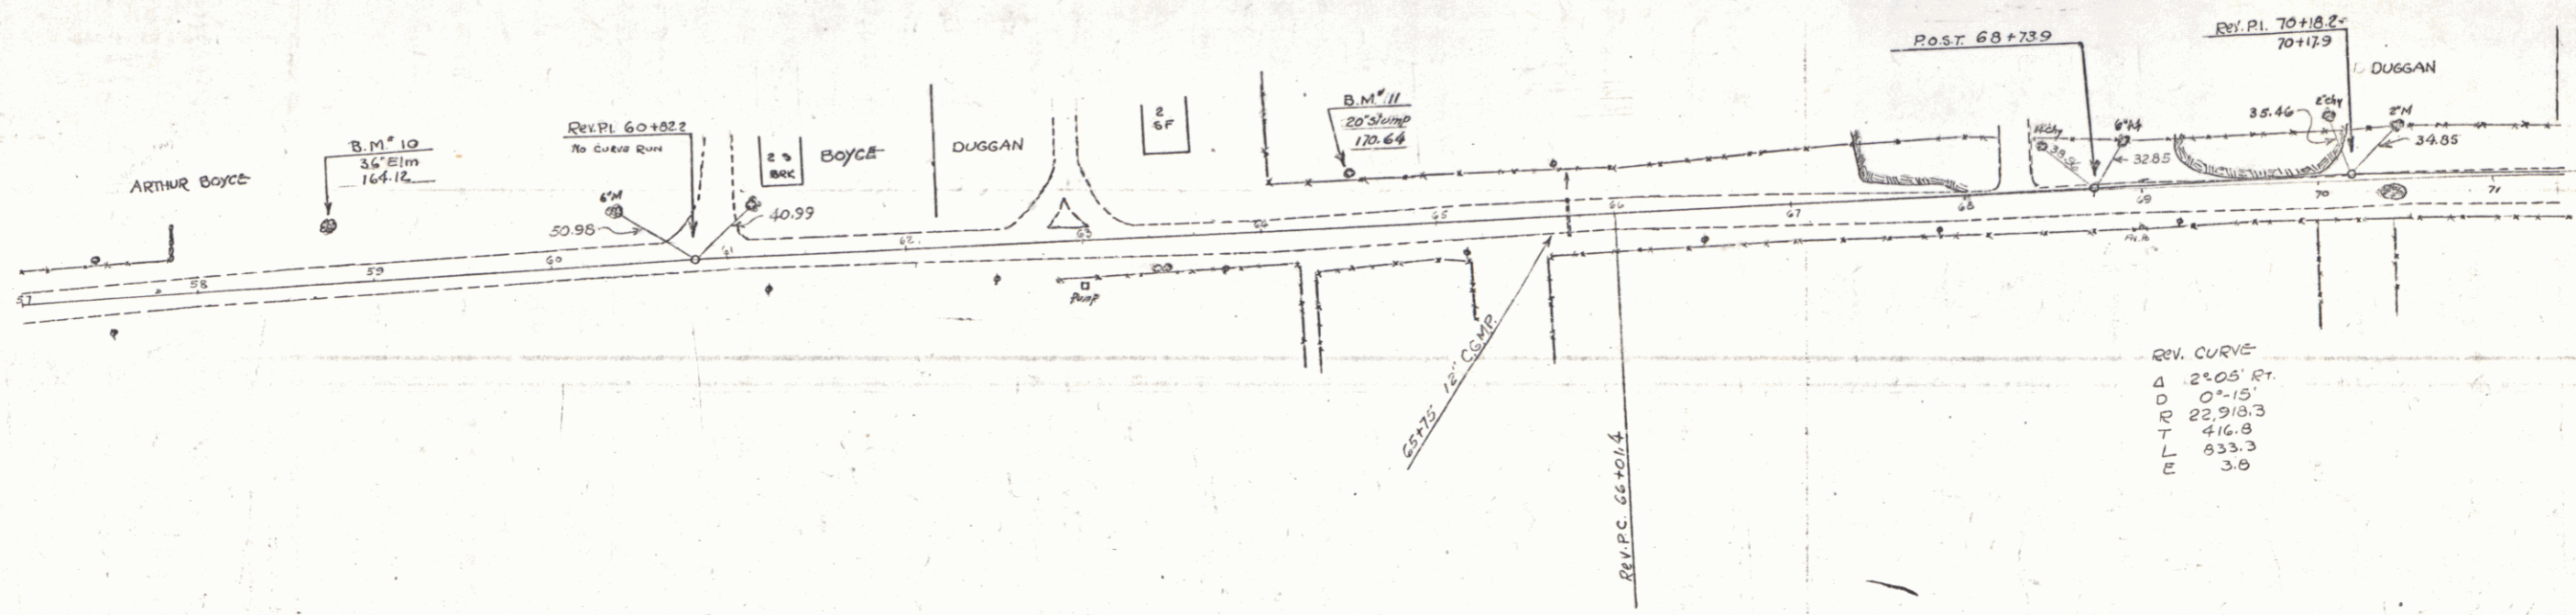

REV. CURVE
 Δ 2°05' Rt.
 P 0°15'
 T 22.918.3
 L 416.8
 RL 833.3
 S.B.

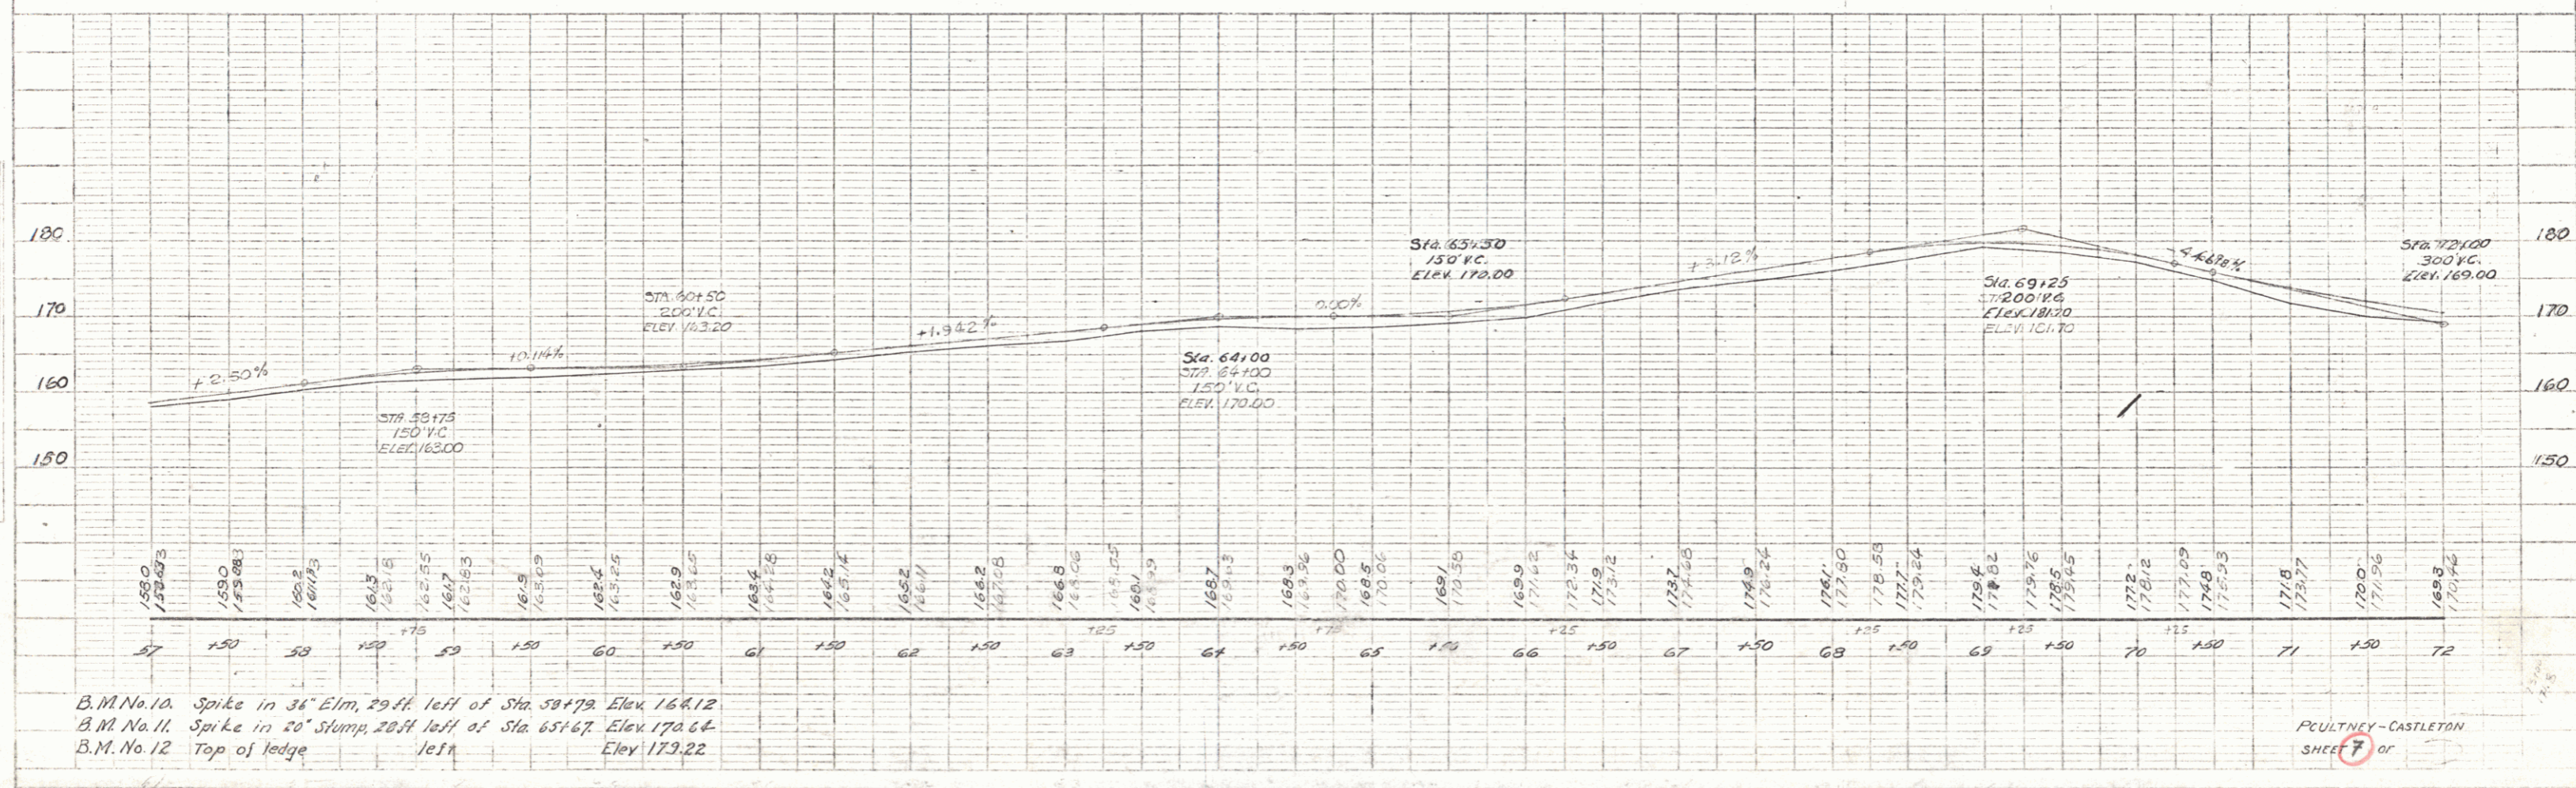

B.M. No. 10. Spike in 36 Elm, 29th left of Sta. 58+79. Elev. 164.12
 B.M. No. 11. Spike in 20 Stump, 20th left of Sta. 65+67. Elev. 170.64
 B.M. No. 12. Top of ledge left of Sta. 64+00. Elev. 173.22

PCULTNEY-CASTLETON
 SHEET 7 OF 7

PLATE 1 - REAL PROFILE S.P.R. & C. THRUOUT
 REPORT 1-10-1914