



PLAN	DATE	BY
REVISION		
NO.	DESCRIPTION	DATE
1	AS SHOWN	

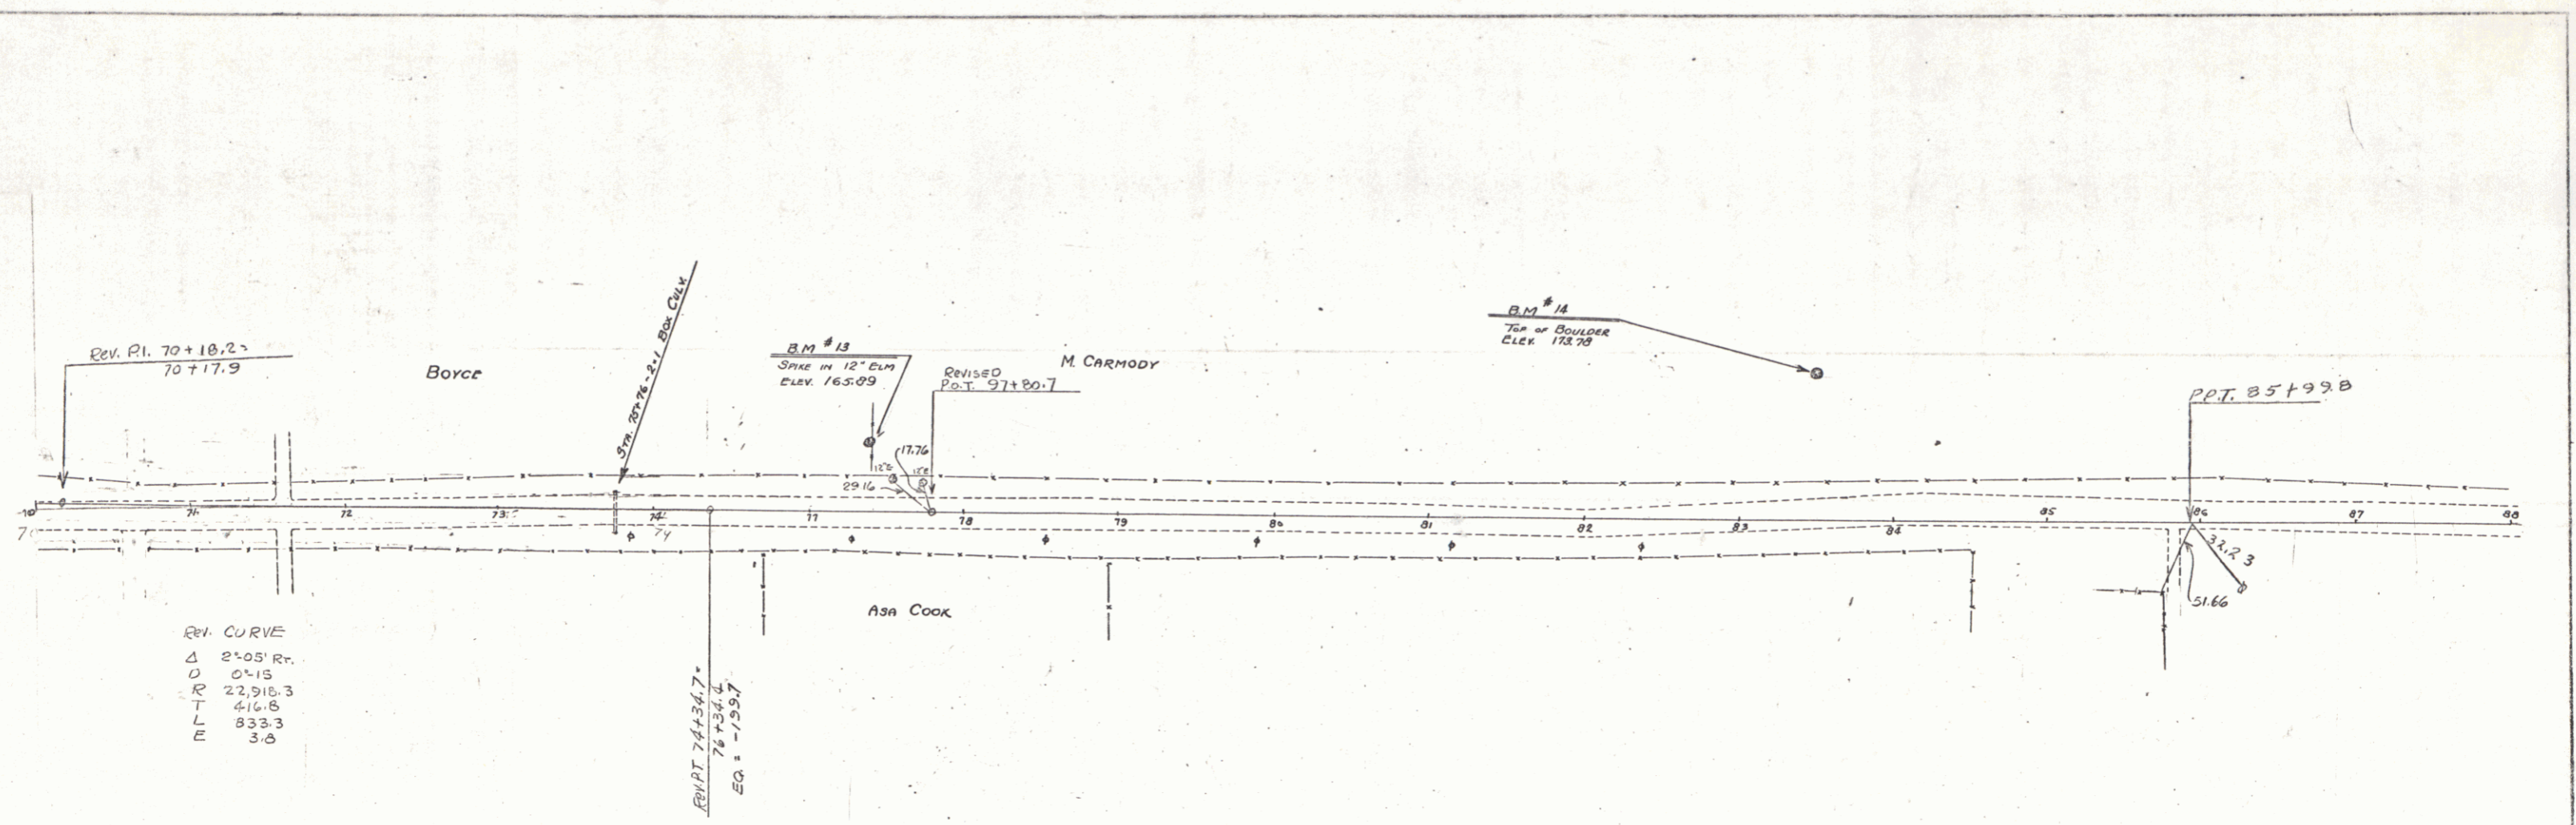

REV. CURVE

Δ	2°05' R.
D	0+15
R	22,918.3
L	416.8
E	833.3
S	3.8

PLAN	DATE	BY
REVISION		
NO.	DESCRIPTION	DATE
1	AS SHOWN	

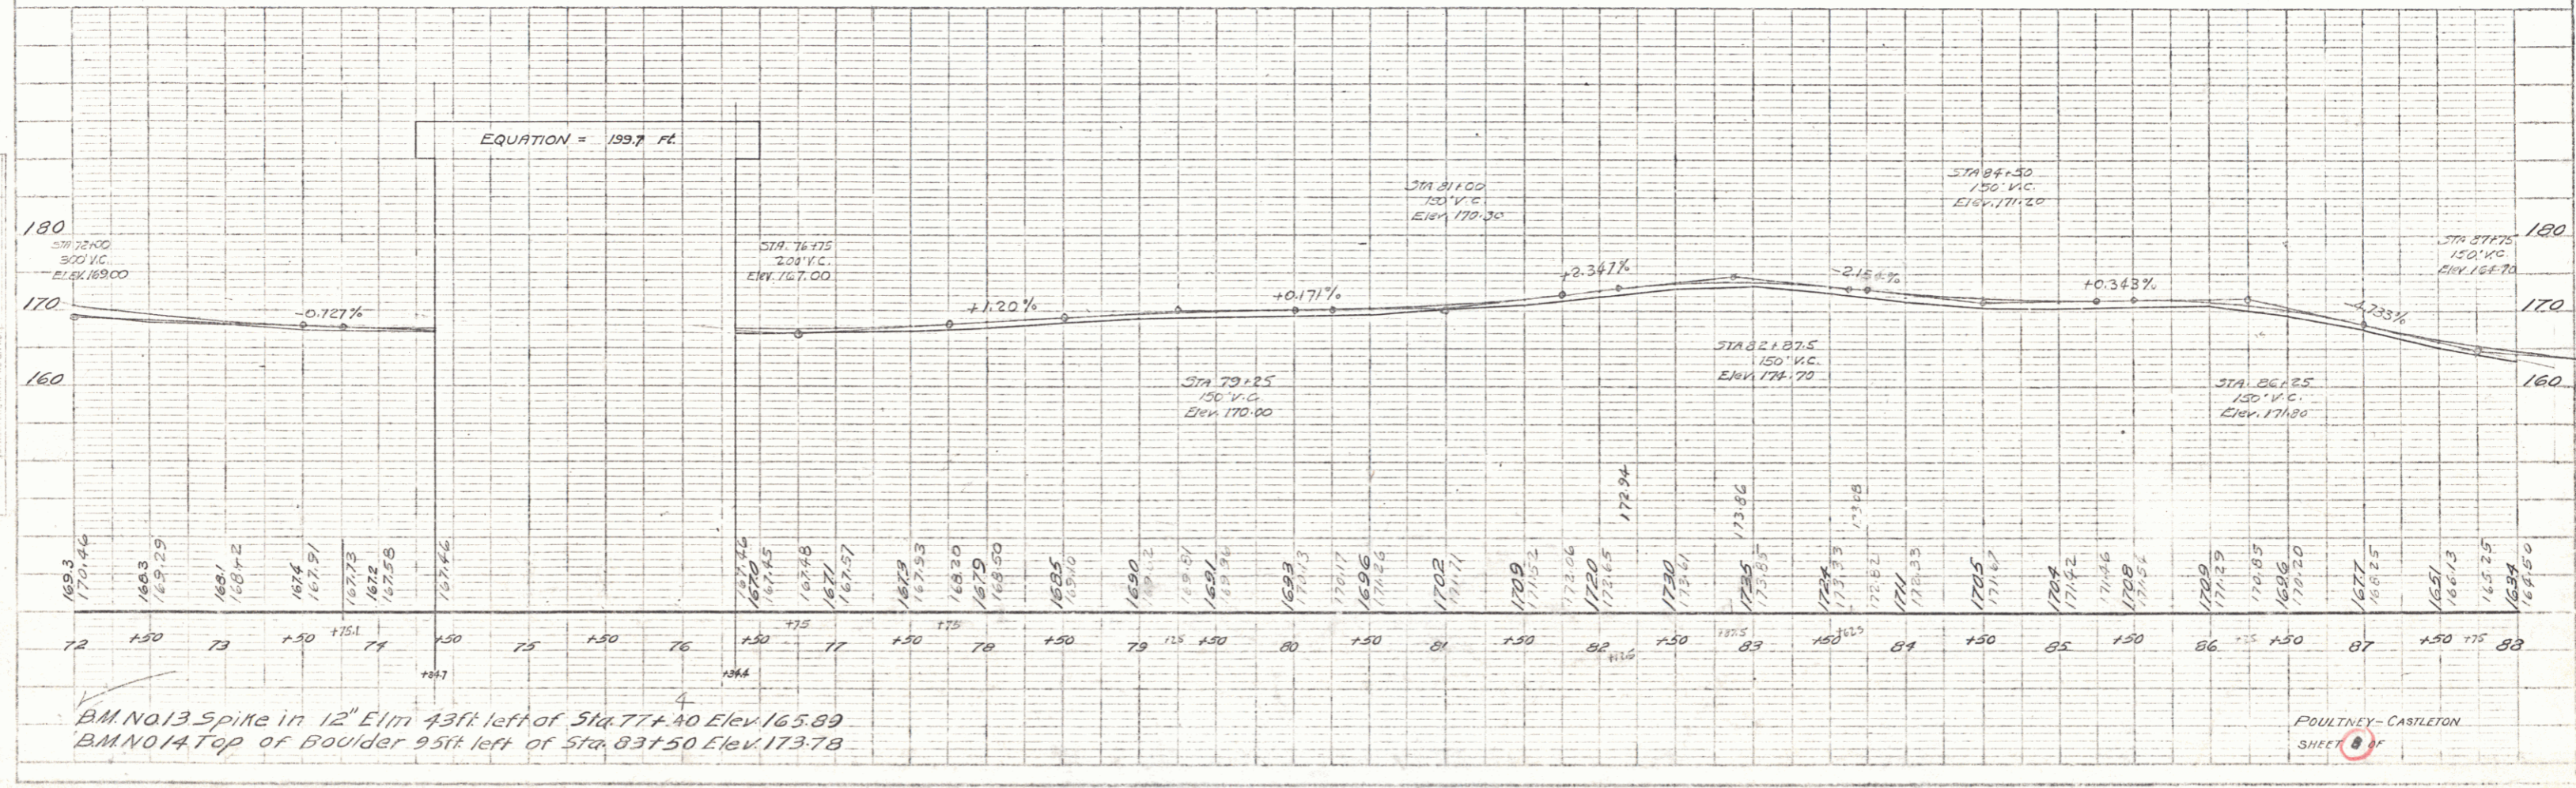

BM NO.13 Spike in 12" Elm 43ft left of Sta. 77+40 Elev. 165.89
 BM NO.14 Top of Boulder 95ft left of Sta. 83+50 Elev. 173.78

POULTNEY-CASTLETON
 SHEET 8 OF 8