



PLAN
 DATE
 BY
 CHECKED BY
 SCALE
 SHEET NO. OF TOTAL SHEETS

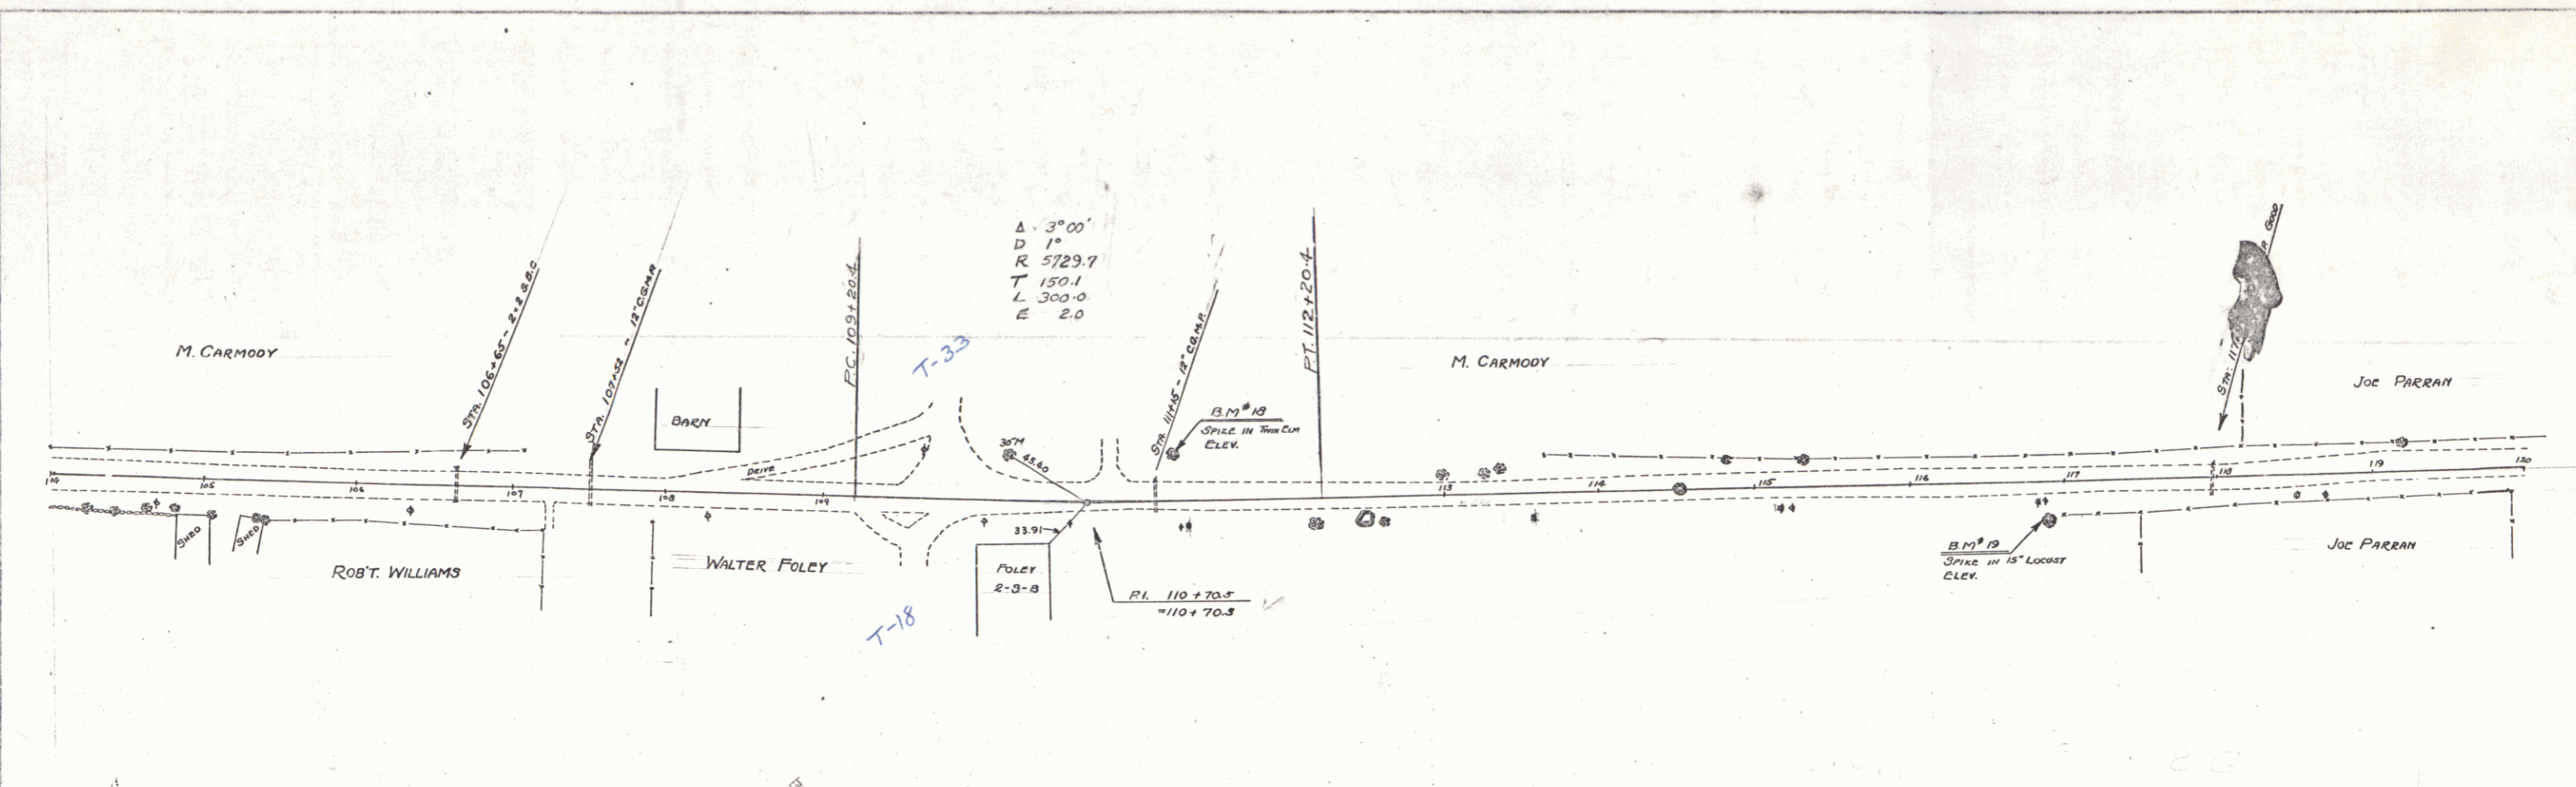

PROFILE
 DATE
 BY
 CHECKED BY
 SCALE
 SHEET NO. OF TOTAL SHEETS

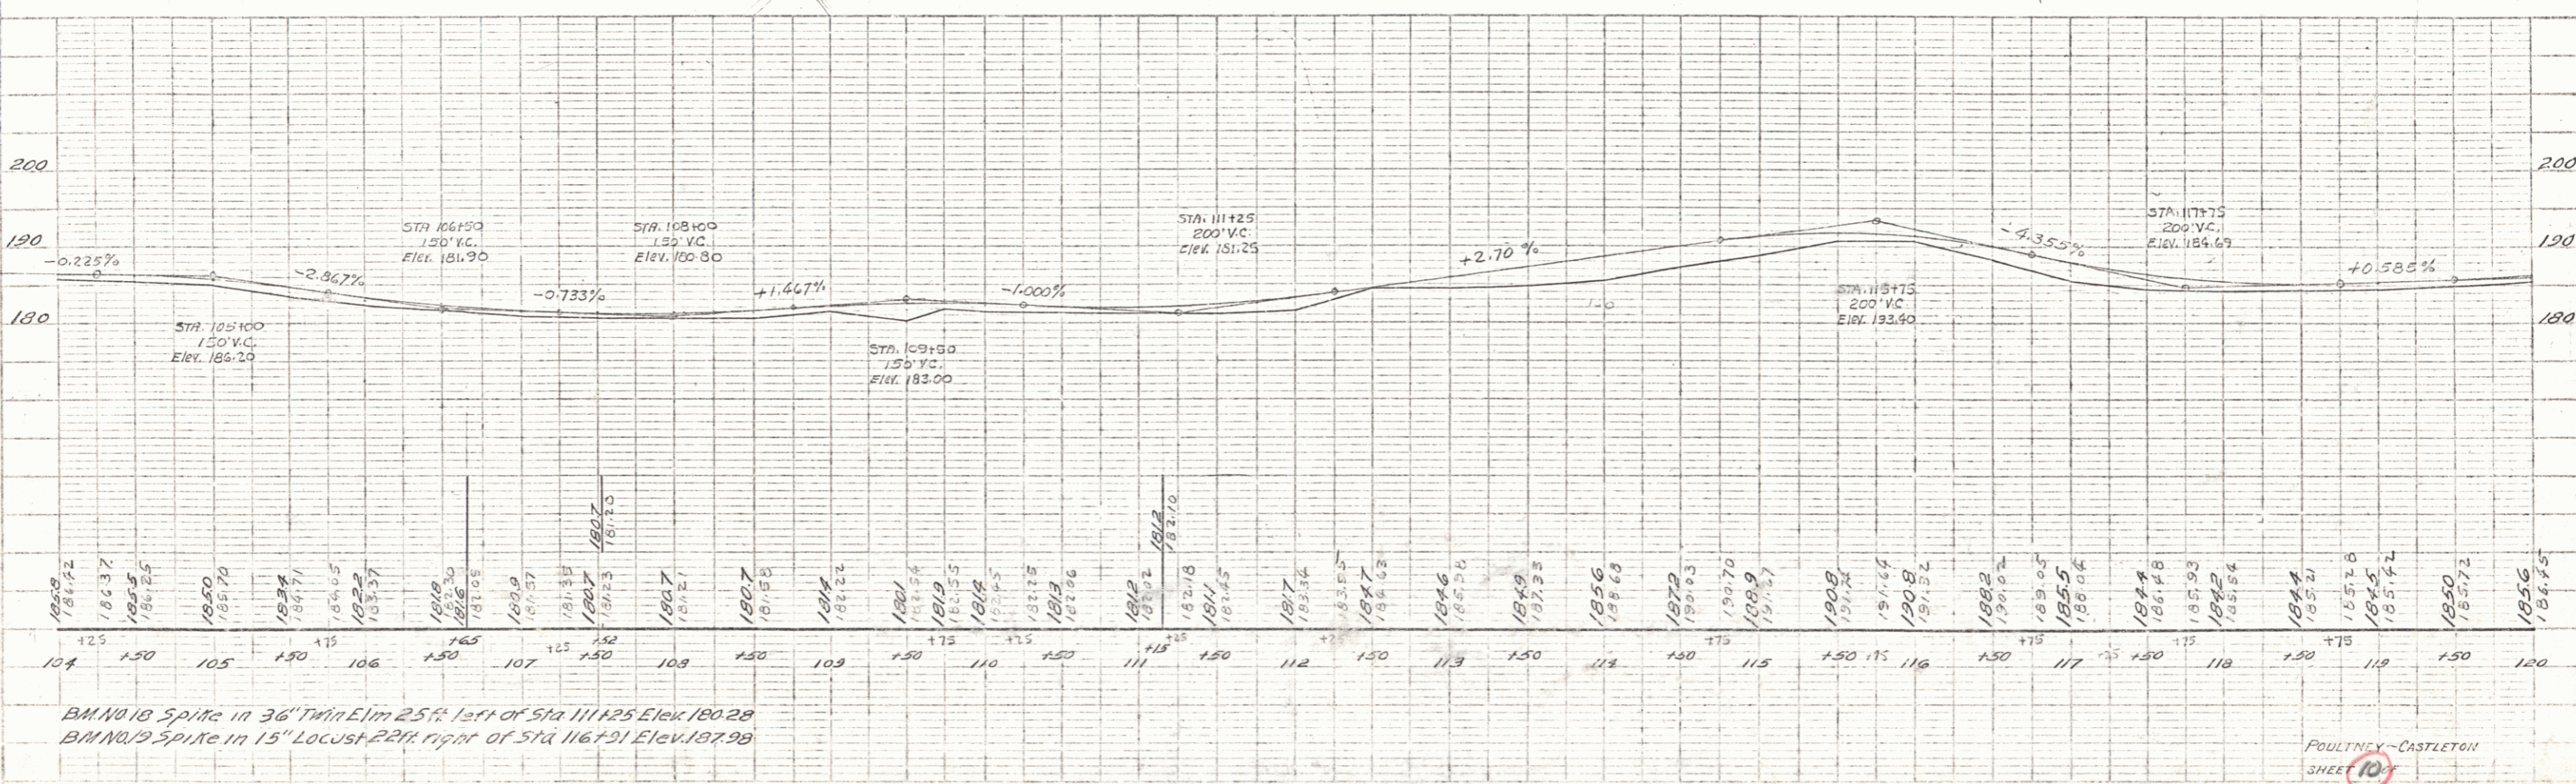

B.M. #10 Spike in 36" Trunk Elm 25' left of Sta 111+25 Elev. 180.28
 B.M. #12 Spike in 15" Locust 22' right of Sta 116+21 Elev. 187.99

POULTNEY - CASTLETON
 SHEET 10